


I HEREBY CERTIFY THAT THE PRINTED MATERIAL ON THIS MAP CORRECTLY SHOWS THE MINE AND PROPERTY OF INLAND STEEL COAL COMPANY LANCASTERSHIP NO. 25 MINE AS OF AUGUST 1, 1965. THIS MAP SHOWS THE FINAL WORKINGS OF THE MINE PRIOR TO SEAMING.

I FURTHER CERTIFY THAT THIS MAP WAS PREPARED UNDER MY JURISDICTION, AND THAT THE SURVEYS ON WHICH THE MAP IS BASED WERE MADE BY ME OR UNDER MY CLOSE PERSONAL SUPERVISION, AND THE MAP IS CORRECT TO THE BEST OF MY KNOWLEDGE AND BELIEF.

David N. Hakes

DAVID N. HAKES, P.E.
REGISTERED PROFESSIONAL ENGINEER OF
THE COMMONWEALTH OF PENNSYLVANIA
NO. PE-03435-E

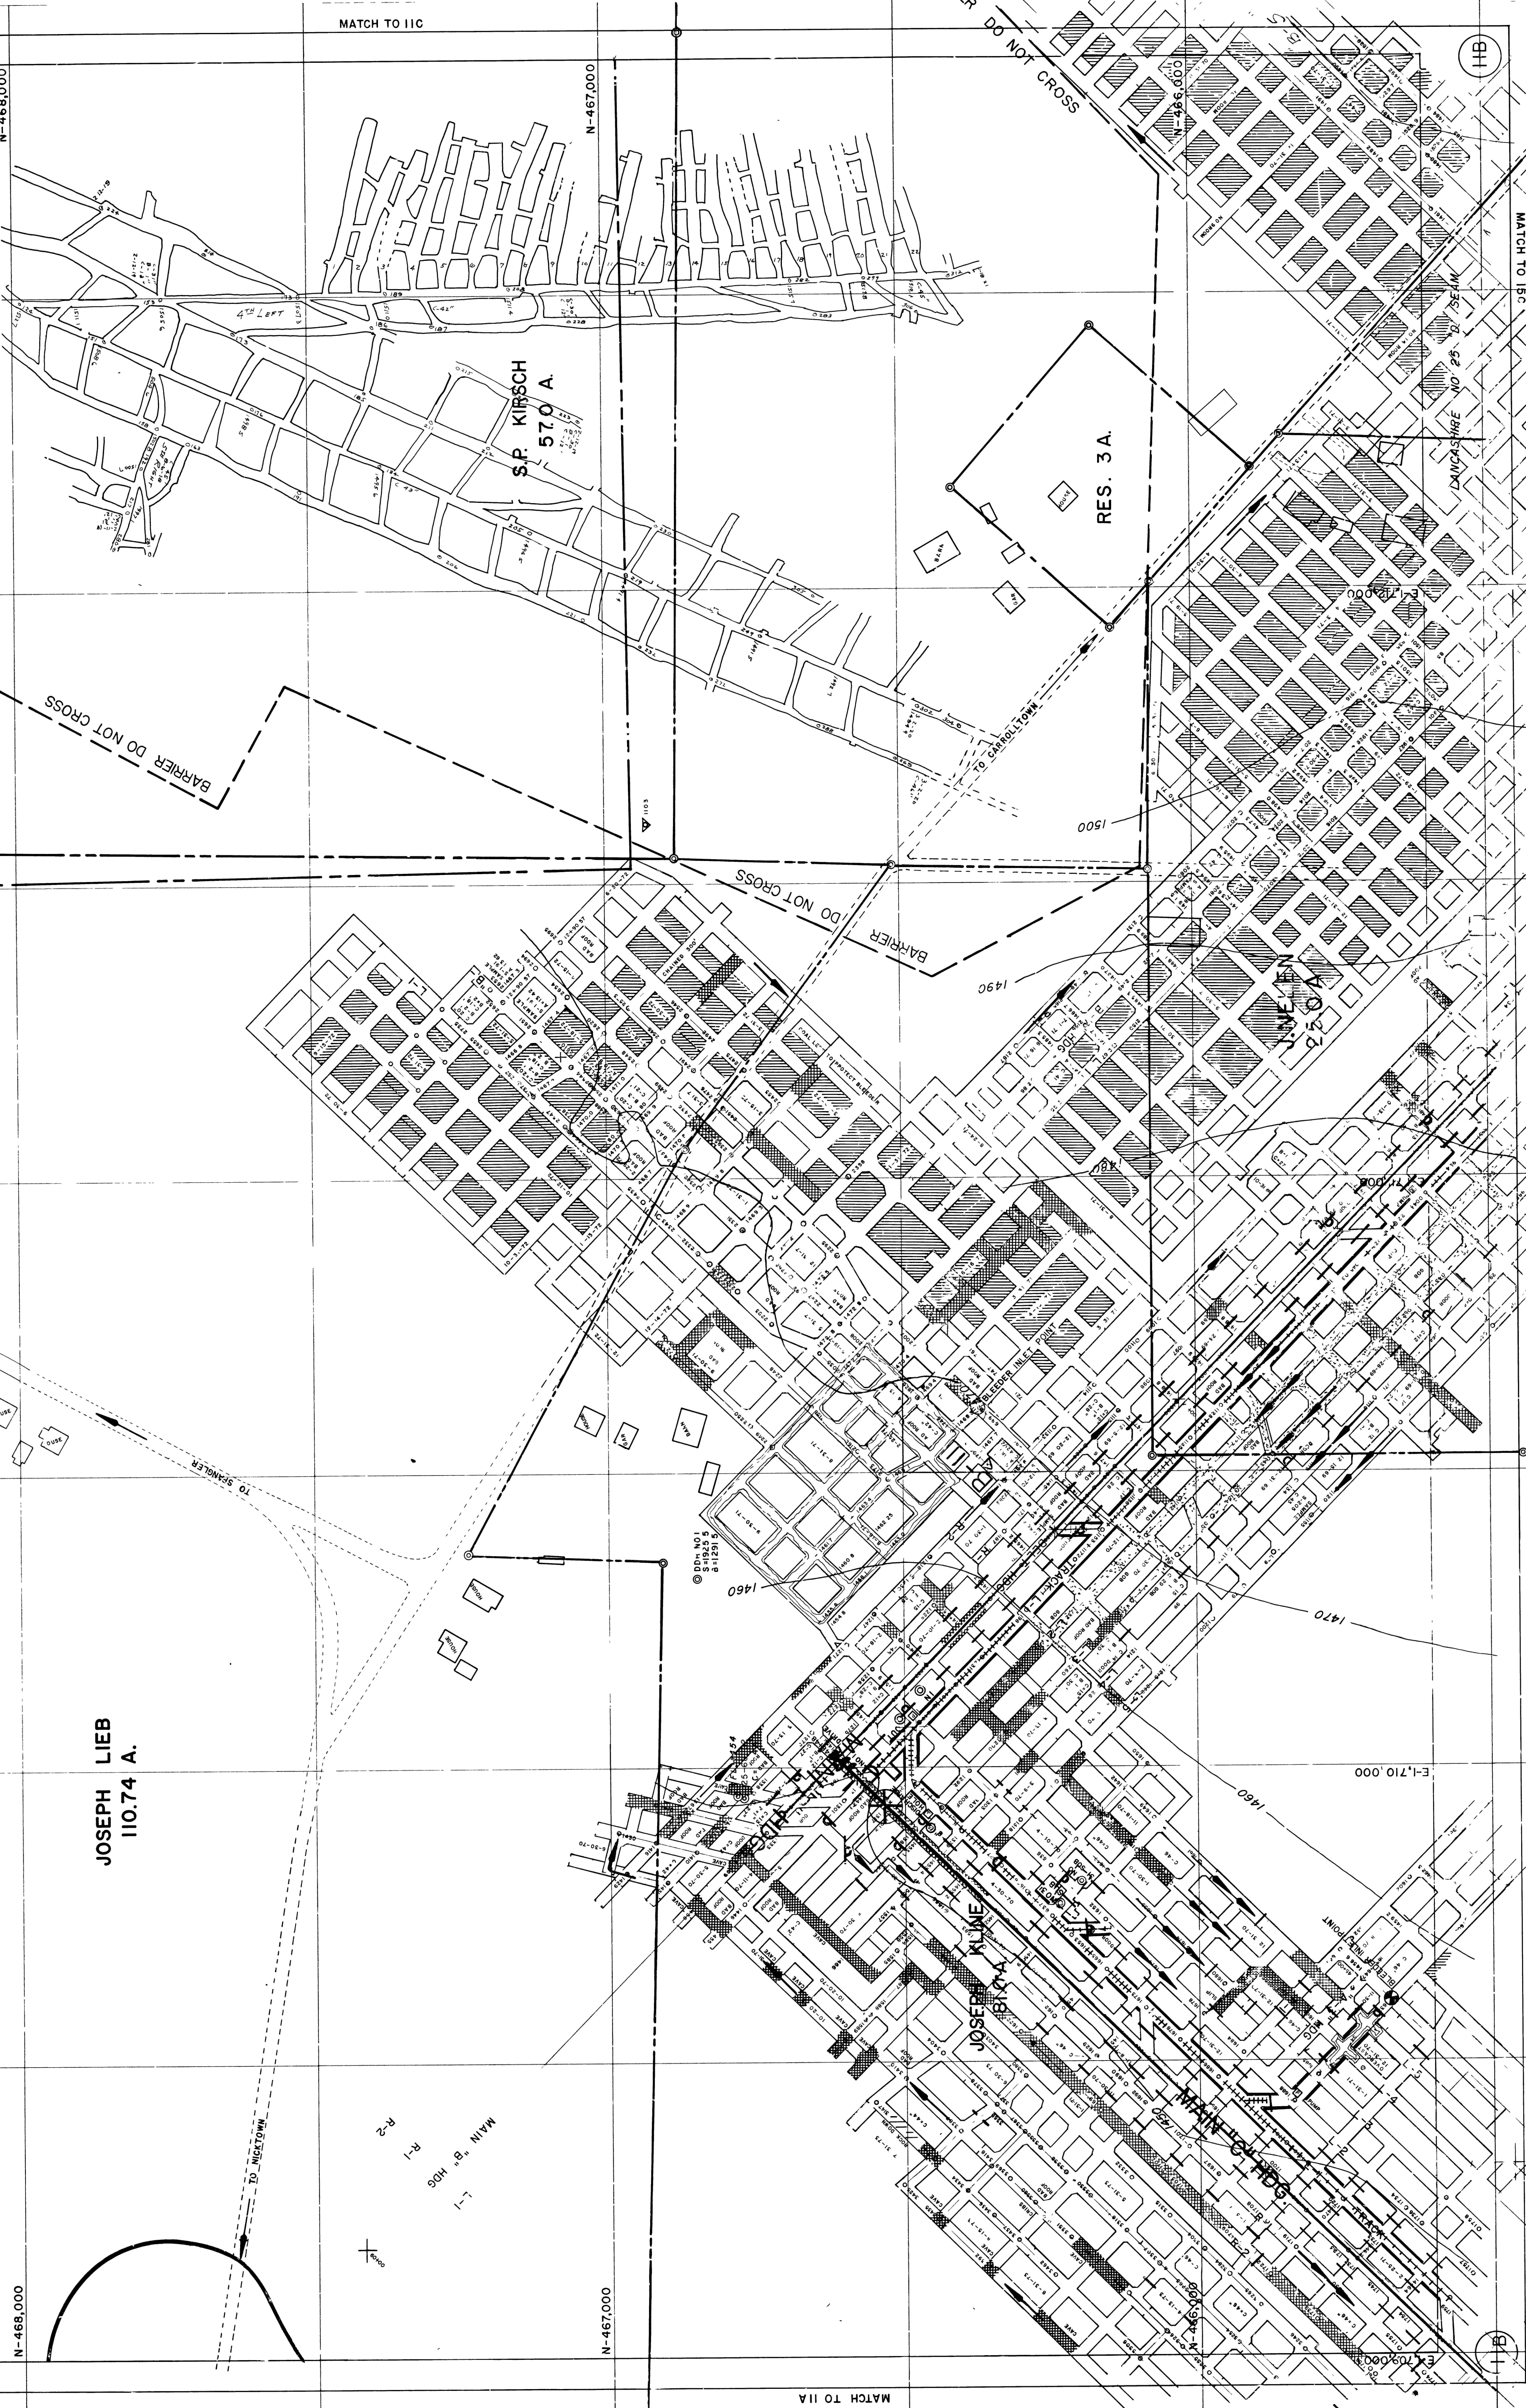

MATCH TO 11C

MATCH TO 7A

MATCH TO 11A

MATCH TO 15C

MATCH TO 15B