

MATCH TO 15C

MATCH TO 15B

MATCH TO 21A


MATCH TO 28B

MATCH TO 28A

21B

21B

LANCASHIRE NO 25 'D' SEAM

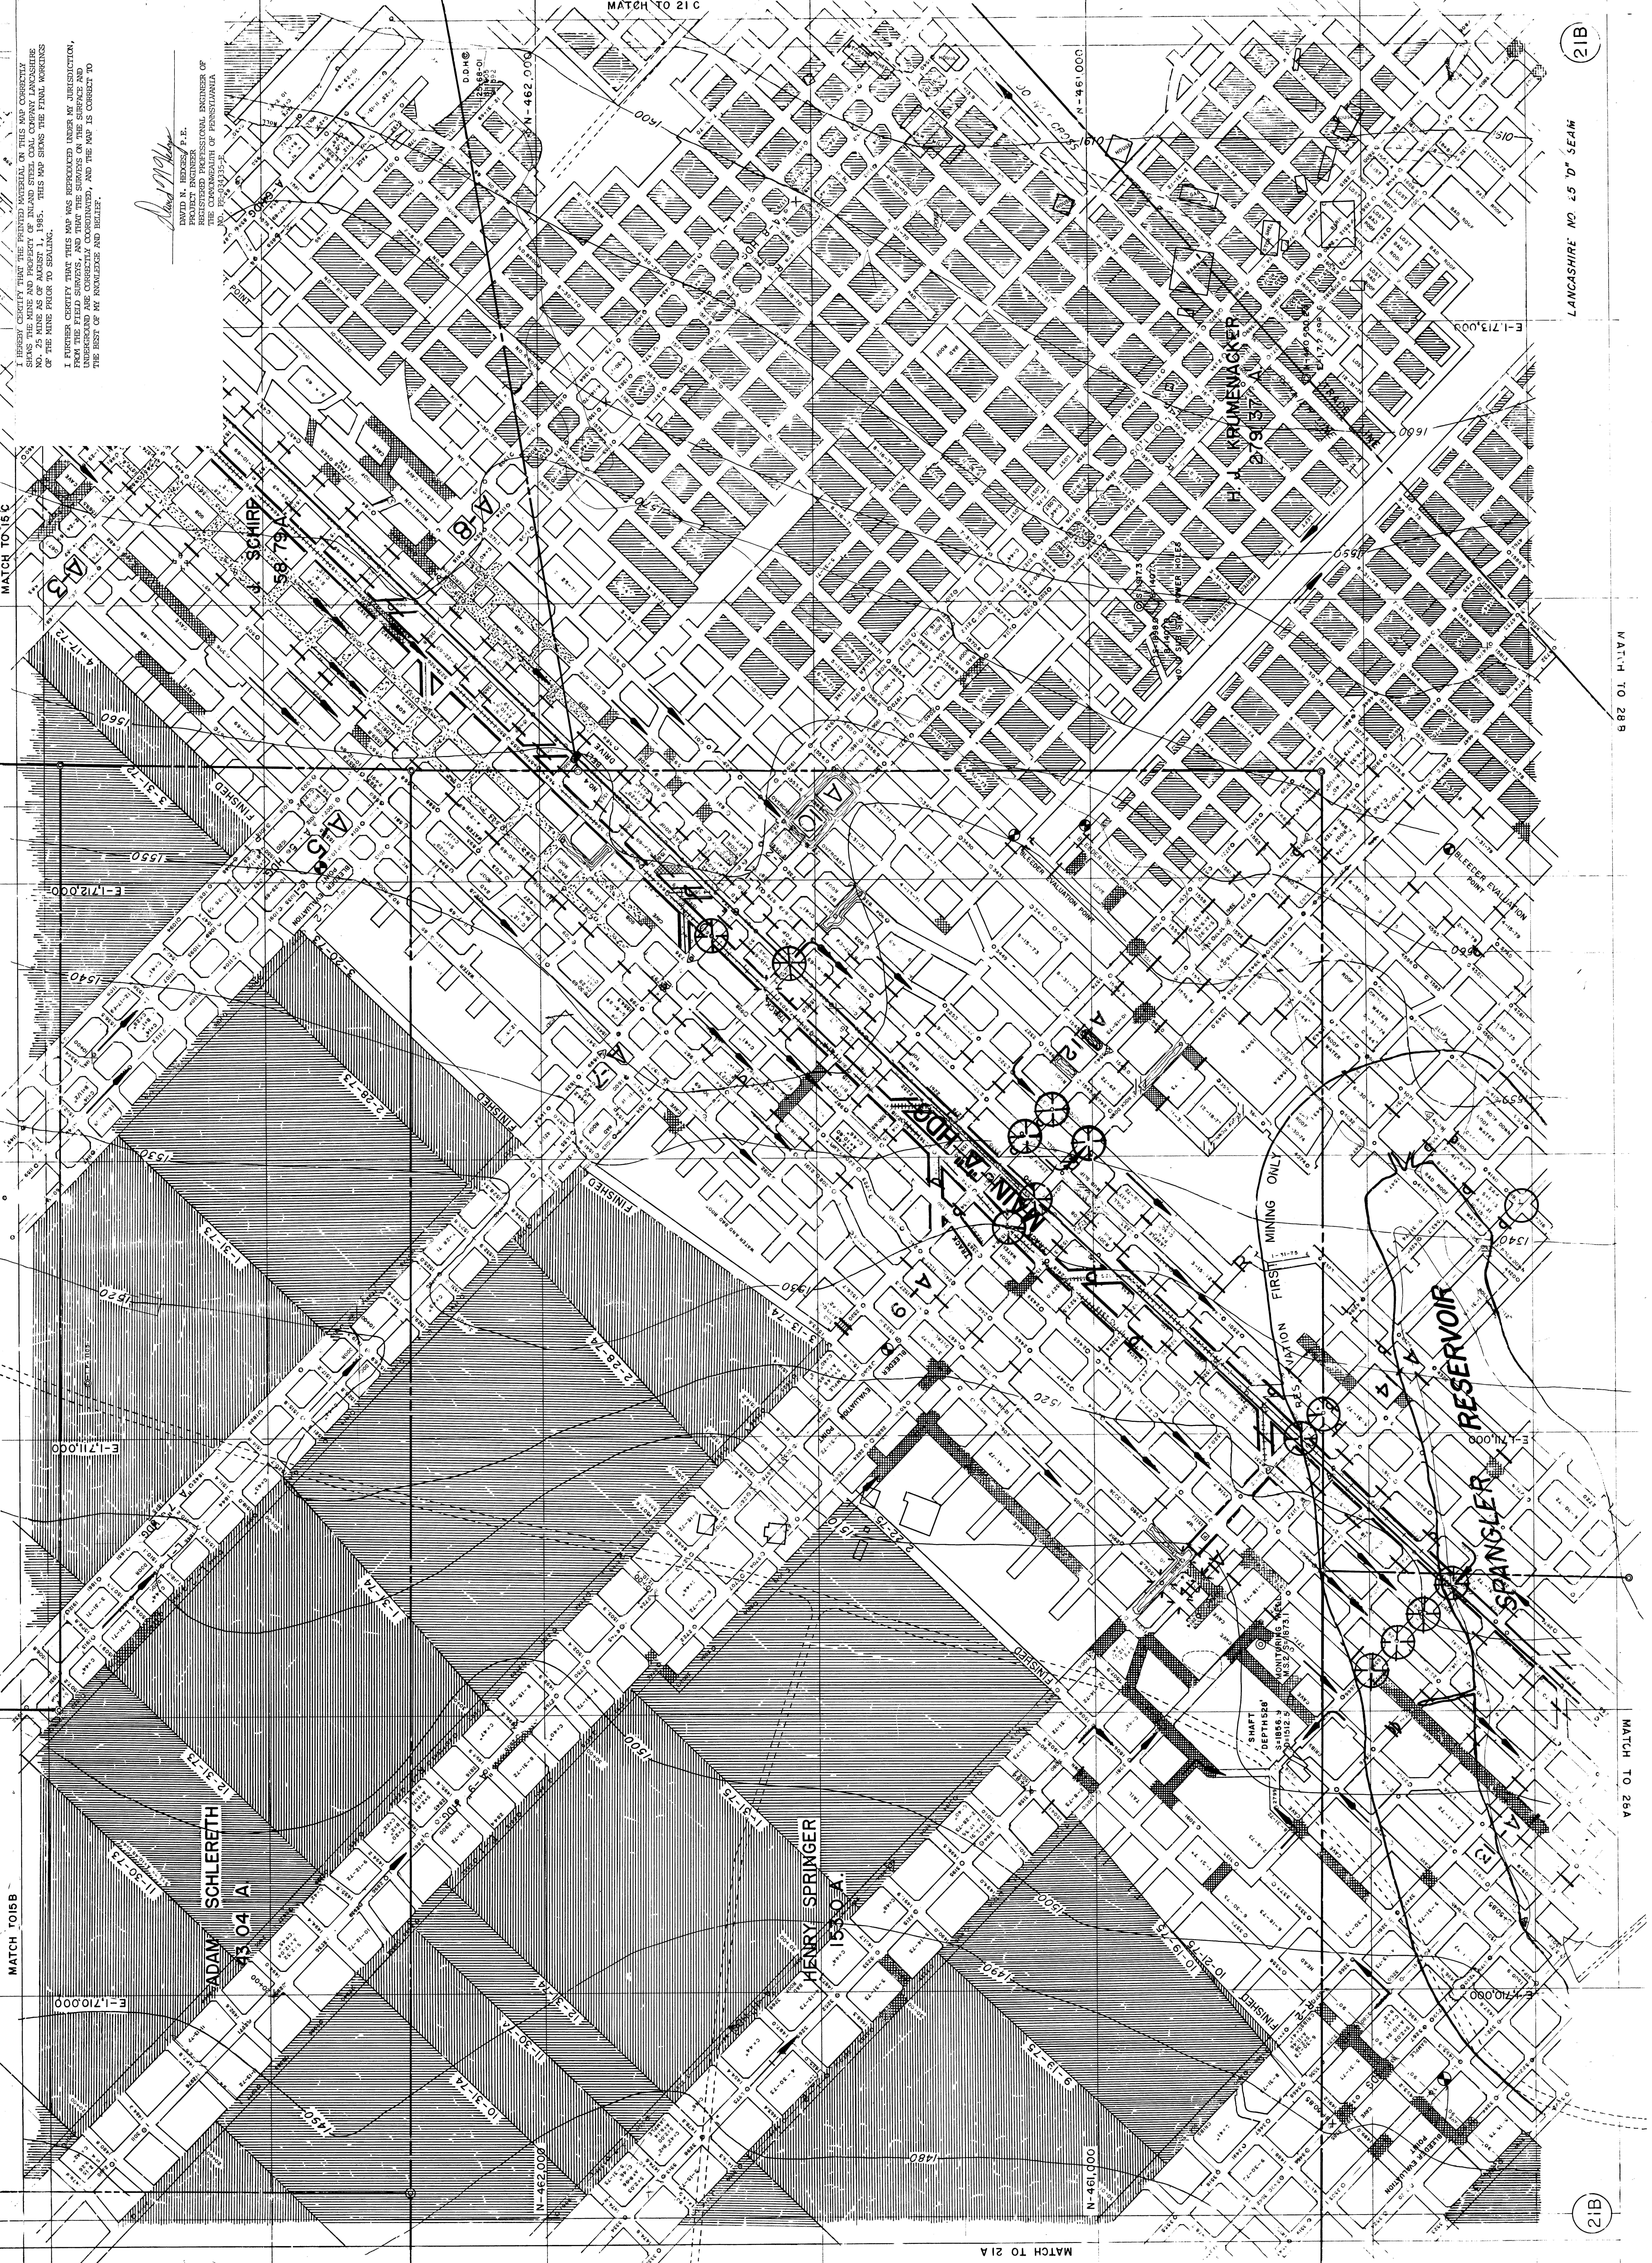

I HEREBY CERTIFY THAT THE PRINTED MATERIAL ON THIS MAP CORRECTLY
SHOWS THE MINE AND PROPERTY OF INLAND STEEL COAL COMPANY LANCASHIRE
OF THE MINE PRIOR TO SEALING.
I FURTHER CERTIFY THAT THIS MAP WAS REPRODUCED UNDER MY JURISDICTION,
AND THAT THE SURVEY ON THE SURFACE AND
UNDERGROUND ARE CORRECTLY COMPARED, AND THE MAP IS CORRECT TO
THE BEST OF MY KNOWLEDGE AND BELIEF.

DAVID N. BRIDGES, P.E.
REGISTERED PROFESSIONAL ENGINEER OF
THE COMMONWEALTH OF PENNSYLVANIA

ADAM SCHLERETH

HENRY SPRINGER

SPANGLER RESERVOIR

FINISHED

MINING ONLY

BLEEDER POINT

100 FEET