


I FURTHER CERTIFY THAT THIS MAP WAS REPRODUCED UNDER MY JURISDICTION, FROM THE FIELD SURVEYS, AND THAT THE SURVEYS ON THE SURFACE AND UNDERGROUND ARE CORRECTLY COORDINATED, AND THE MAP IS CORRECT TO THE BEST OF MY KNOWLEDGE AND BELIEF.

DAVID N. HEDGES, P.E.
PROJECT ENGINEER
REGISTERED PROFESSIONAL ENGINEER OF
THE COMMONWEALTH OF PENNSYLVANIA
NO. PE-034335-E



C