


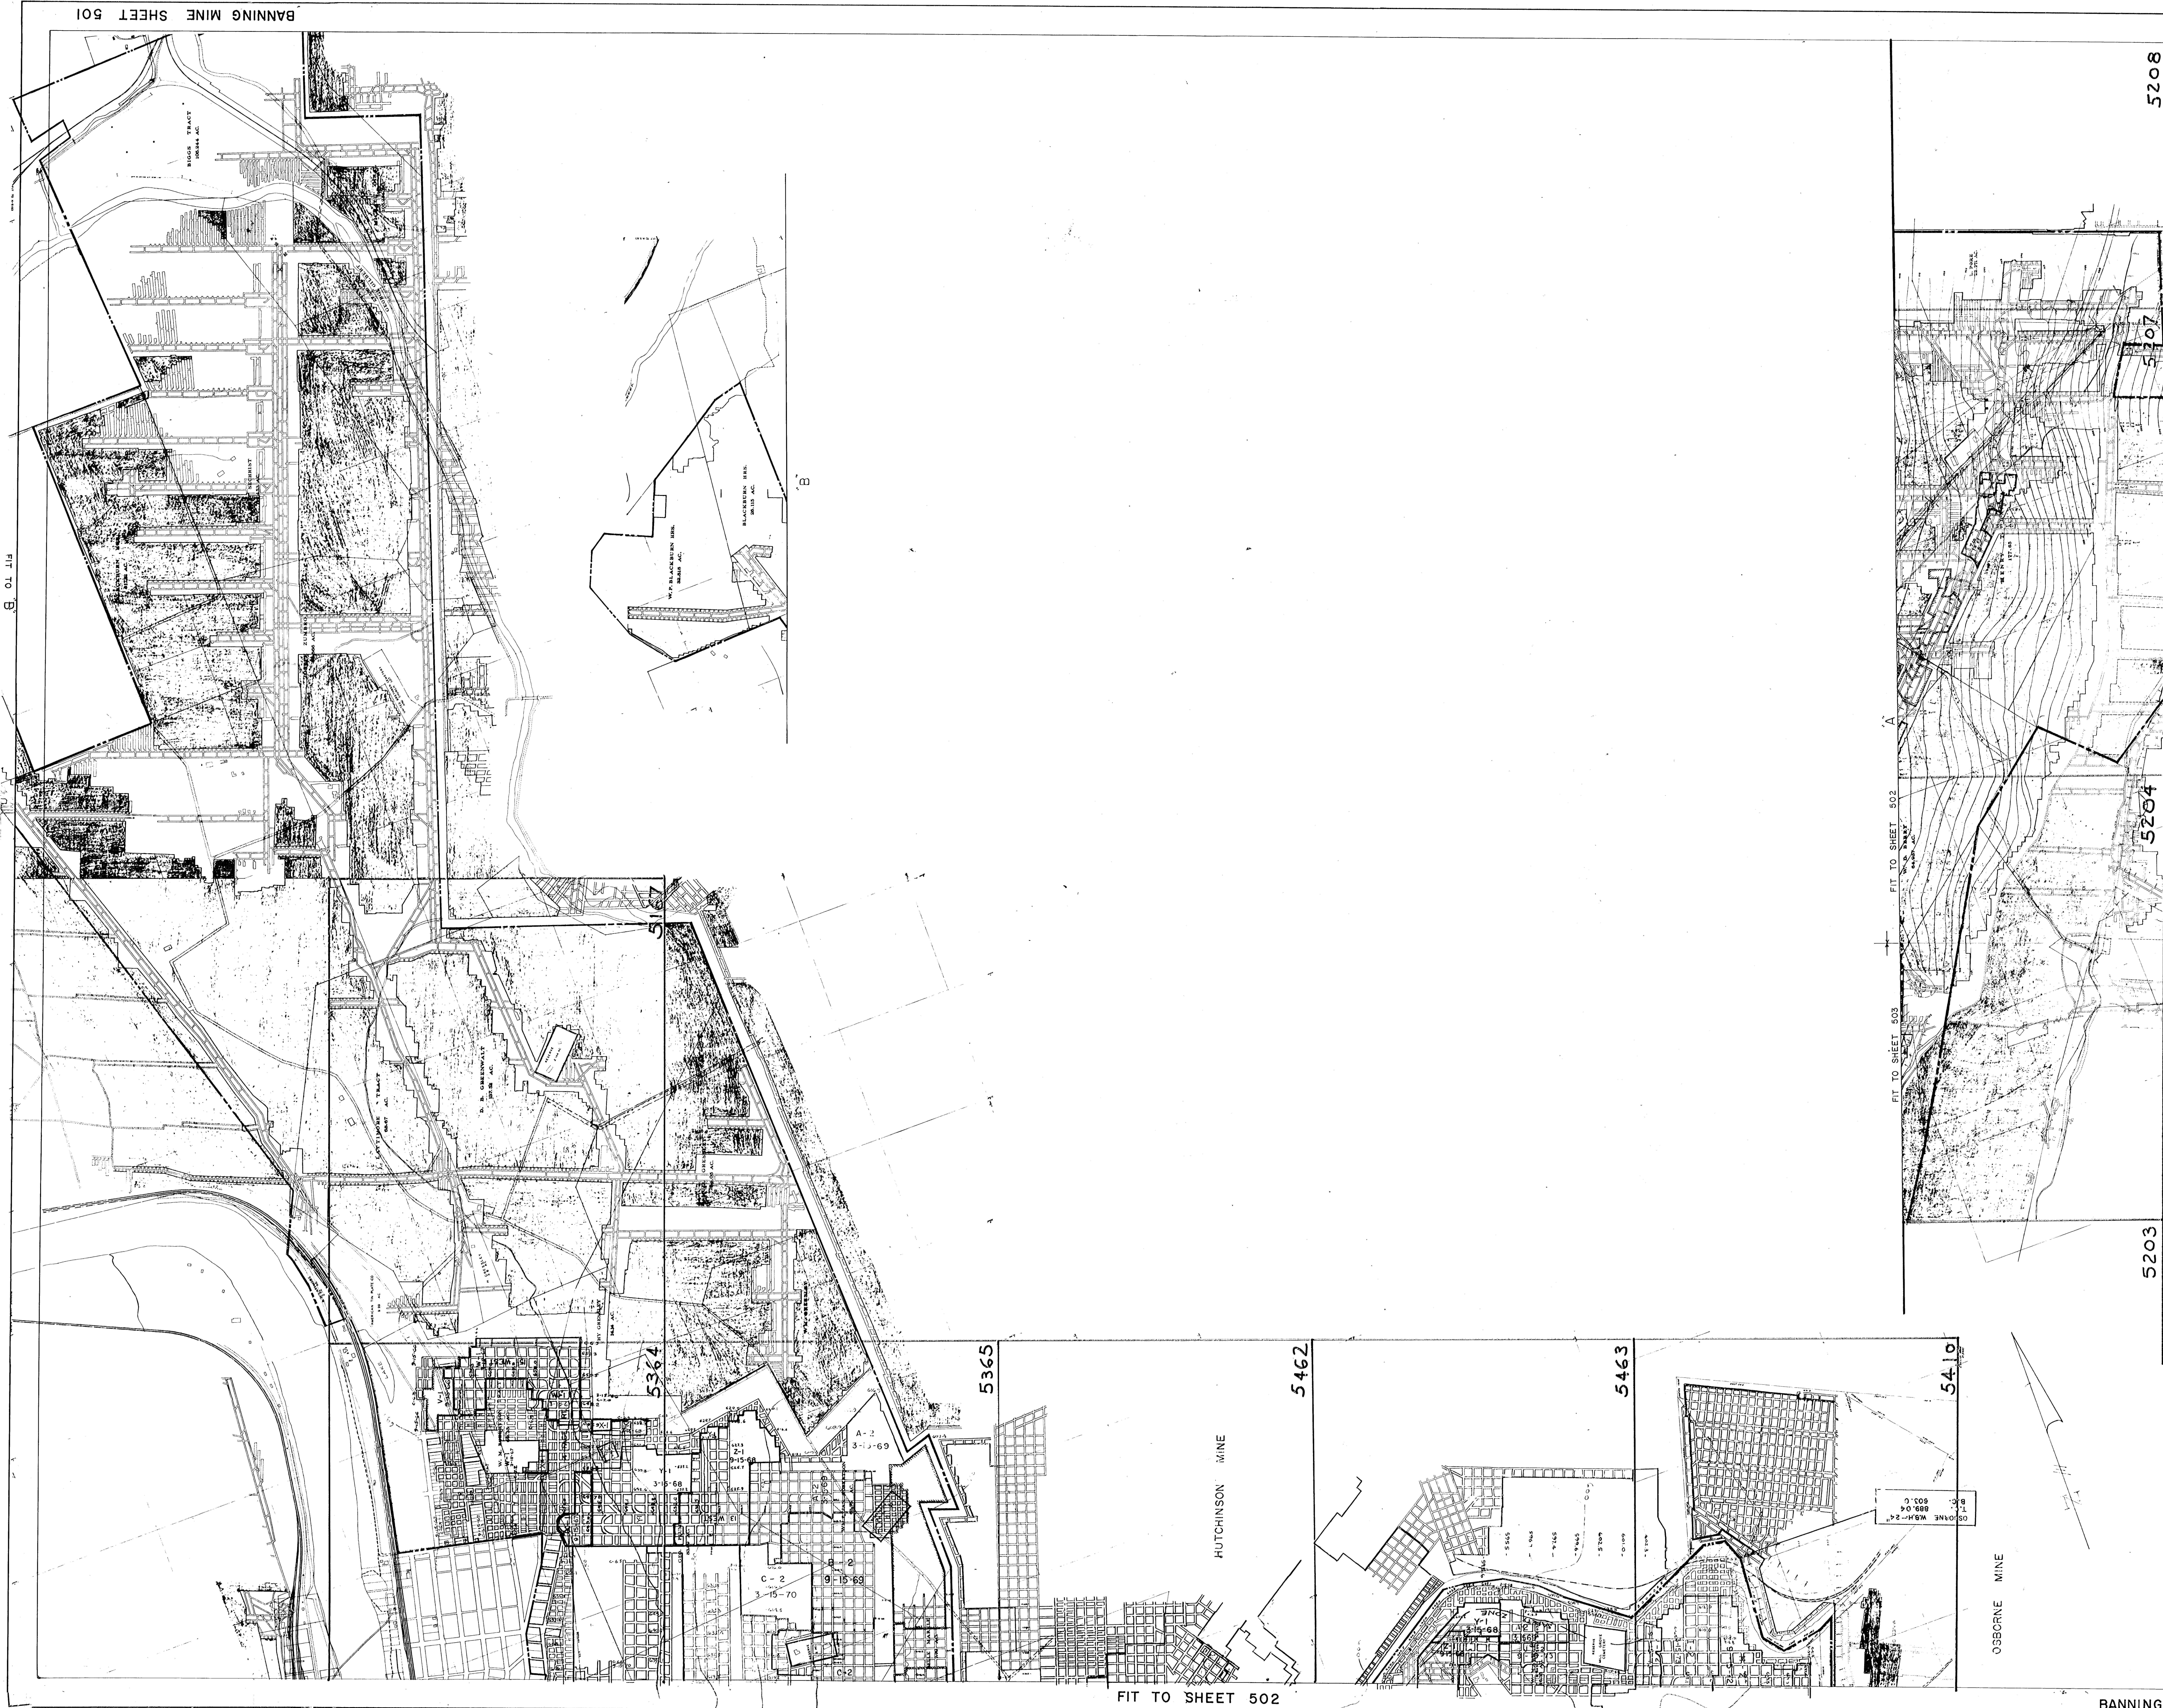

5208

5206

5203

5204

BANNING MINE
BCNR MINING CORPORATION
ROSTRAVER TWP. & SOUTH HUNTINGDON TWP
WESTMORELAND COUNTY, PA.
SCALE 1"=500' SURVEY EXTENDED TO-----

Note: 100' Scale Maps
are Scaled by Reg. Prof. Eng.

5209

5206