




FIT TO SHEET 502

HUTCHINSON IMINE

5462

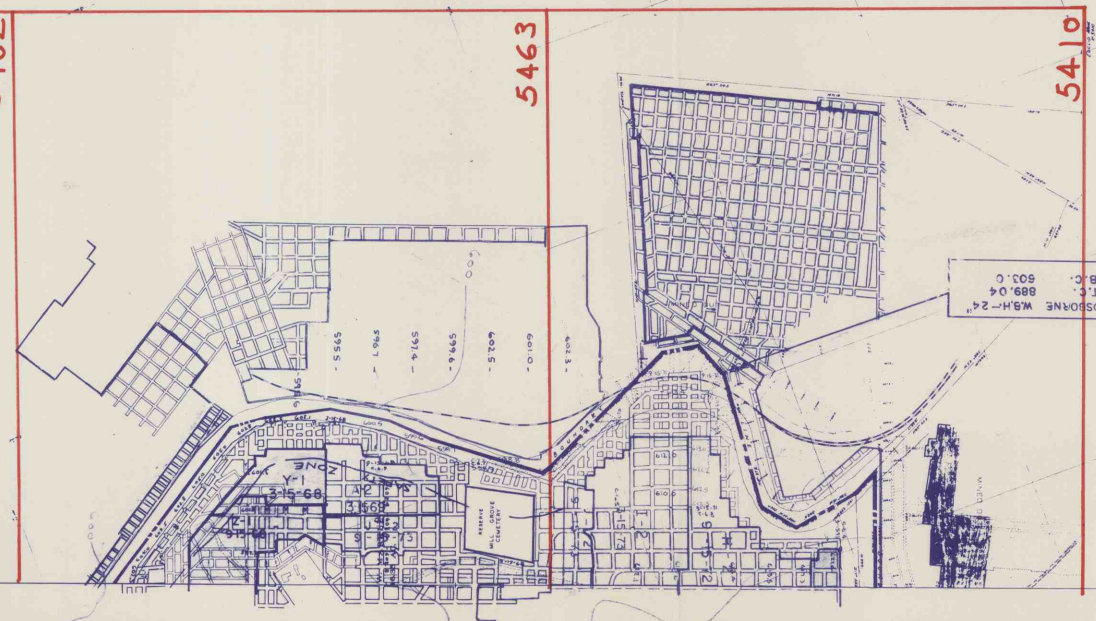

OSBORNE MINE

5410

FIT TO SHEET 503

FIT TO SHEET 502

5203

5204


5208

BANNING MINE

BCNR MINING CORPORATION
ROSTRAVER TWP. & SOUTH HUNTINGDON TWP.
WESTMORELAND COUNTY, PA.

SCALE 1"=500' SURVEY EXTENDED TO-----

Note: 100' Scale maps
are sealed. by Reg. Prof. Eng.

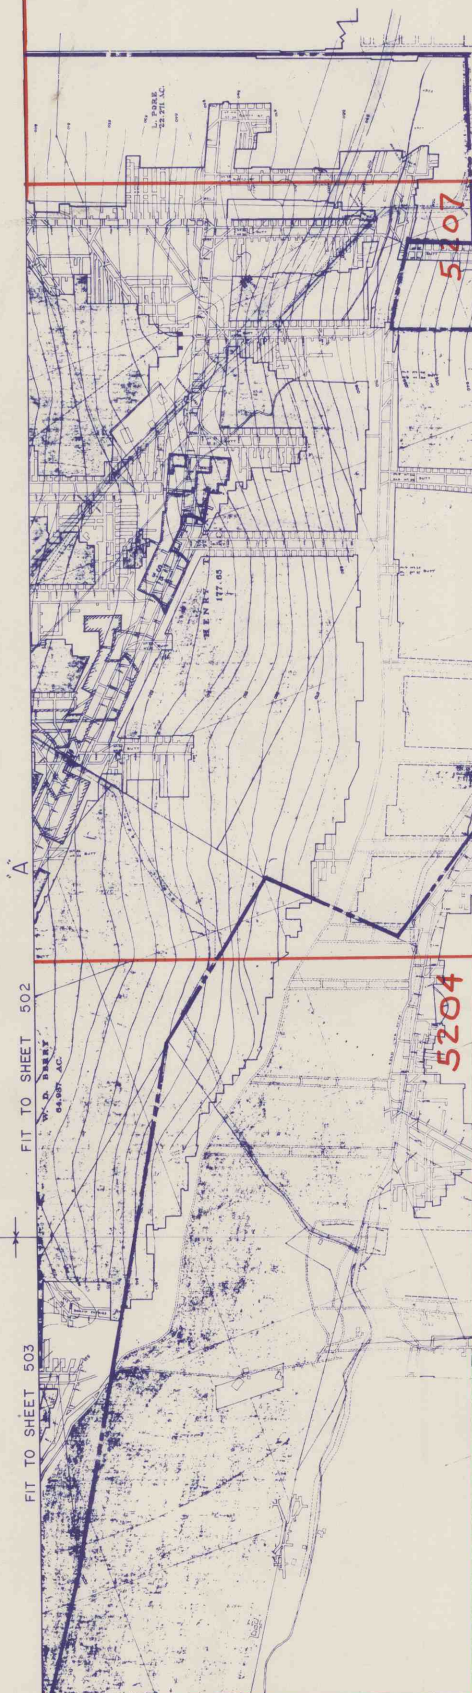

5206

5209