


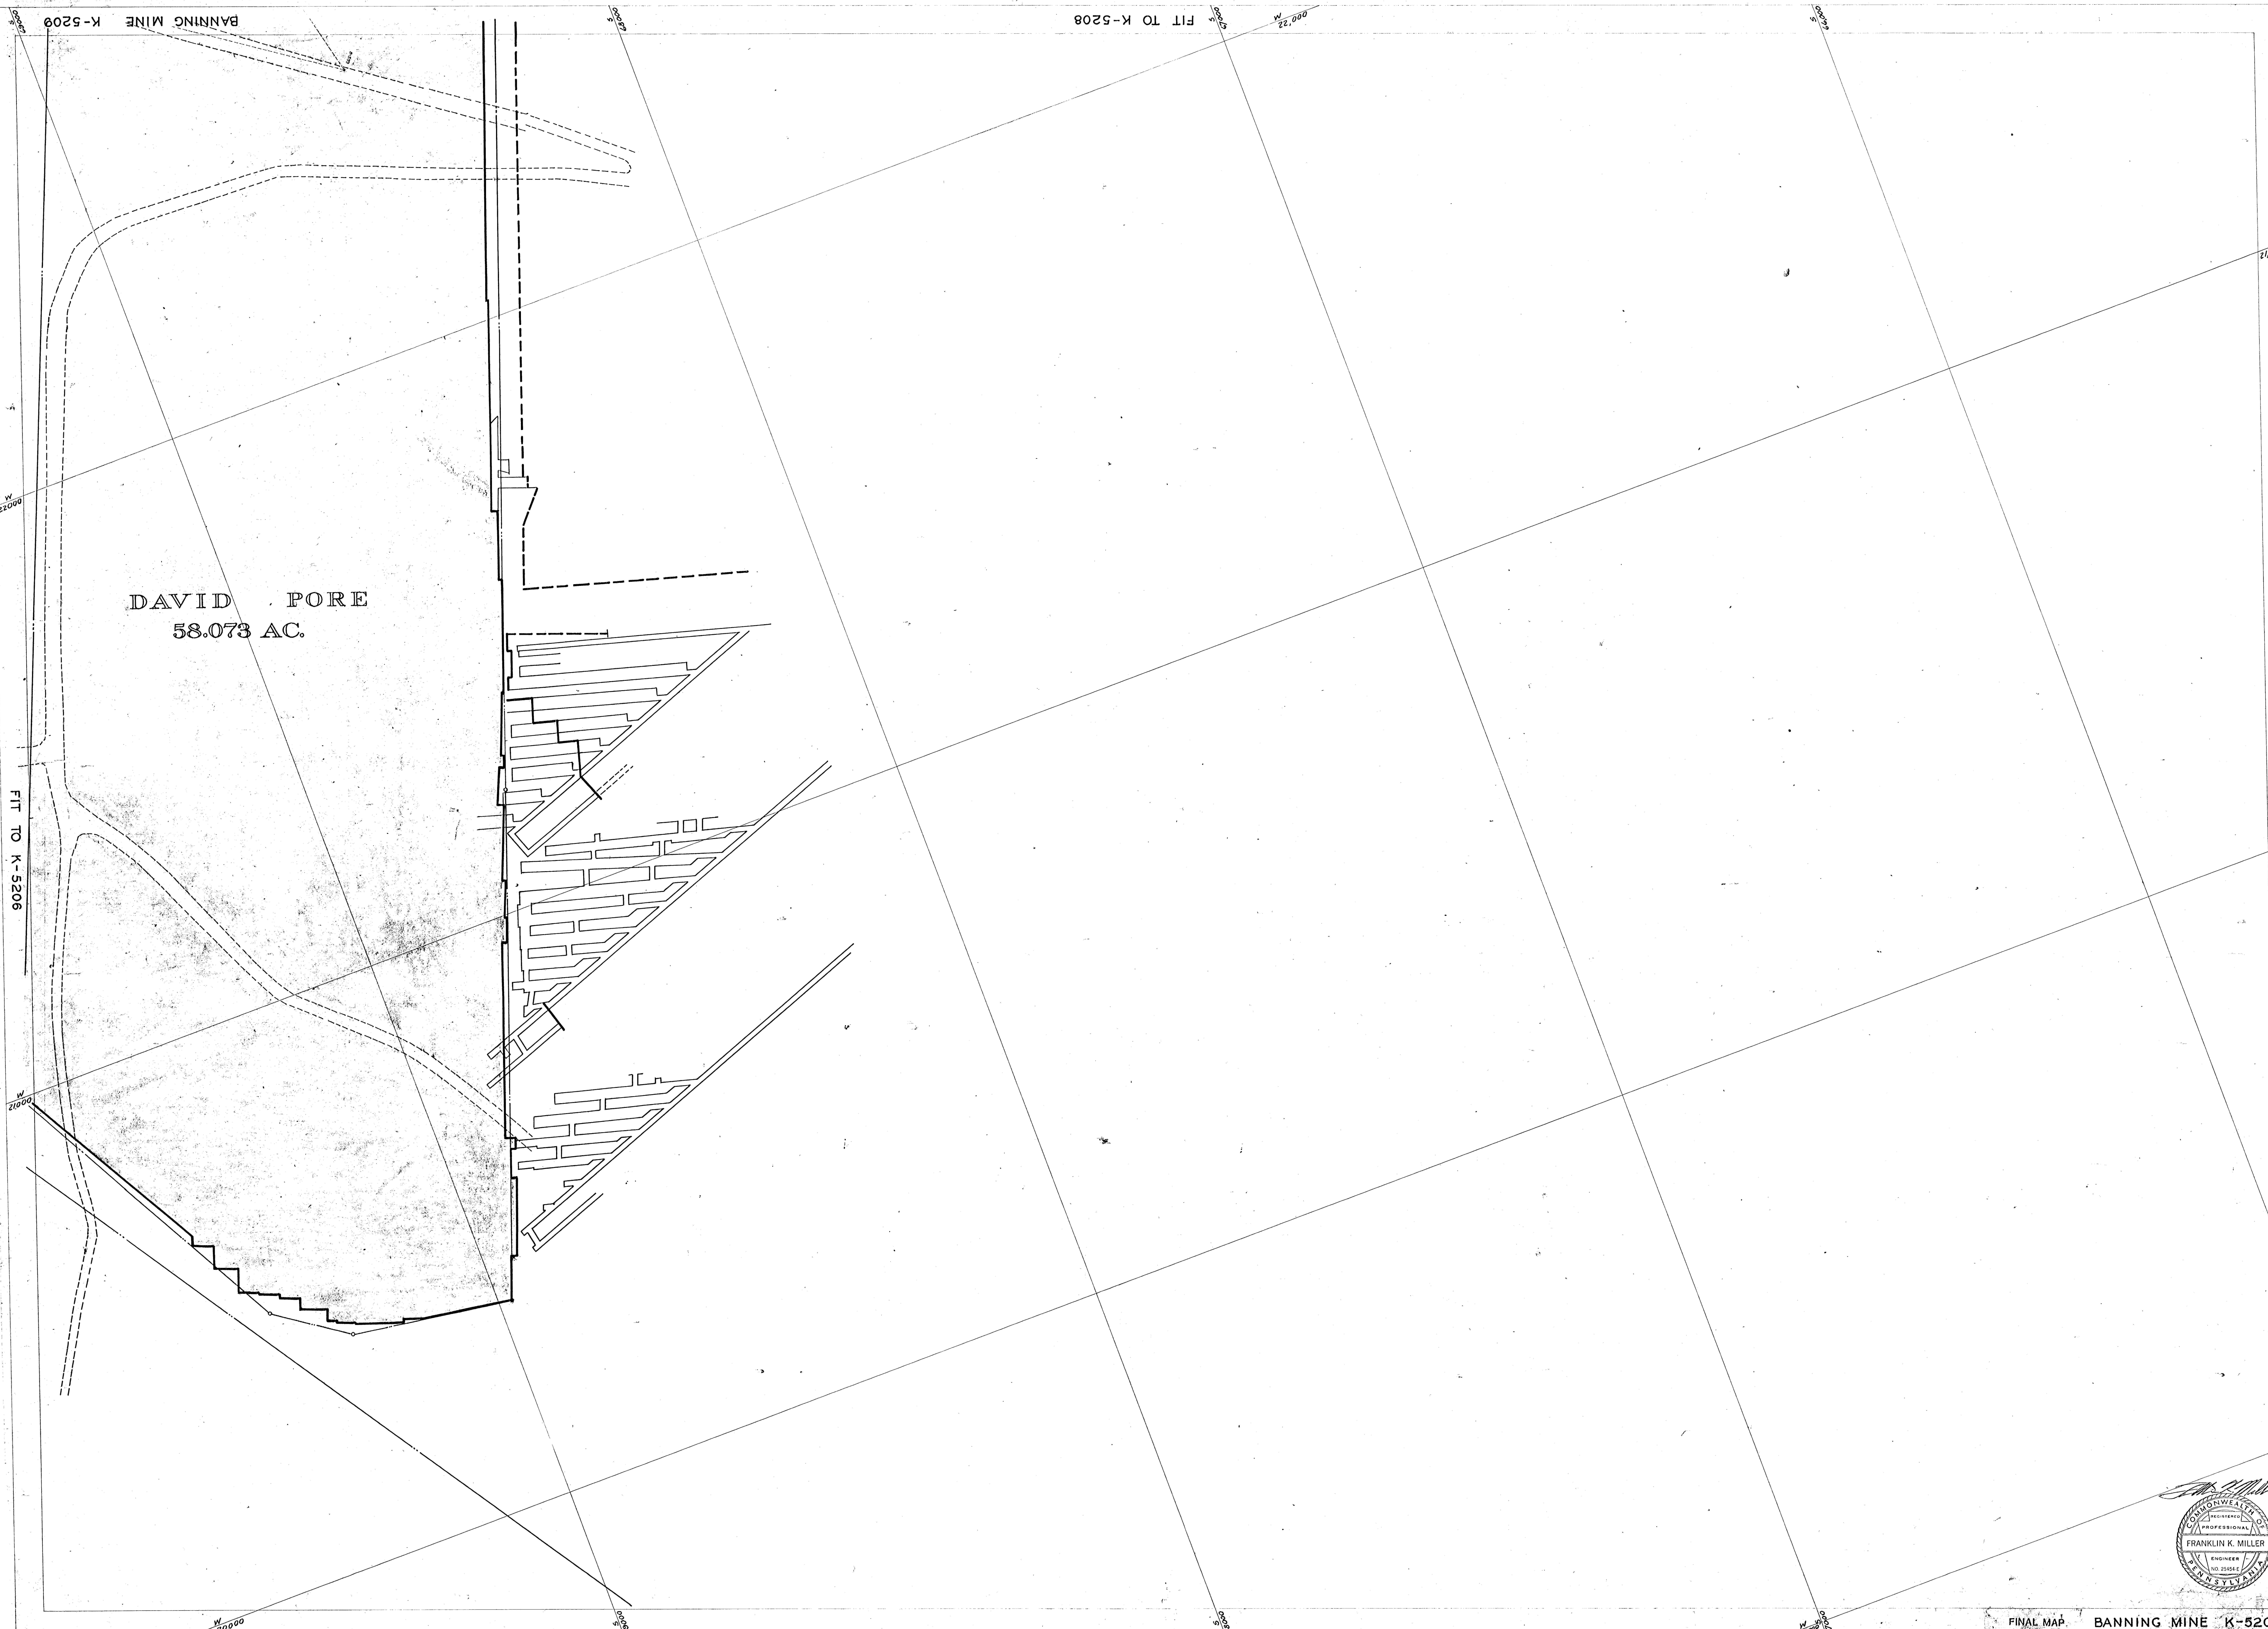

DAVID PORE
58.073 AC.

BANNING MINE K-5209

FIT TO K-5208

FIT TO K-5206

