


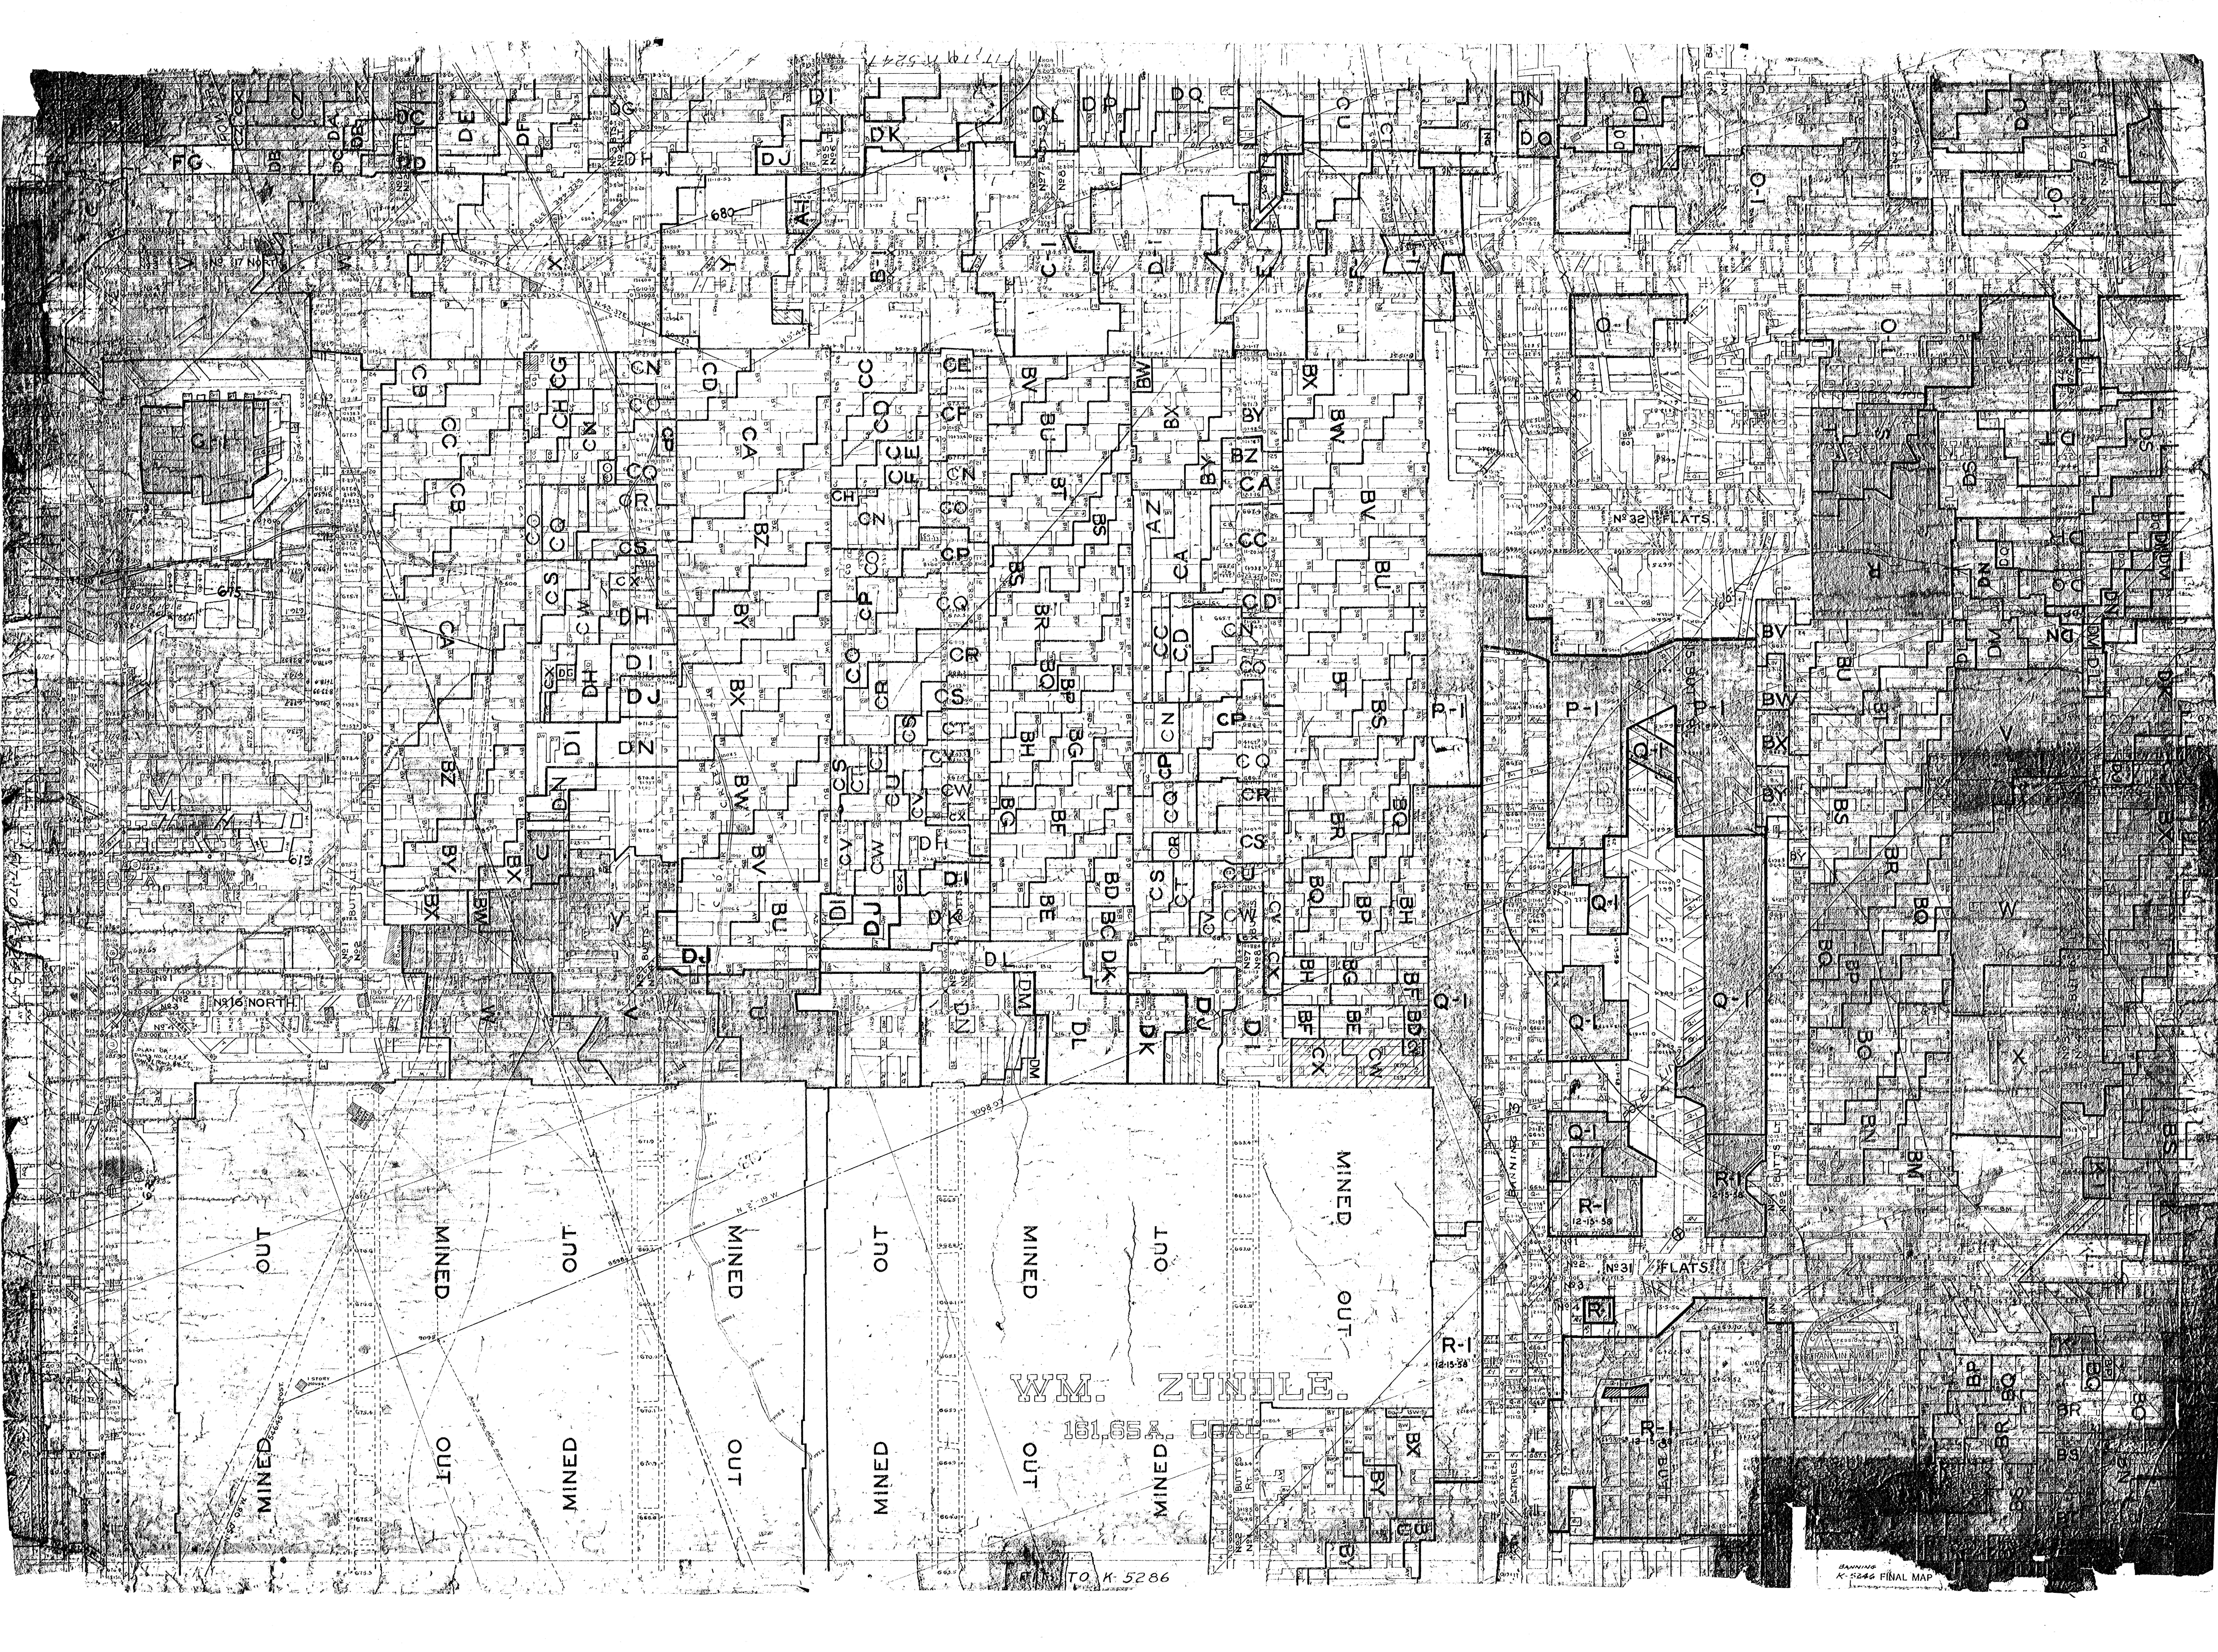

MINED OUT

MINED OUT

MINED OUT

MINED OUT

MINED OUT

MINED OUT

MINED OUT

MINED OUT

WM. ZUNDE

161.65 A. COAL

TO K-5286

