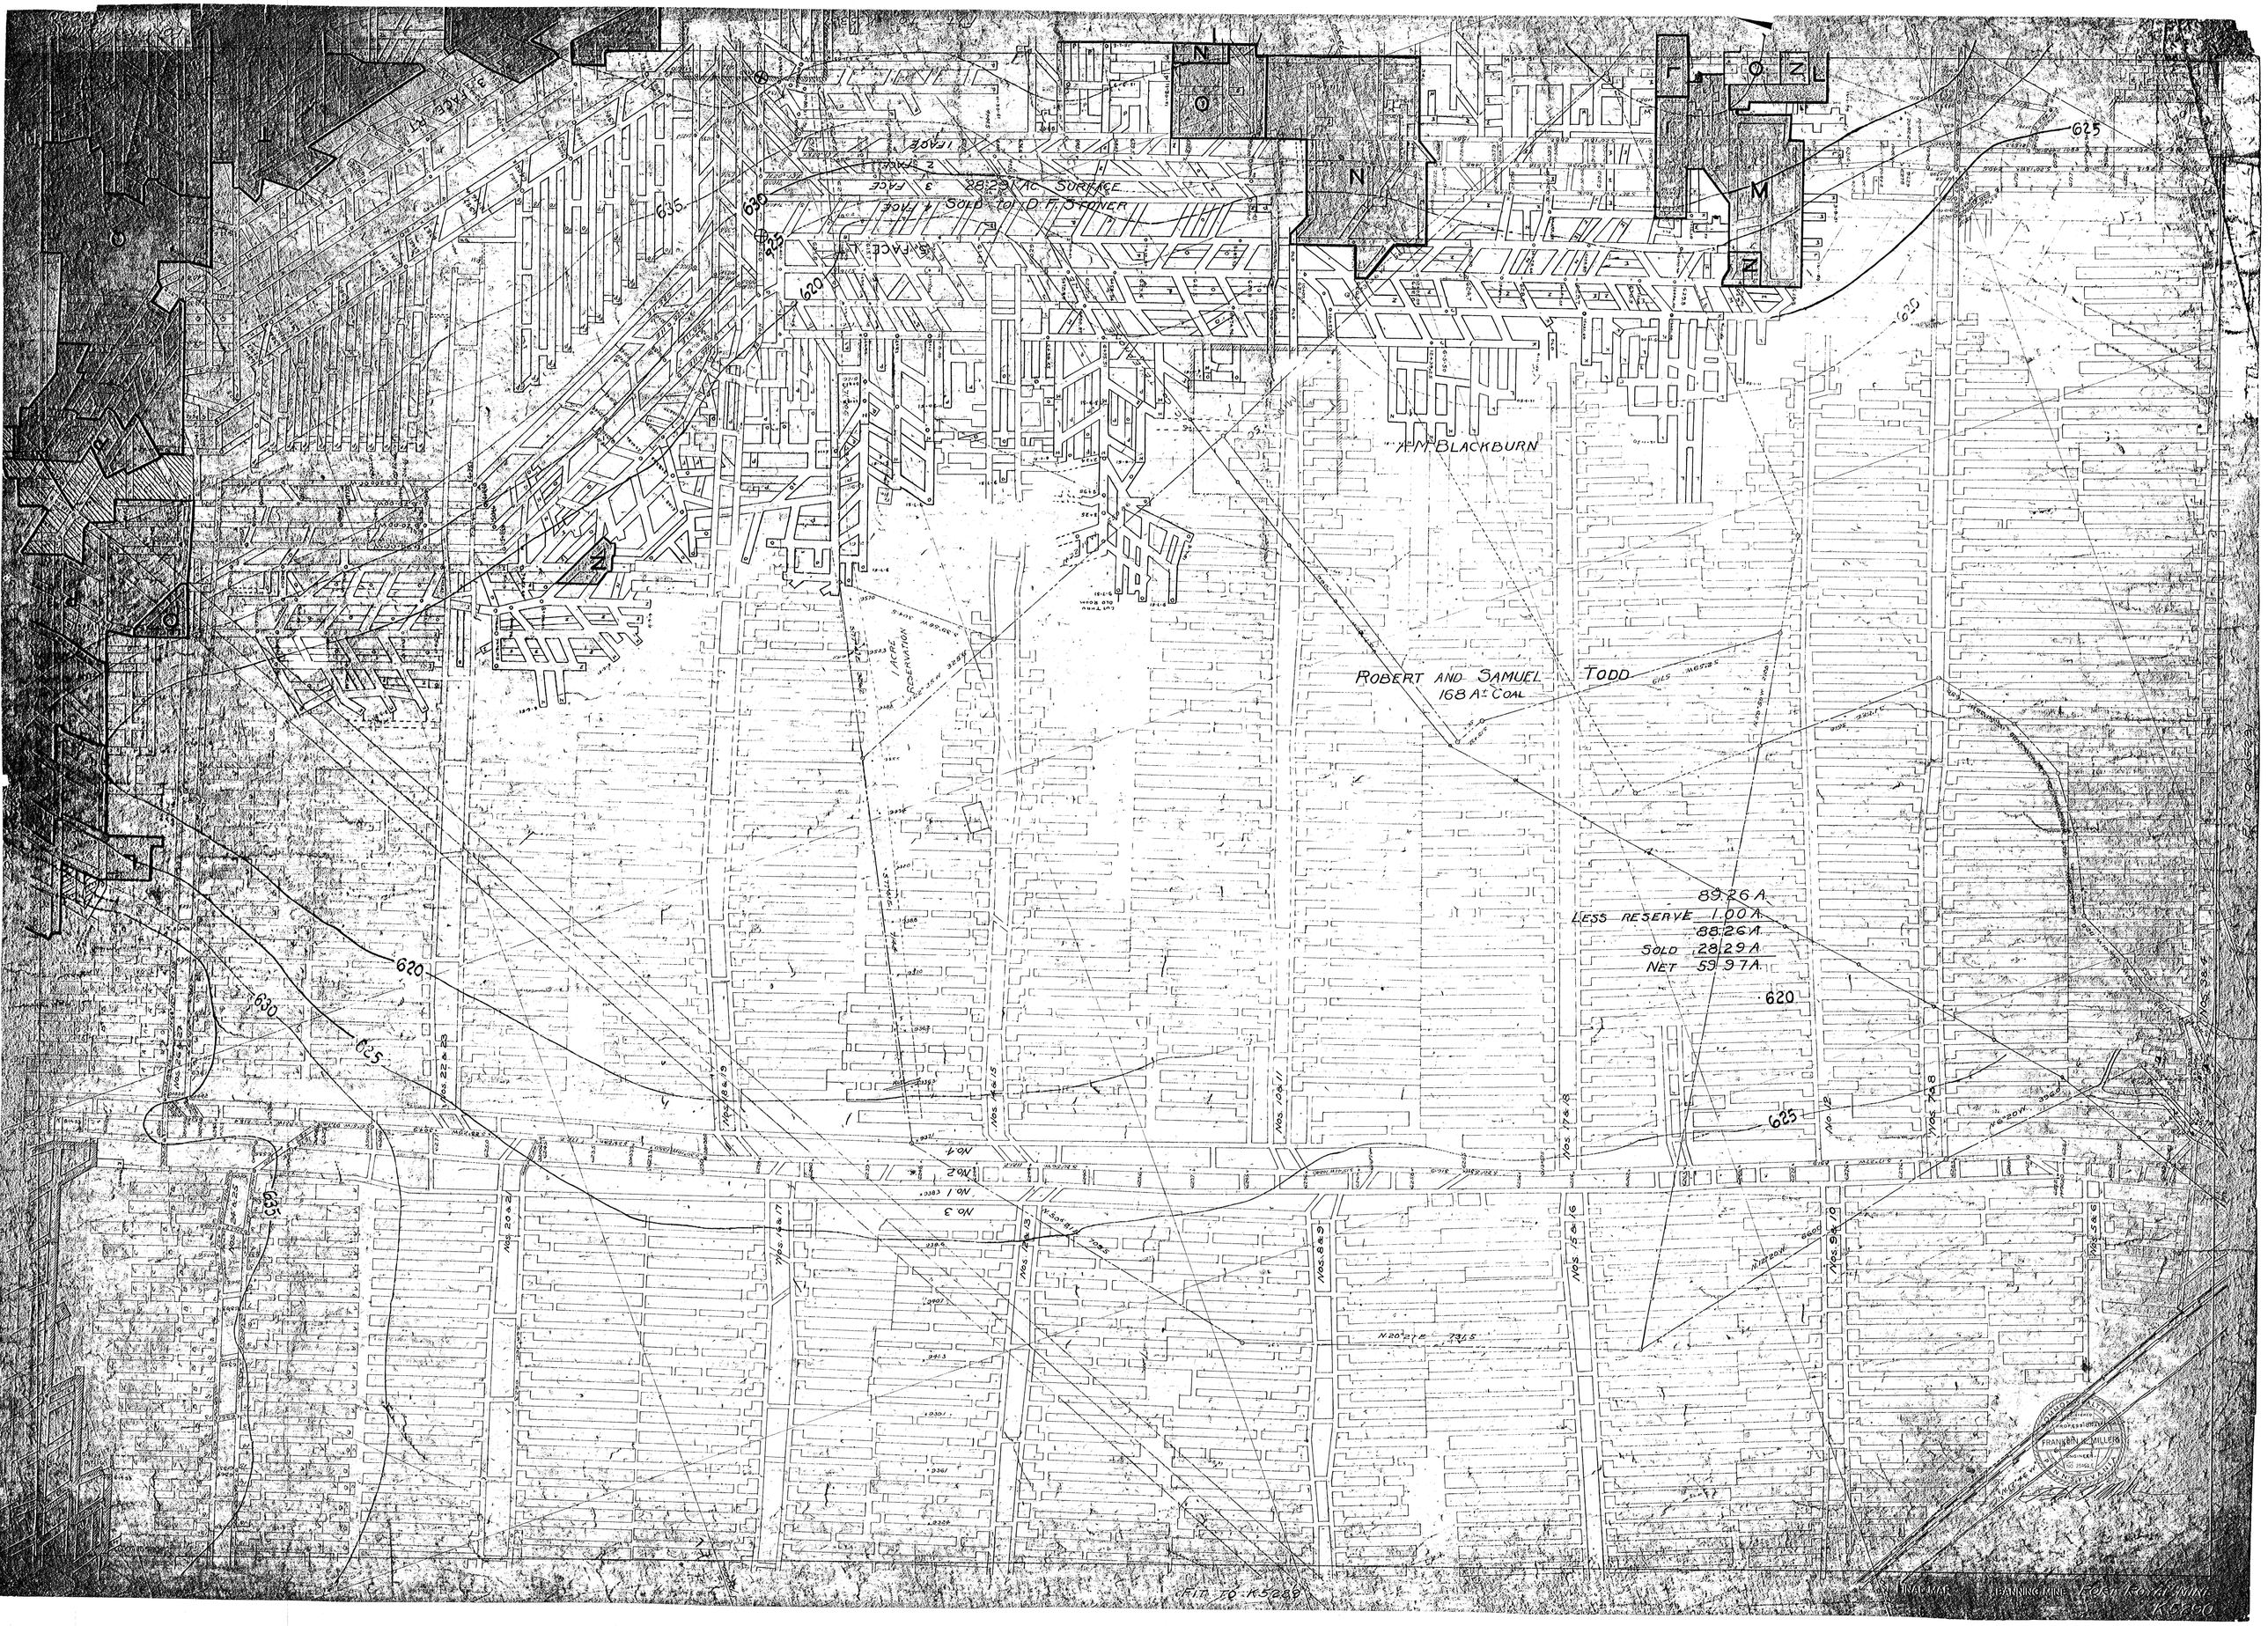

28.29 Ac. Surface
Sold to D.F. Stoner
1 Face
2 Face
3 Face
4 Face
5 Face Lt
3 Face Rt
A.M. Blackburn
Robert and Samuel Todd
168 A± Coal
1 Acre Reservation
Cut thru old room
89.26 A.
Less reserve 1.00 A.
88.26 A.
Sold 28.29 A.
Net 59.97 A.
620
625
630
635
No. 1
No. 2
No. 3
No. 4
Nos. 26 & 27
Nos. 24 & 25
Nos. 22 & 23
Nos. 20 & 21
Nos. 18 & 19
Nos. 16 & 17
Nos. 14 & 15
Nos. 12 & 13
Nos. 10 & 11
Nos. 8 & 9
Nos. 17 & 18
Nos. 15 & 16
No. 12
Nos. 9 & 10
Nos. 7 & 8
Nos. 5 & 6
Nos. 3 & 4
N. 20° 27' E. 731.5
N. 50° 81' E. 709.5
N. 6° 20' W. 356.0
N. 12° 20' W. 660.0
N
O
M
Z
L
Fit to K5289
Fit to K5291

Franklin K. Miller
No. 25464-E

Final Map
Banning Mine
Fort Royal Mine
K5290