


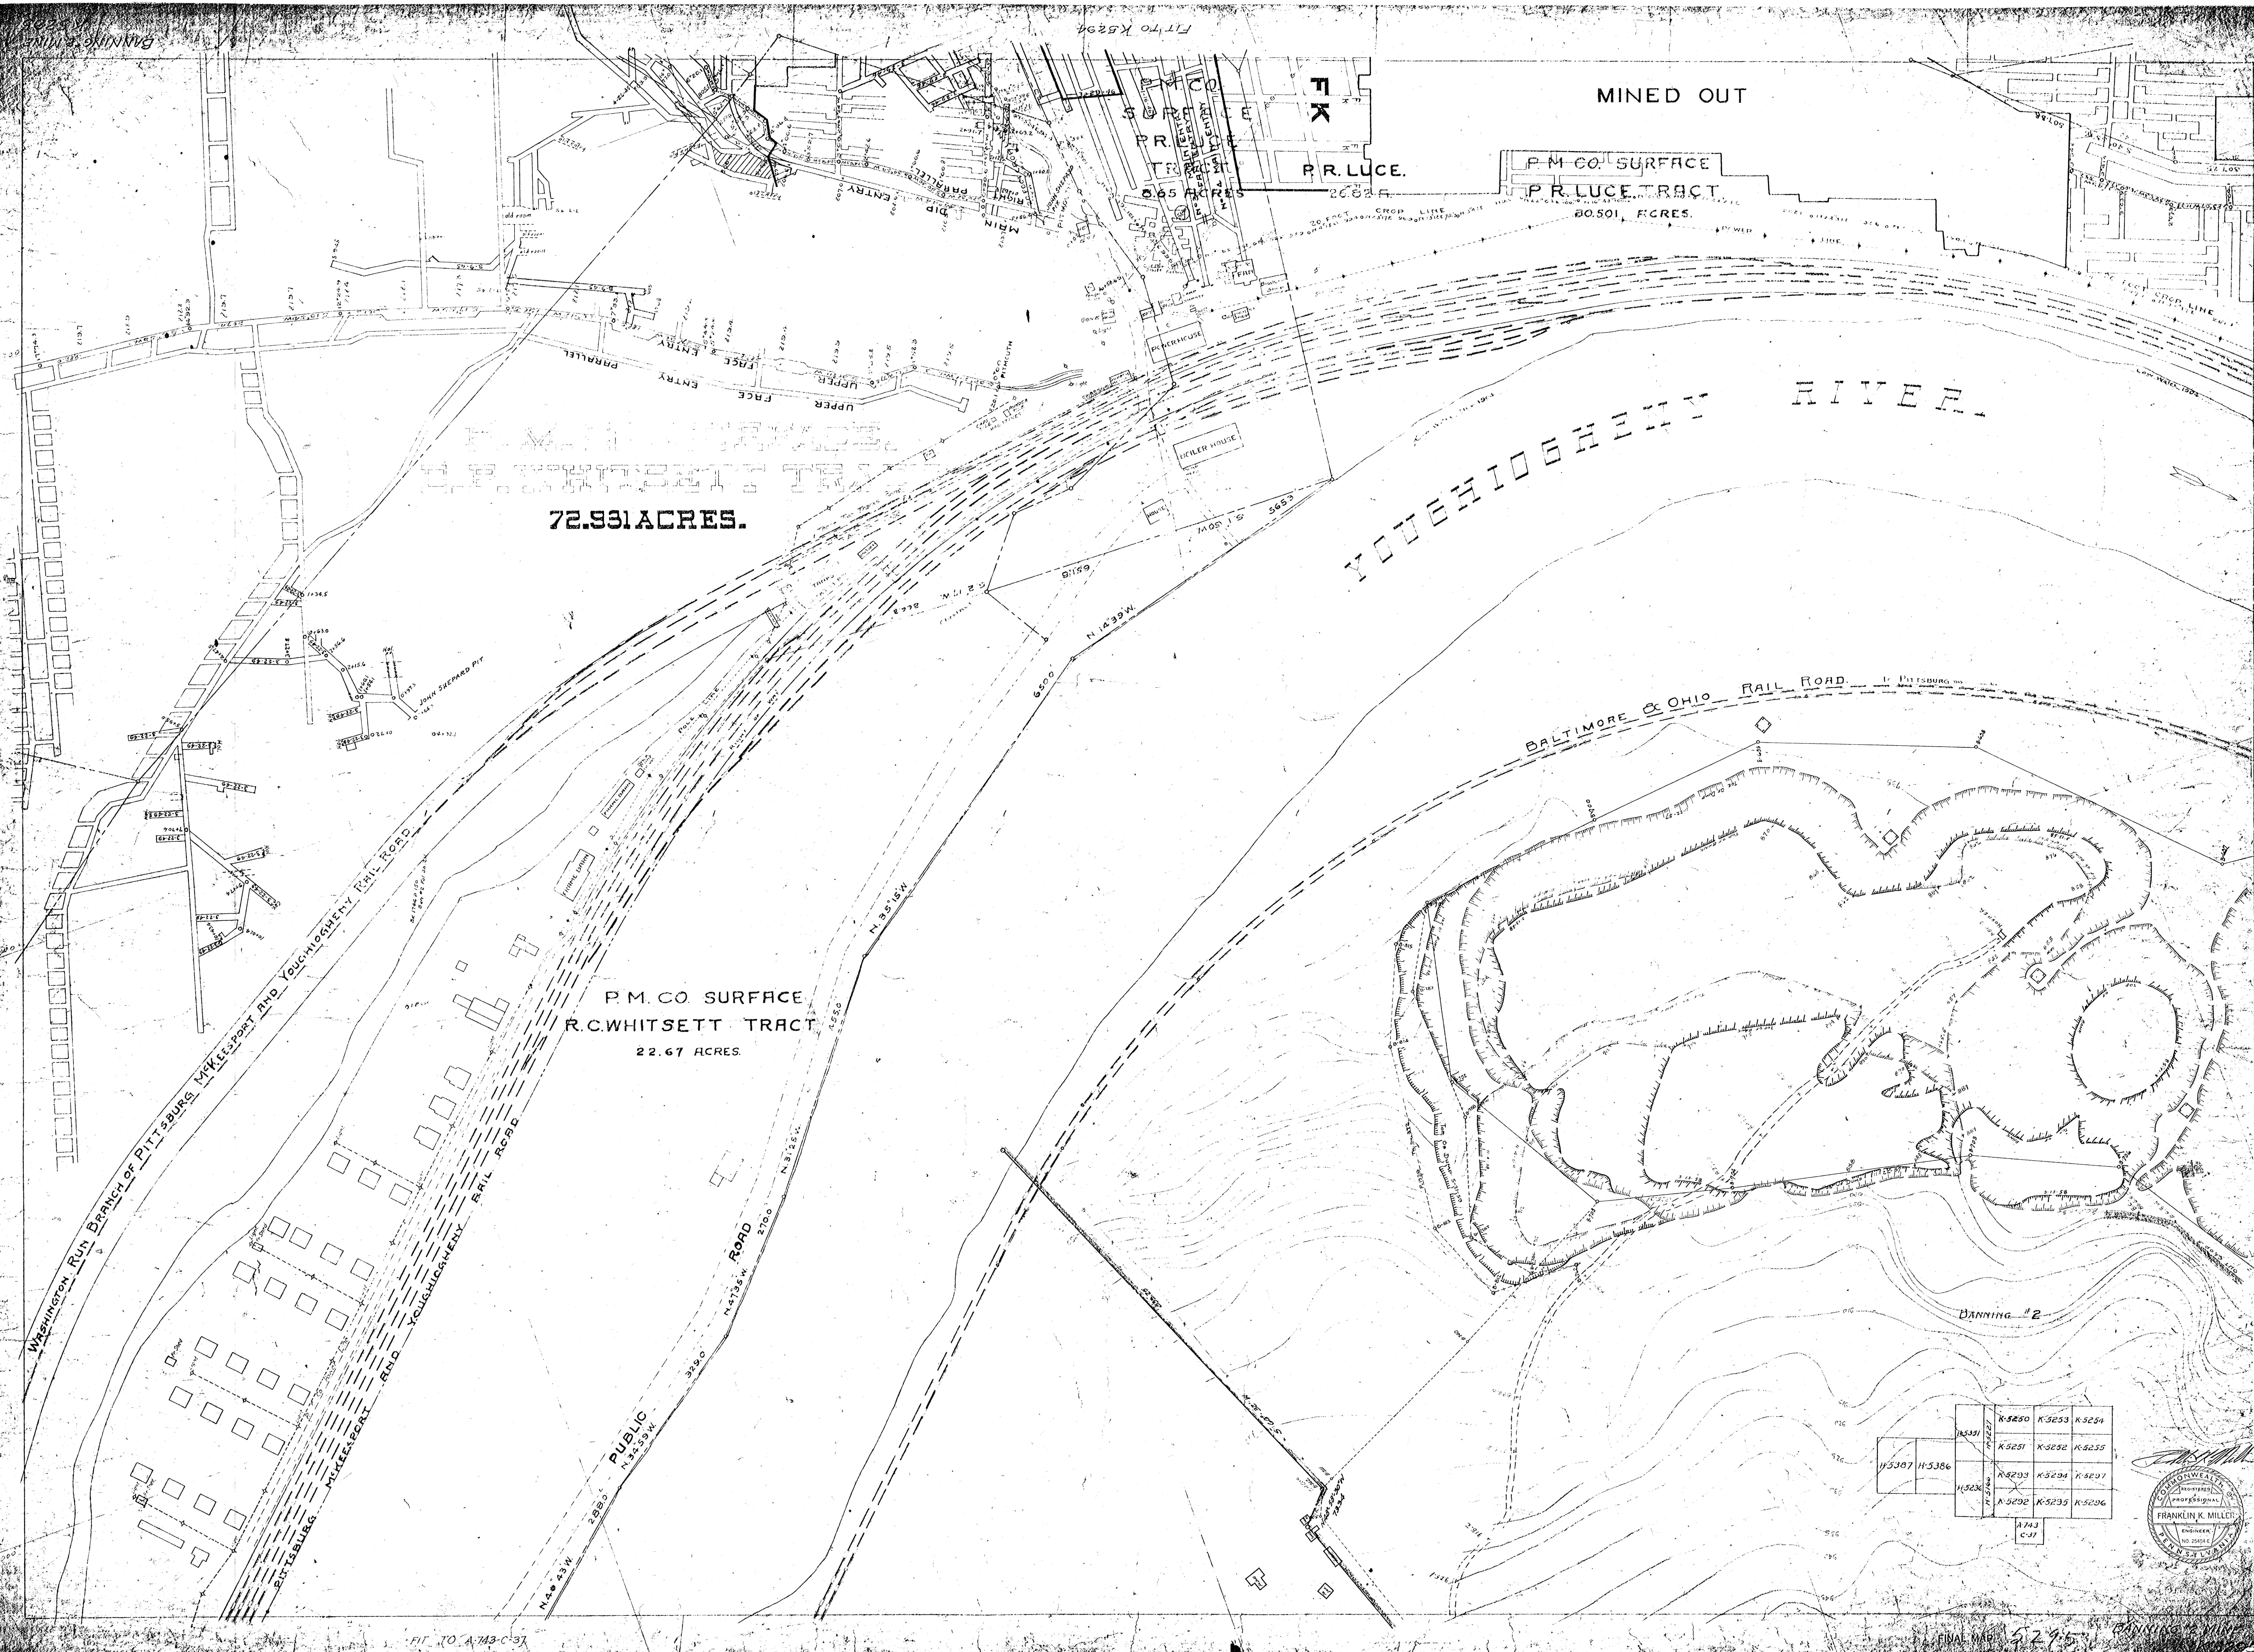

72.931 ACRES.

P.M. CO SURFACE
R.C. WHITSETT TRACT
22.67 ACRES.

P.M. CO SURFACE
P.R. LUCE TRACT
20.501 ACRES.

MINED OUT

P.R. LUCE

P.R. LUCE TRACT
20.501 ACRES

YOUGHIOGHENY RIVER

BALTIMORE & OHIO RAIL ROAD

DANNING #2

		K5250	K5253	K5254
		K5251	K5252	K5255
H5387	H5386	K5253	K5254	K5257
		K5252	K5255	K5256

