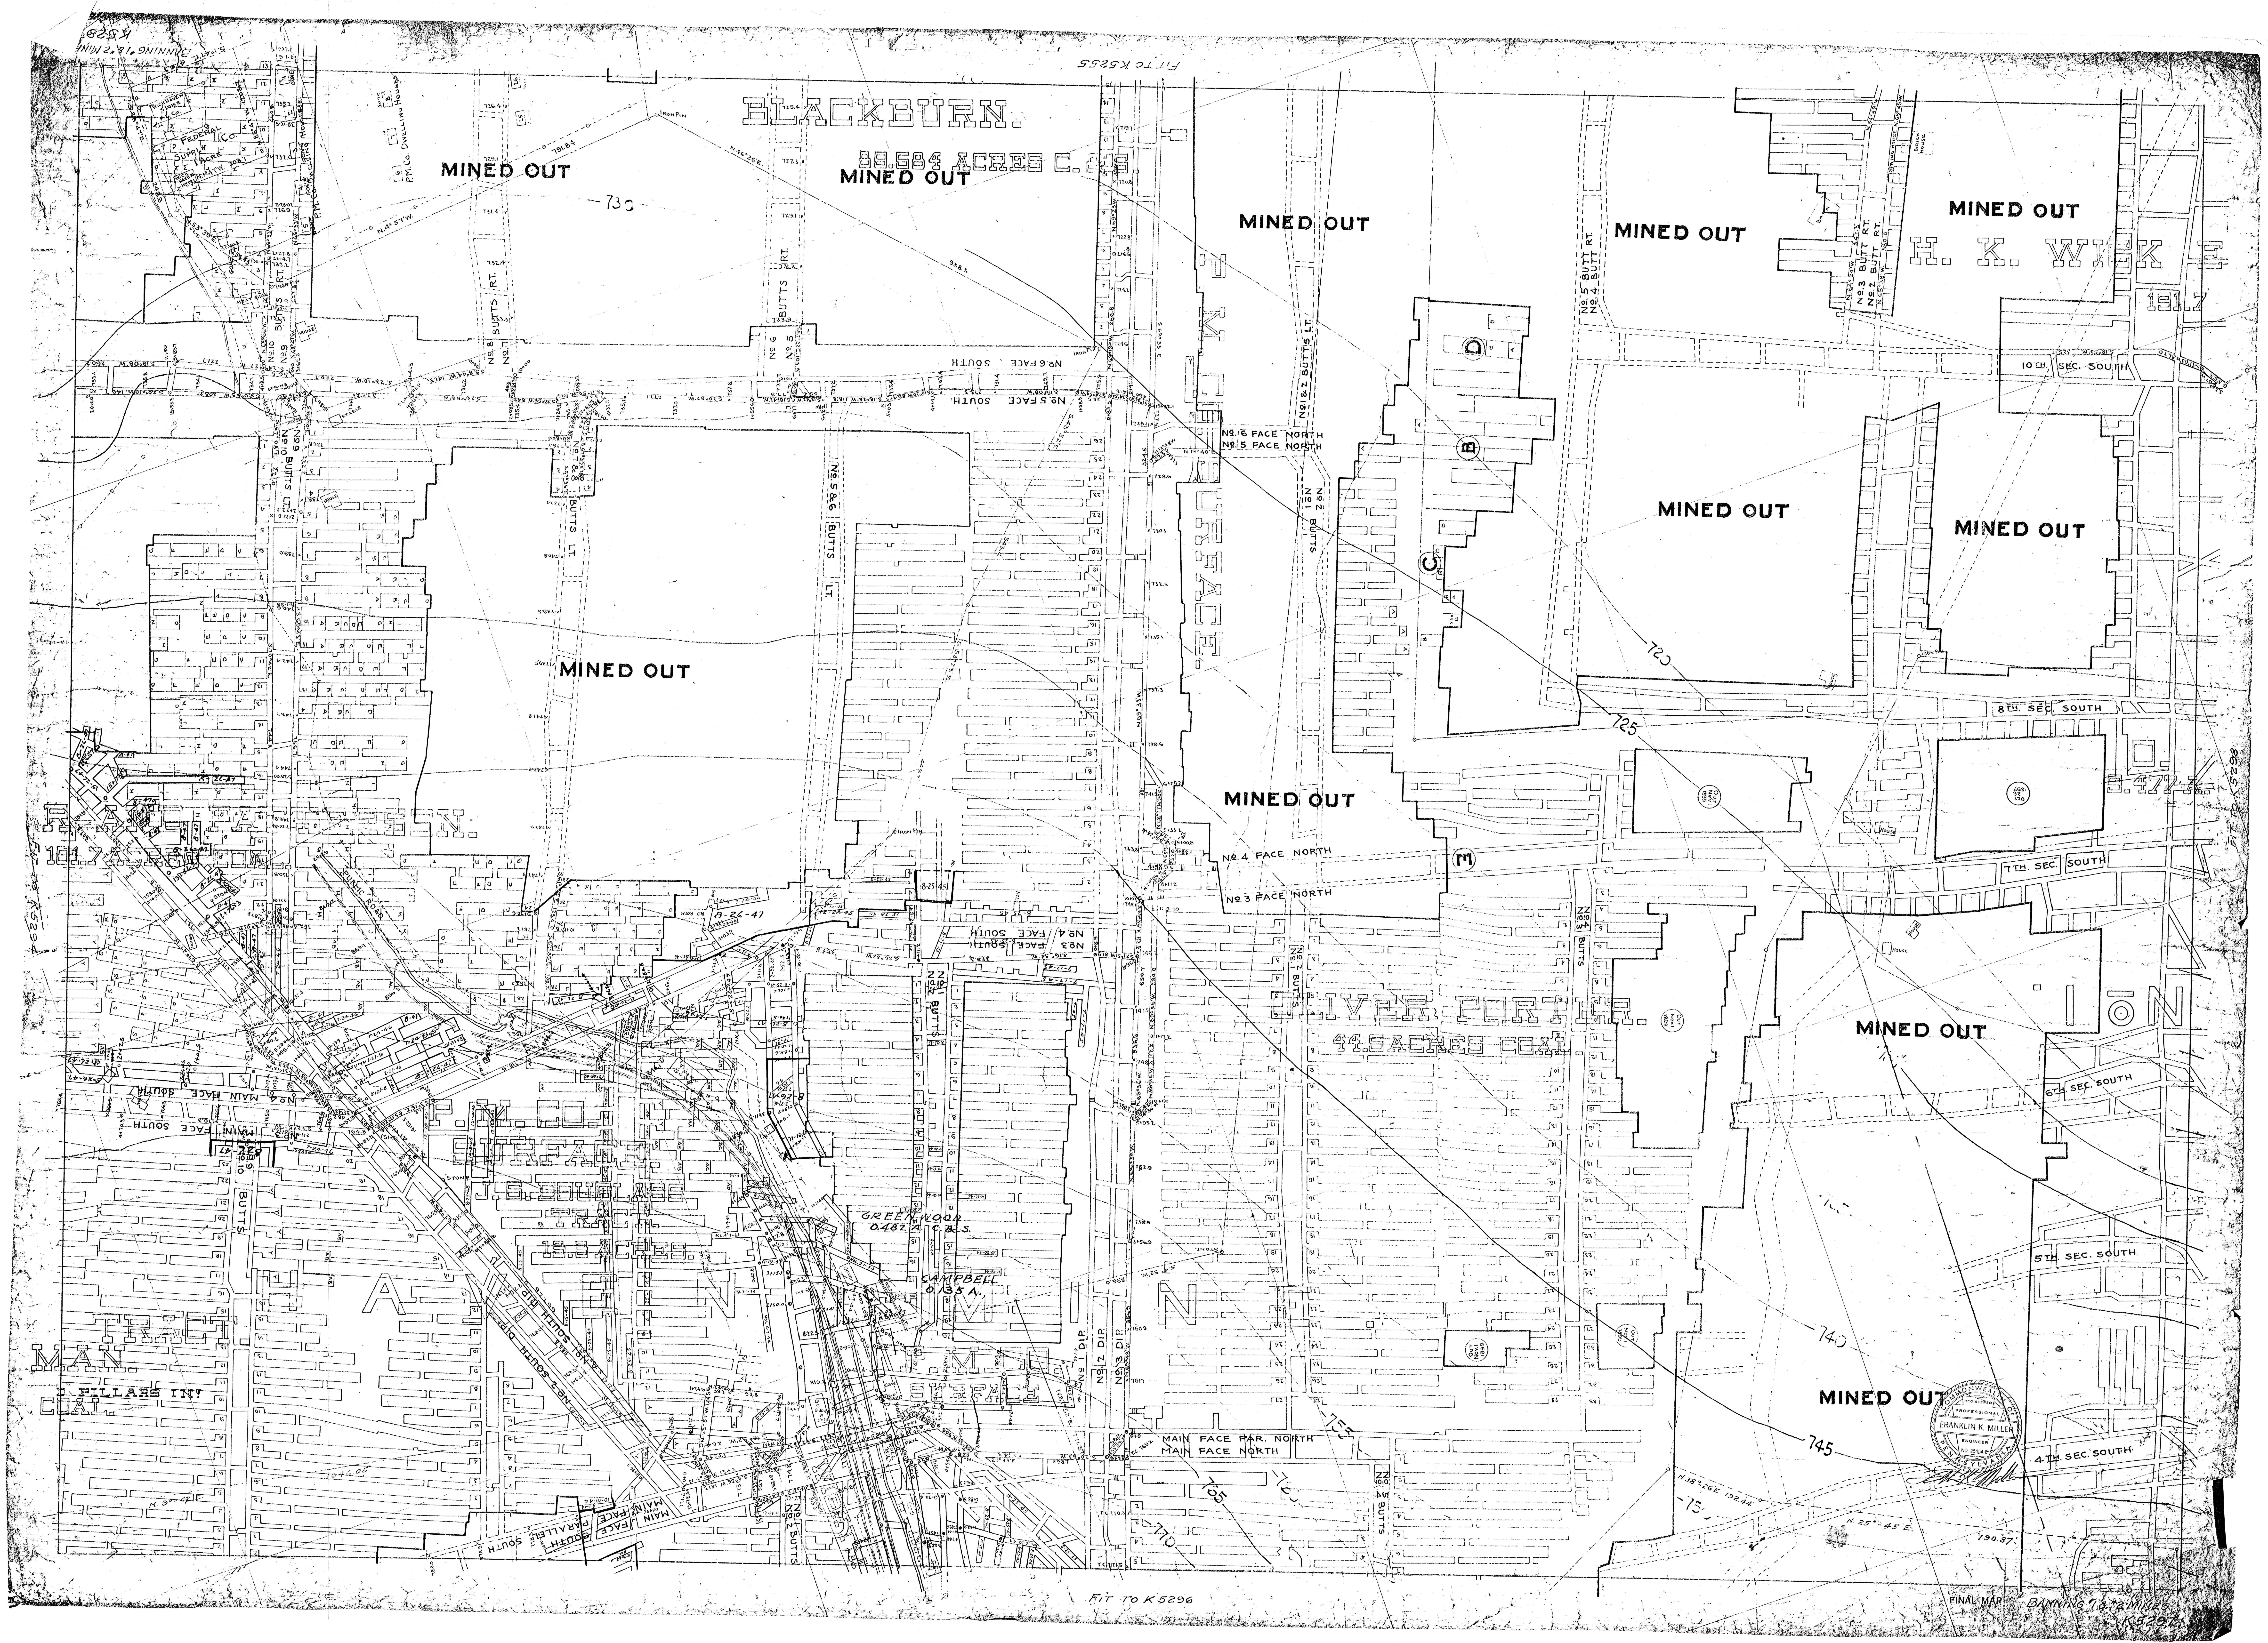

FINAL MAP BANNING #1 & #2 MINES K5297

FRANKLIN K. MILLER
NO. 25454-E