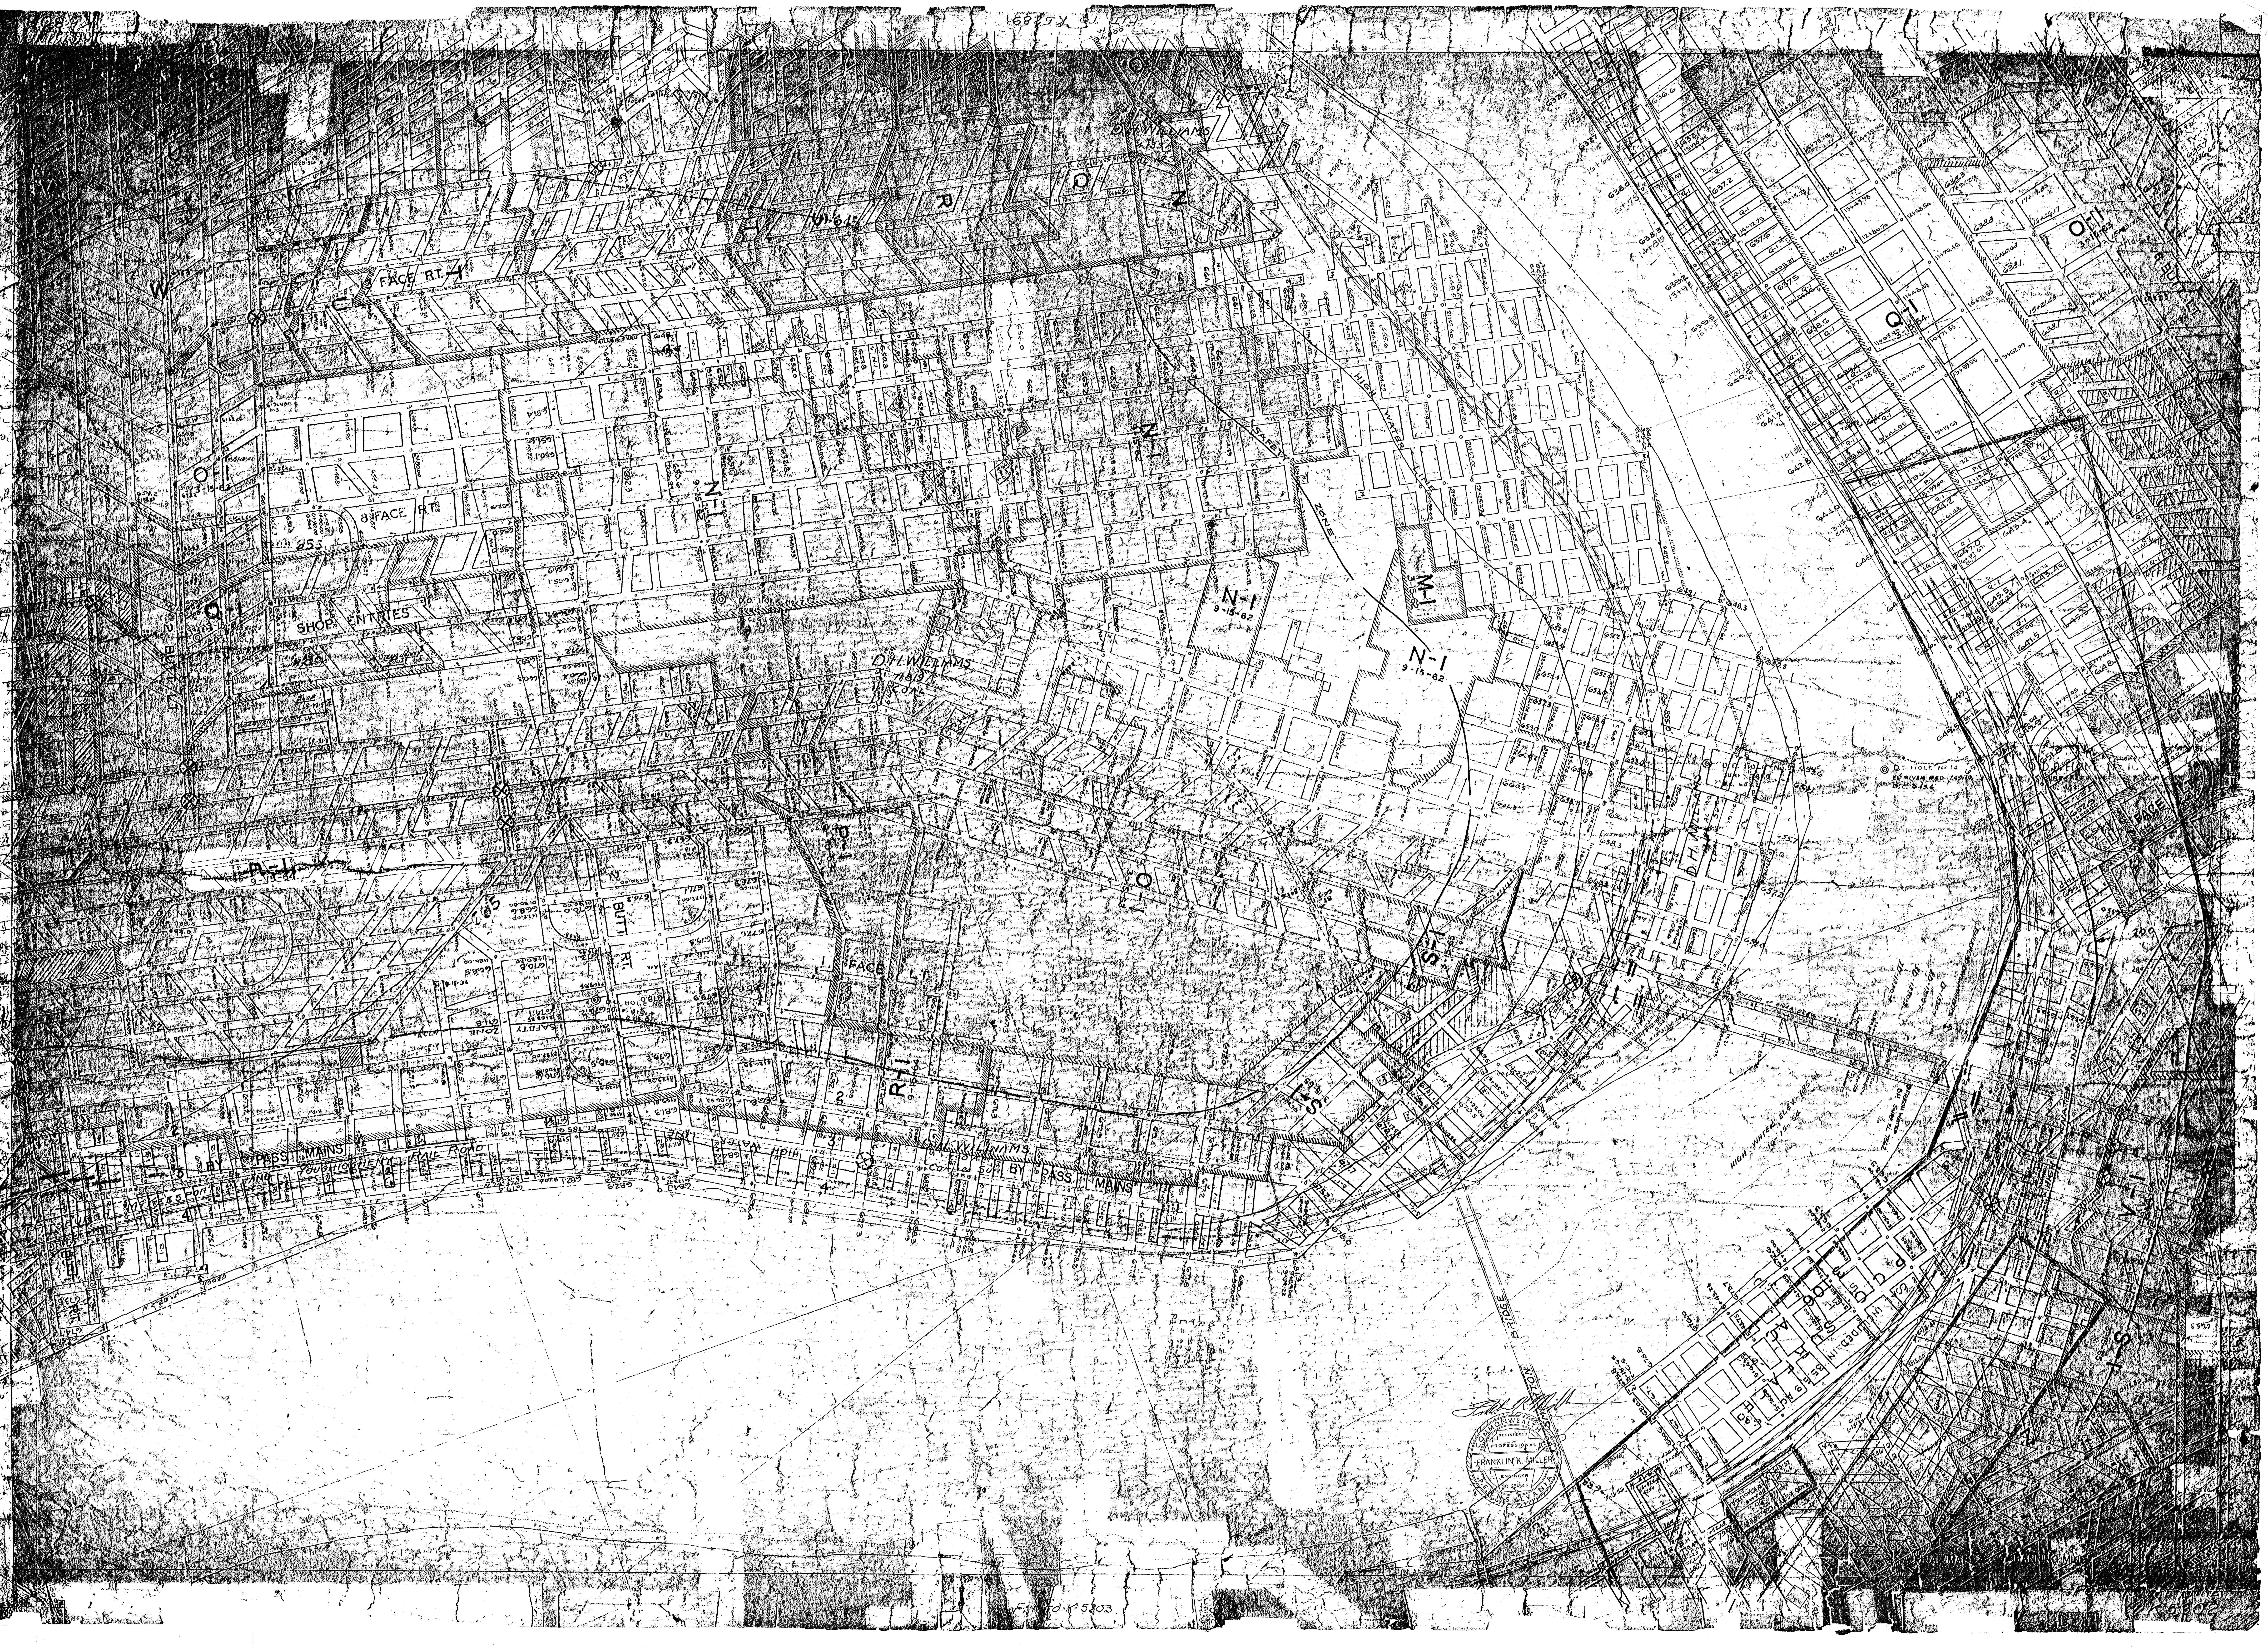
FIT TO K5289
W
O-1
3-15-63
Q-1
8 FACE RT.
6 FACE RT.
255
SHOP ENTRIES
2 BUTT LT.
U-645
R
Q
N
D.H. WILLIAMS
N-1
9-15-62
D.H. WILLIAMS
7-18-?
COAL
SAFETY ZONE
HIGH WATER LINE
M-1
3-15-62
N-1
9-15-62
N-1
9-15-62
Q-1
3-15-64
O-1
3-15-63
R-1
9-18-64
P-1
9-16-63
2 BUTT RT.
1 FACE LT.
SAFETY ZONE
O
3-15-63
S-1
S-1
R-1
9-15-64
D.H. WILLIAMS
BY PASS MAINS
McKEESPORT AND YOUGHIOGHENY RAIL ROAD
BY PASS MAINS
HIGH WATER LINE
HIGH WATER ELEV. 18
10-15-54
D.D. HOLE No. 14
D.D. HOLE No. 16
FACE
V-1
S-1
BRIDGE
INCLUDED IN
TIE TO K5303
FINAL MAP OF MINING
K5302

FRANKLIN K. MILLER
No. 25454-E