


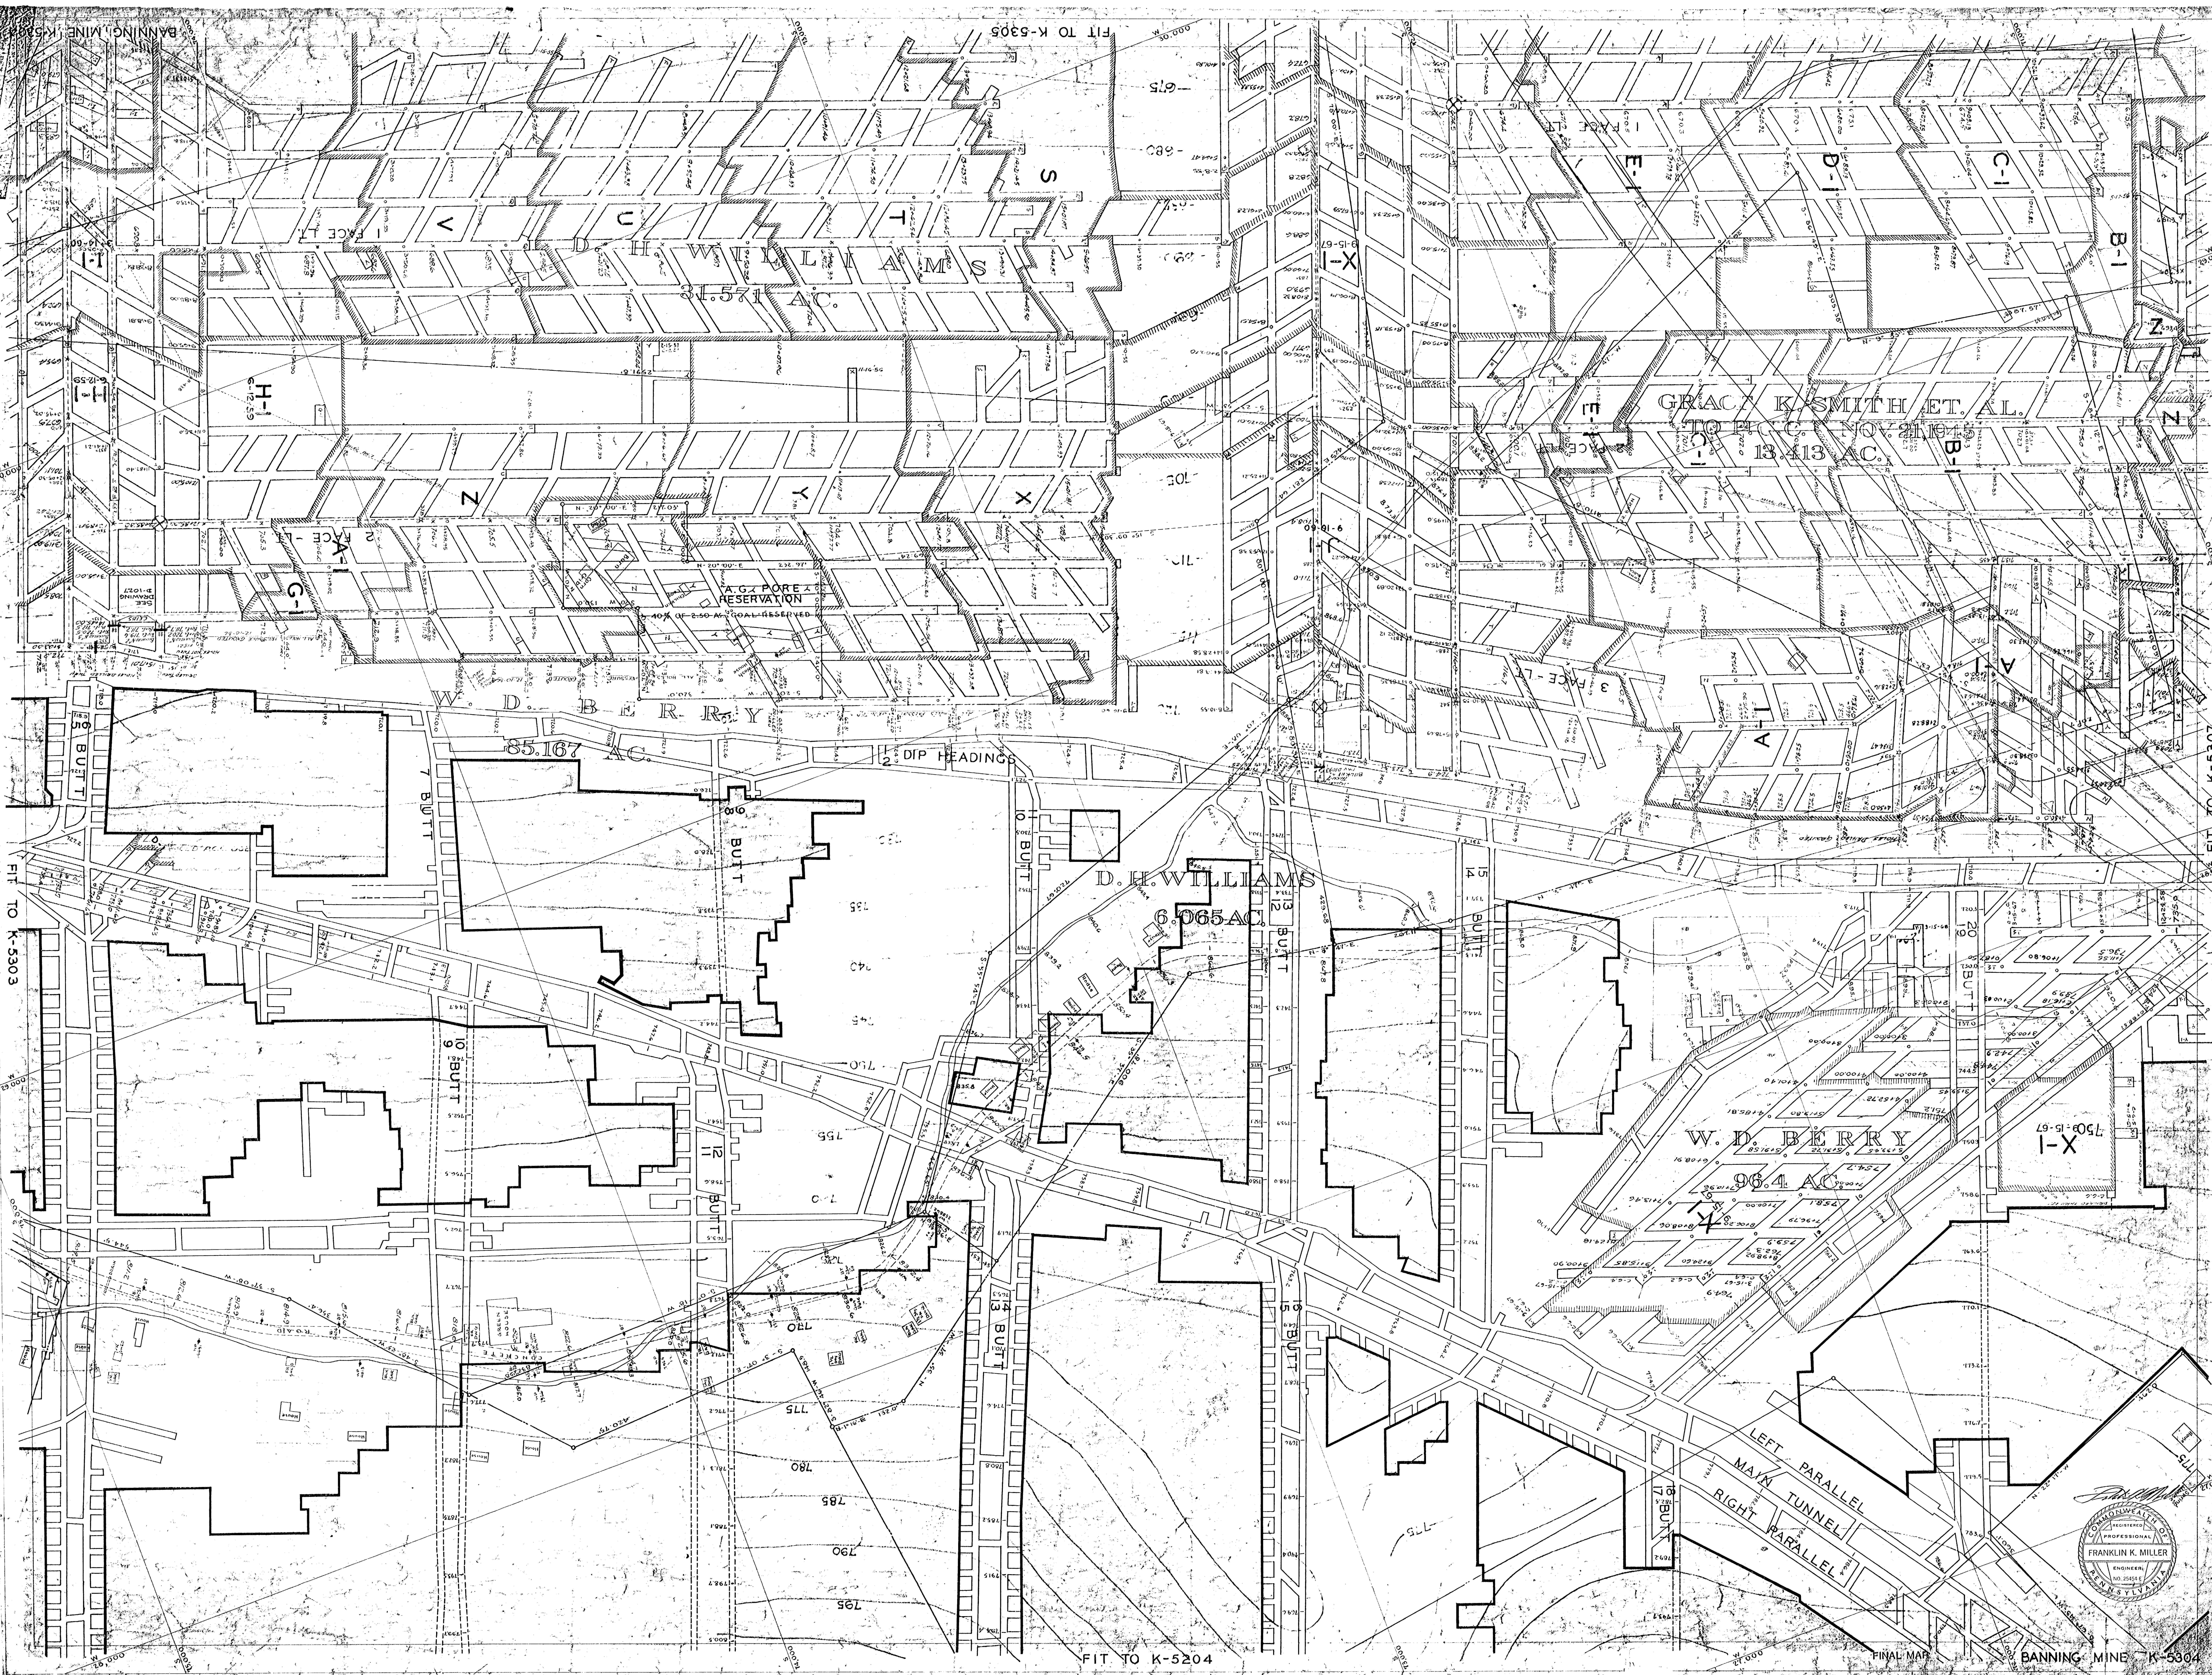


BANNING MINE K-5303

FT TO K-5303

FIT TO K-5204

FIT TO K-5307

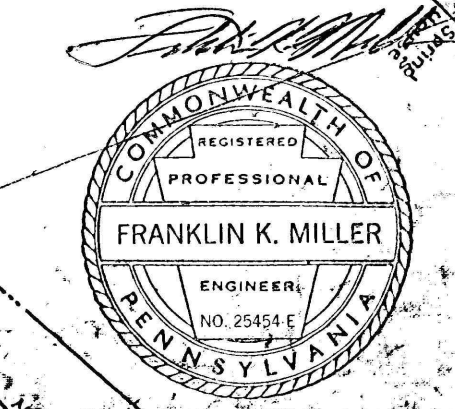

BANNING MINE K-5304