


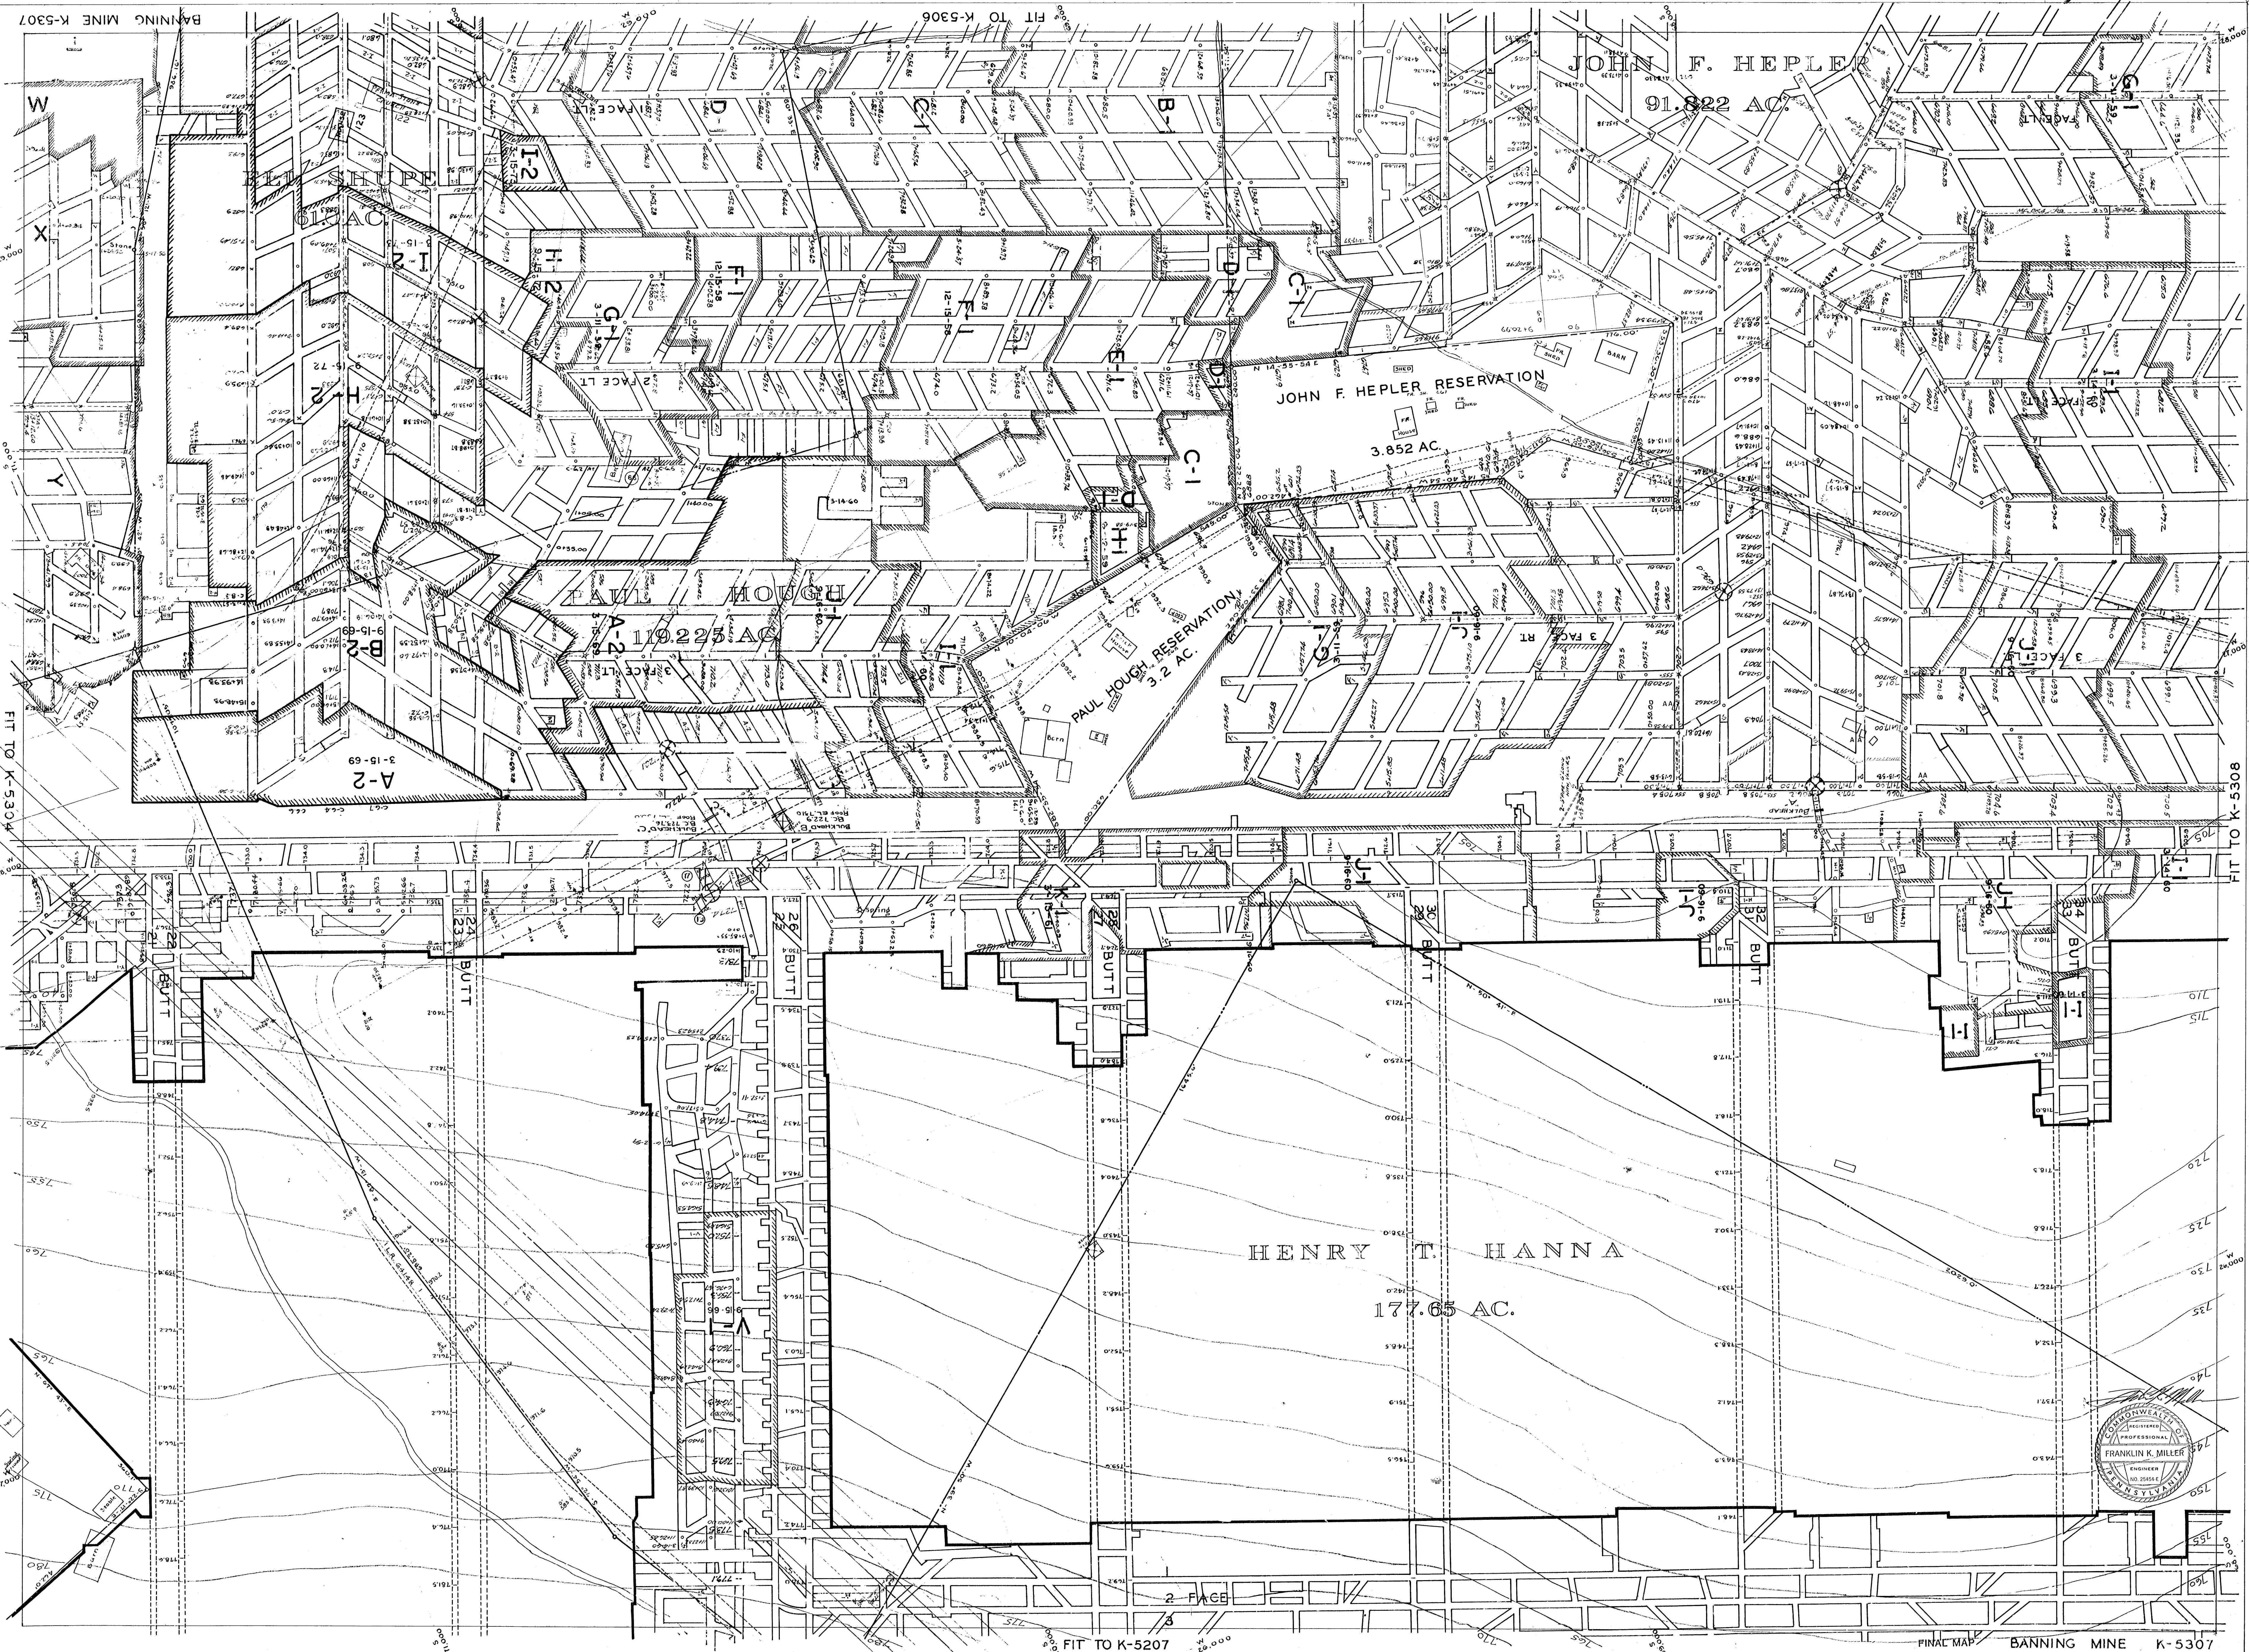

BANNING MINE K-5307

FIT TO K-5304

FIT TO K-5306

JOHN F. HEPLER
91.822 AC.

JOHN F. HEPLER RESERVATION
3.852 AC.

PAUL HUGH RESERVATION
9.2 AC.

HENRY T. HANNA
177.65 AC.



FIT TO K-5207

FINAL MAP BANNING MINE K-5307