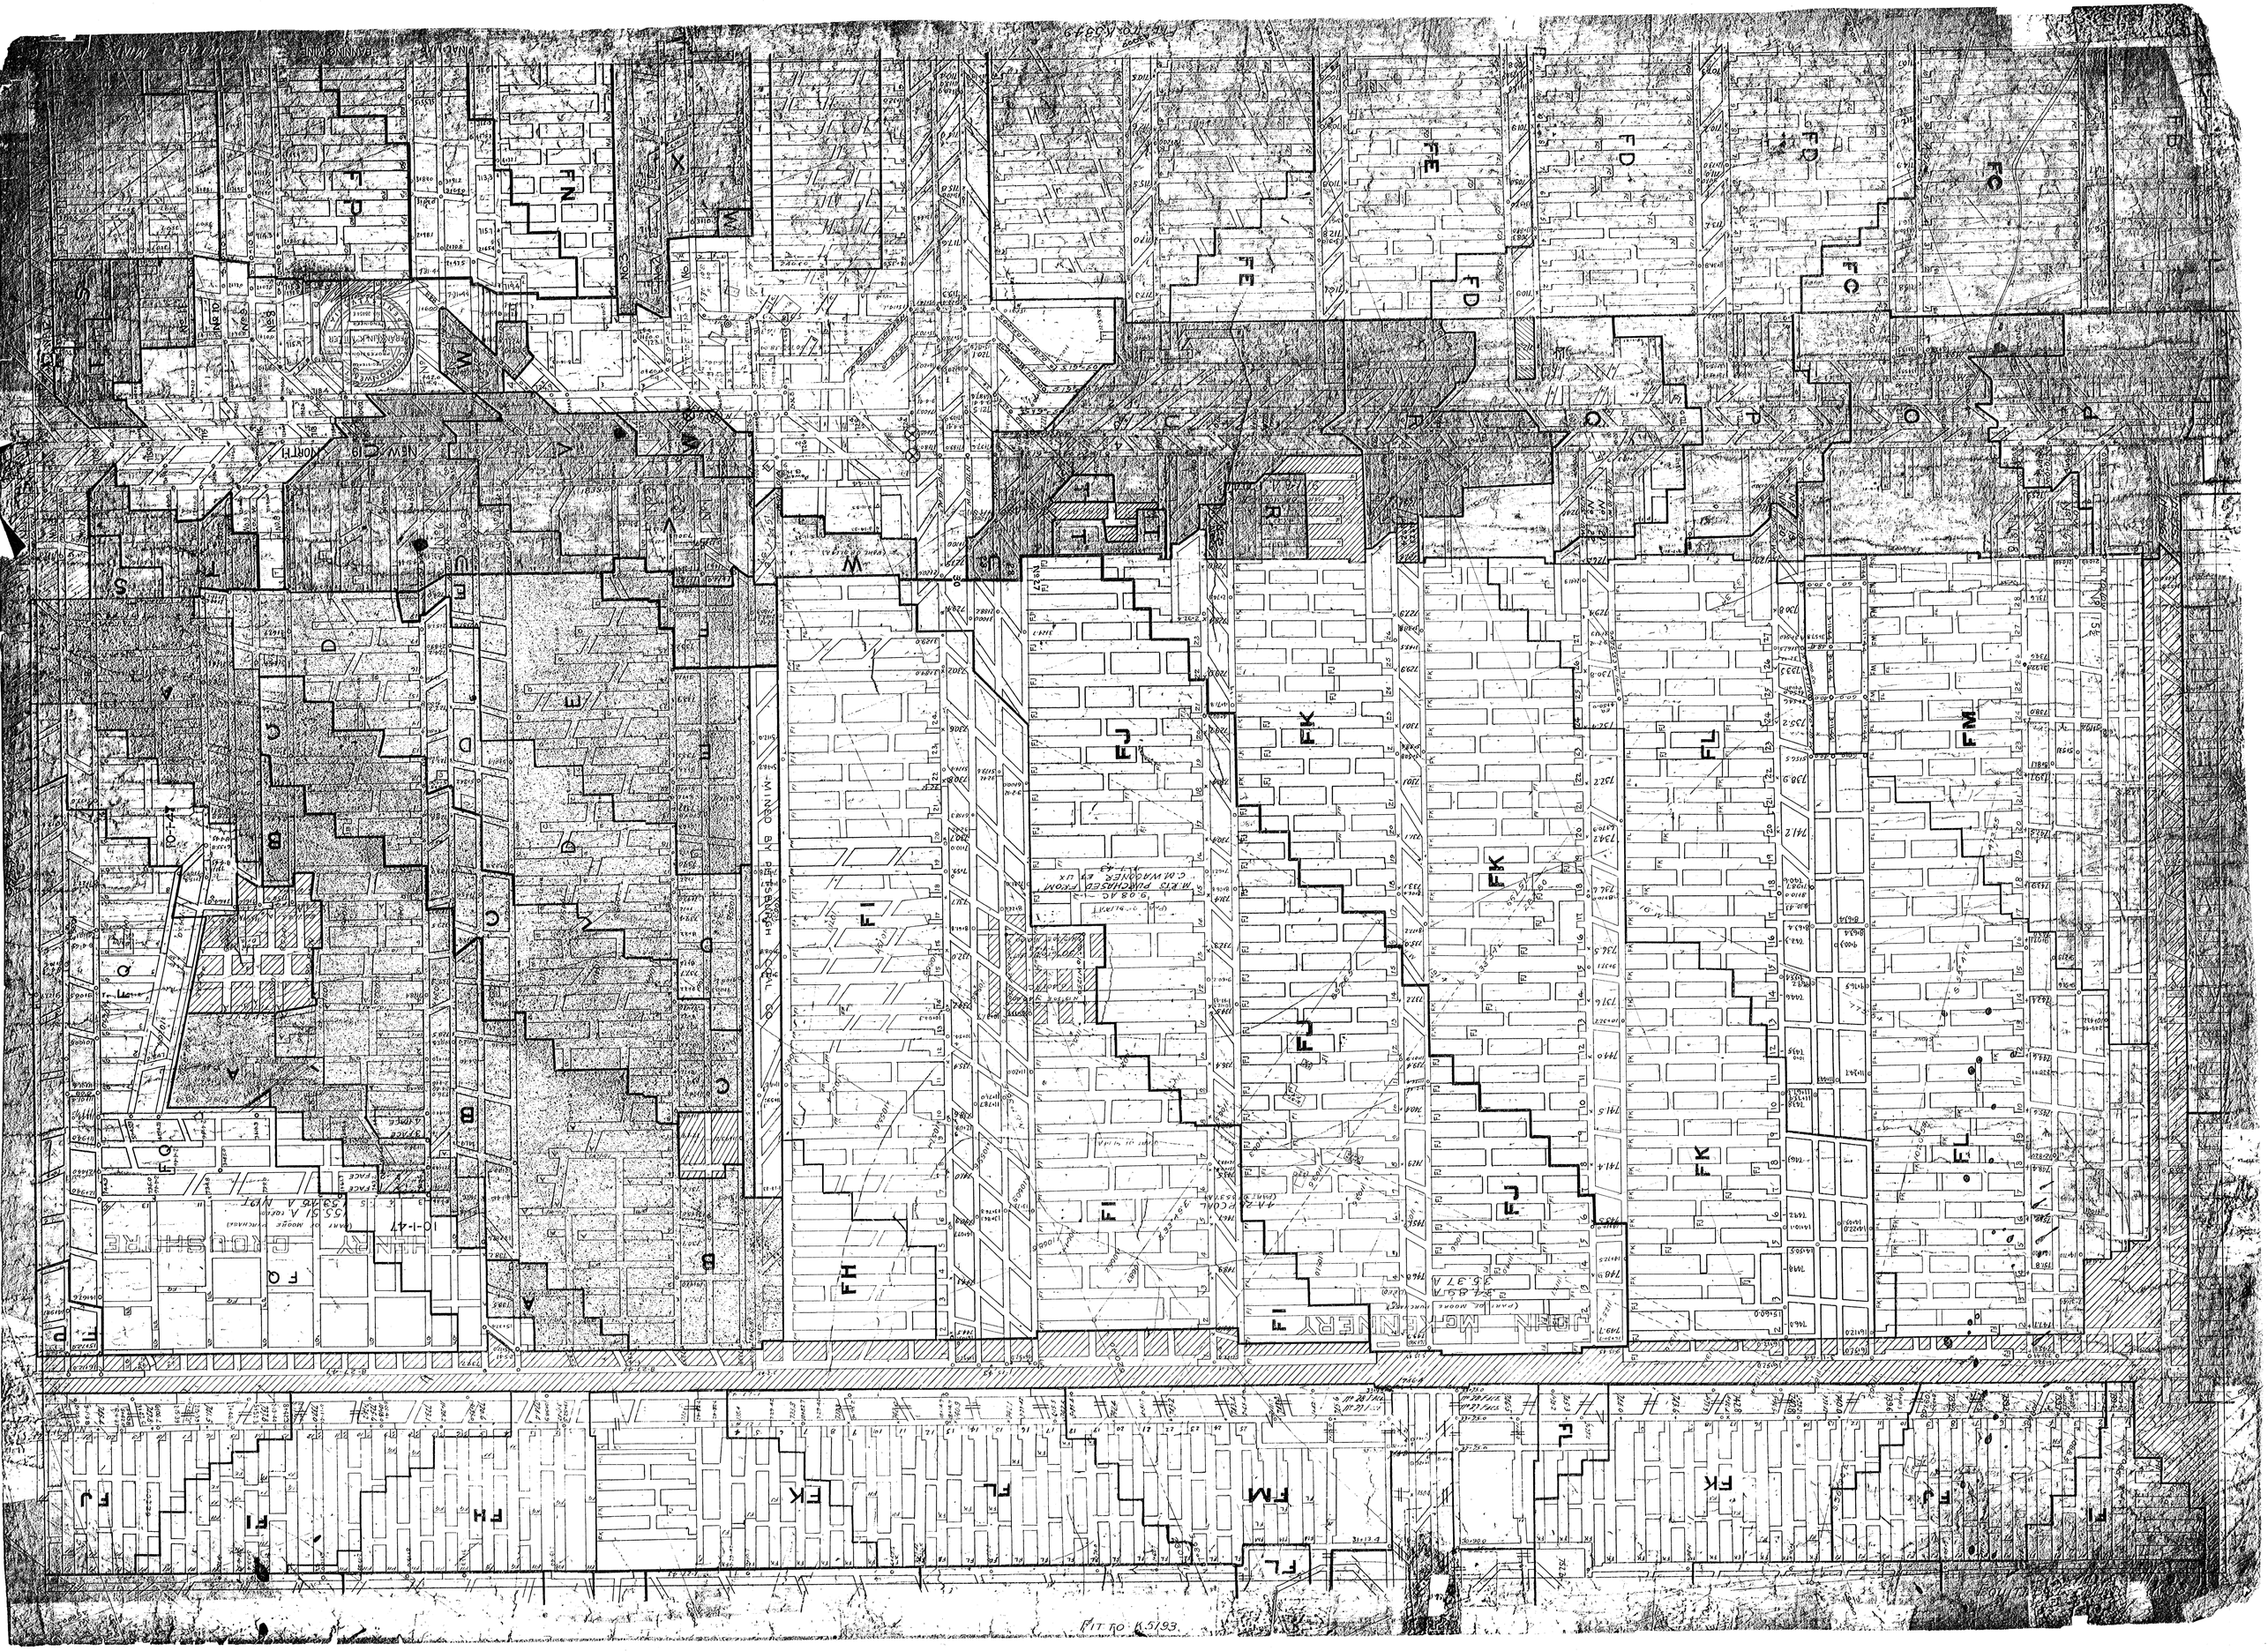

FIT TO K5193
FI
FJ
FK
FL
FM
FH
FI
FJ
JOHN McKENNERY
(PART OF MOORE PURCHASE)
34.89 A (DEED)
35.37 A
4 A. 26 P. COAL (PART OF 35.37 A)
9.08 AC
M. RTS PURCHASED FROM C. M. WAGONER ET UX 1-7-43
HENRY CROUSHORE
(PART OF MOORE PURCHASE)
155.51 A. (DEED)
153.45 A. NET
10-1-47
FQ
FP
MINED BY PITTSBURGH COAL CO.
A
B
C
D
E
F
U
V
W
S
T
R
H
P
O
Q
NEW C 19 NORTH
No 27
FC
FD
FE
FN
FP
X
FB
No. 3
No. 4
No. 8
No. 9
No. 10
FRANKLIN K. MILLER
NO. 28454-E
FIT TO K5349

FINAL MAP BANNING MINE

EQUITABLE MINE K-53