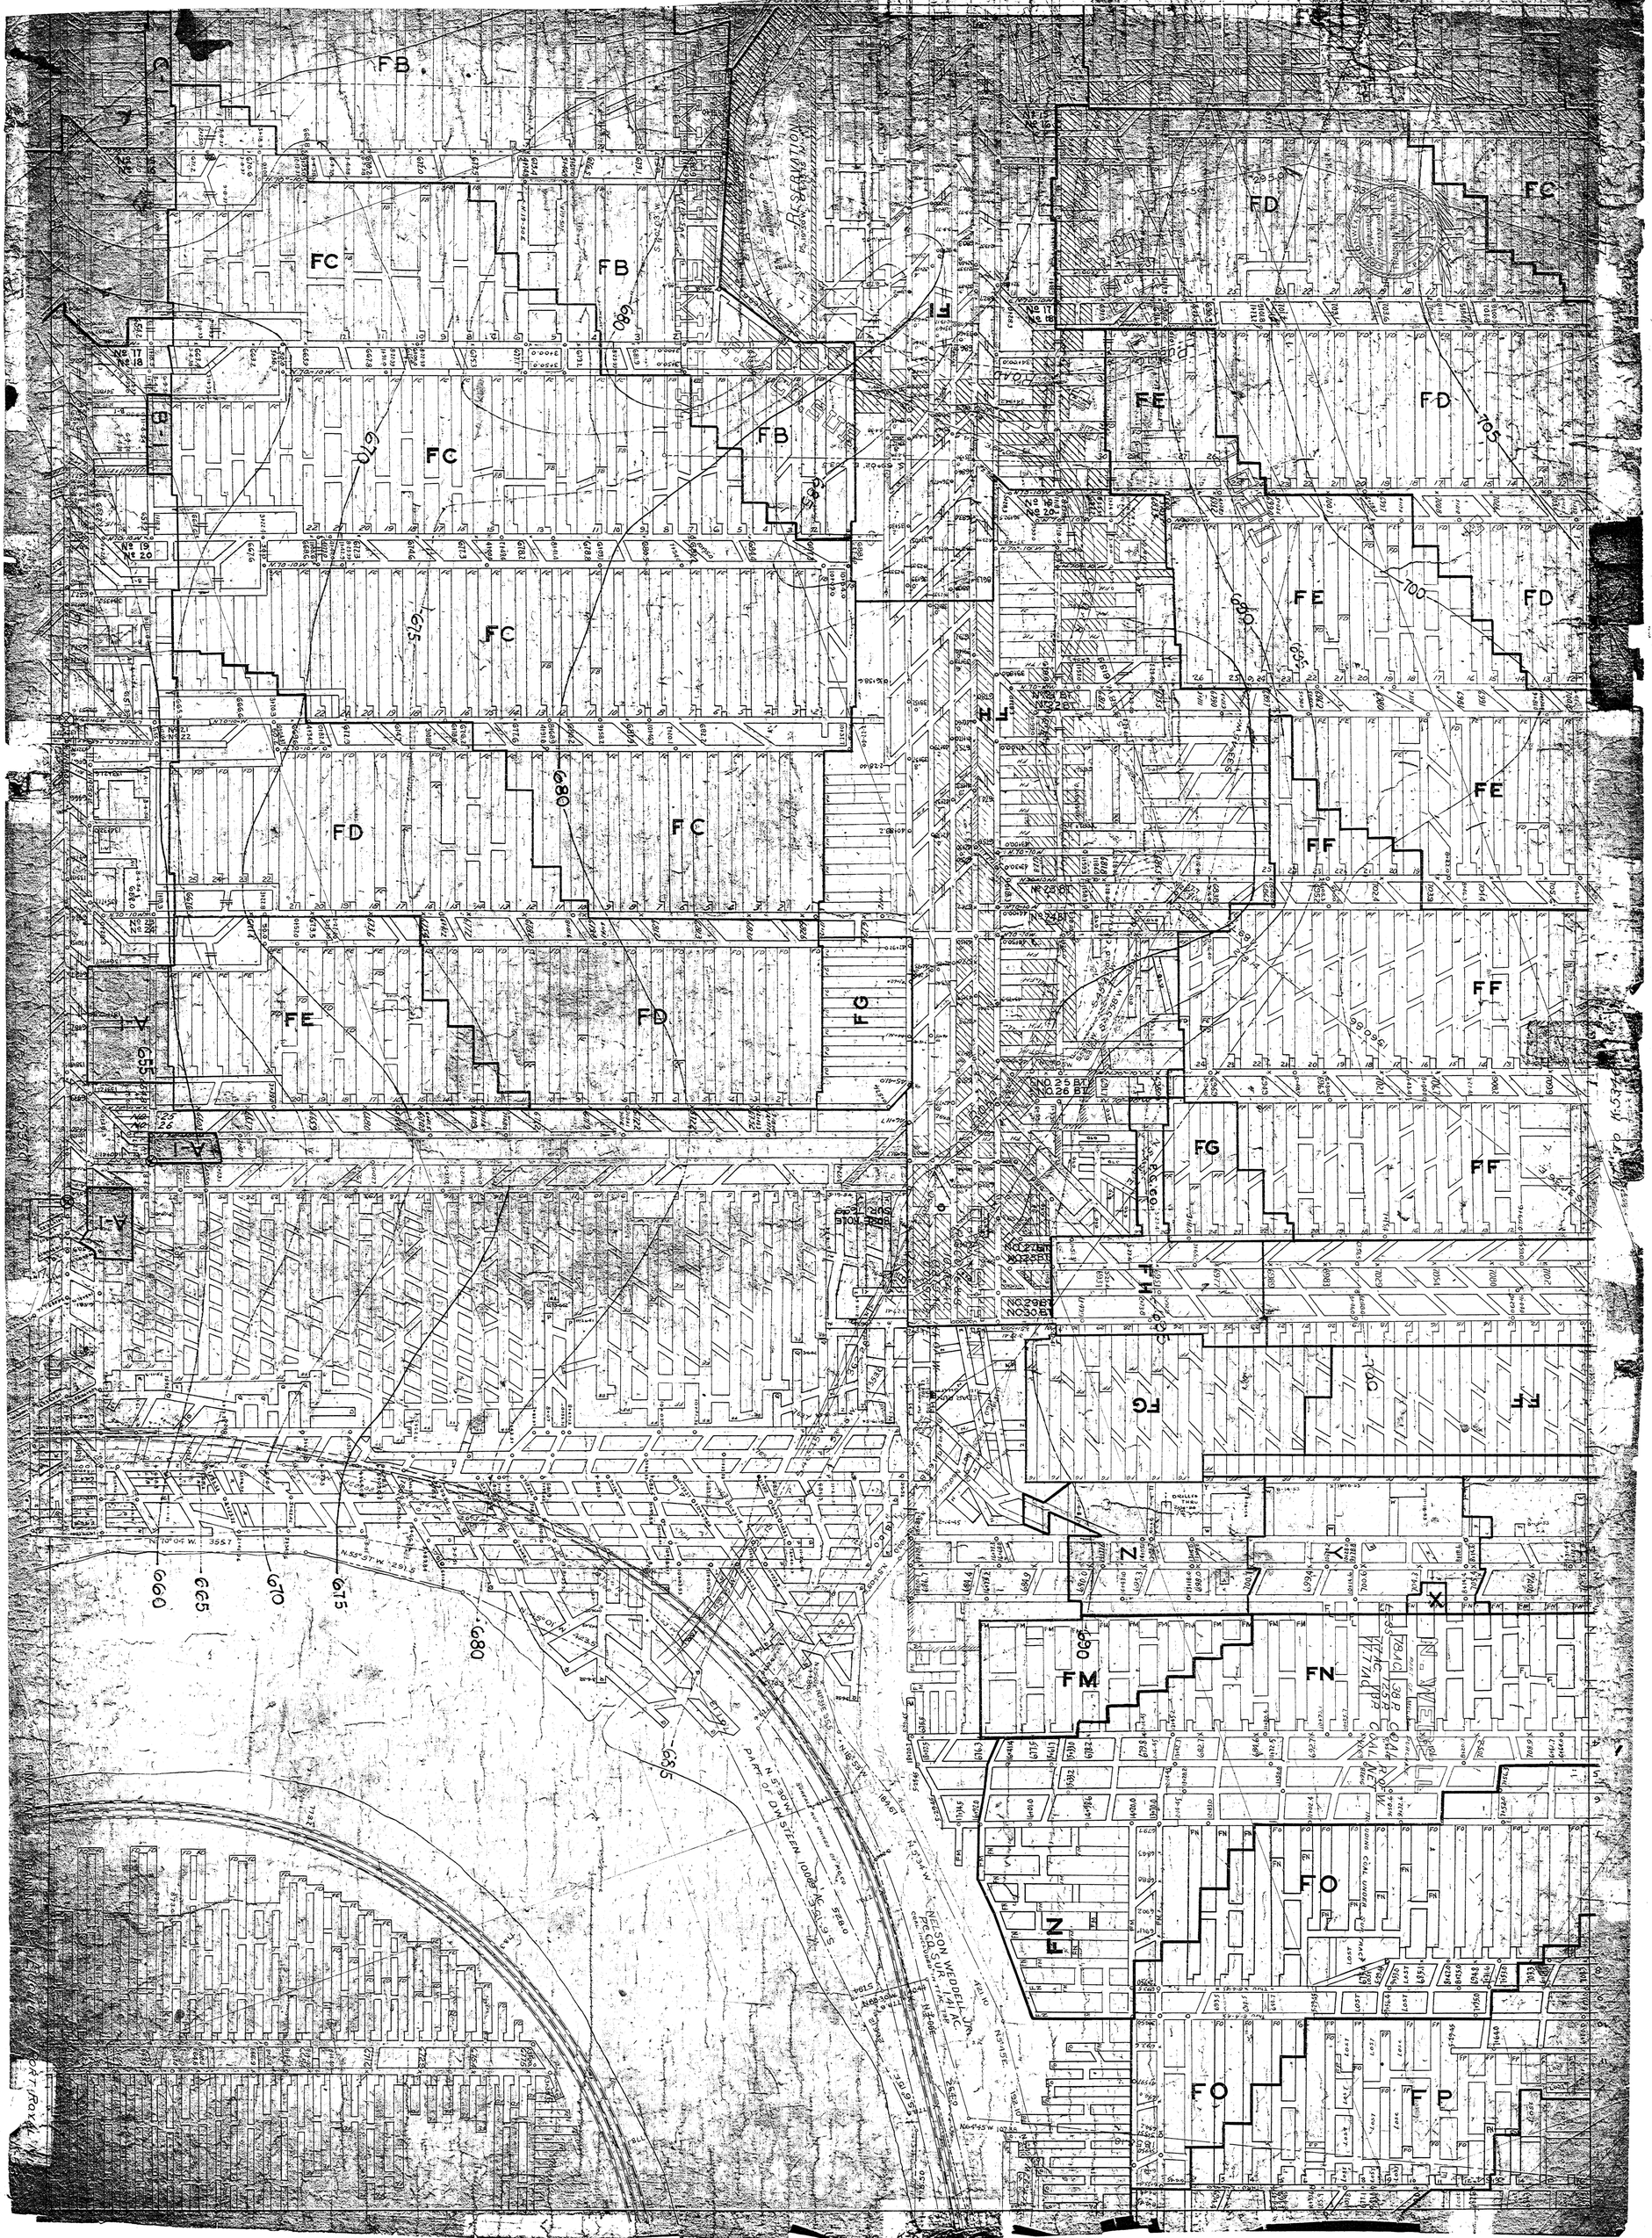FC
FD
FE
FF
FG
FH
FB
FM
FN
FO
FP
X
Y
Z
N. WEDELL
78 AC. 38 P. COAL
77 AC. 73 P. COAL NET
77.77 AC.
INCLUDING COAL UNDER SUR. TRACT
NELSON WEDDELL JR.
P.C.CO. SUR. 1.41 AC.
SURFACE NOT OWNED BY P.C.CO.
N. 5°30' W.
PART OF D.W. STEEN 10.089 AC.
528.0
D.W. STEEN
P.C.CO.
RESERVATION
SAMUEL SMITH
705
700
695
690
685
680
675
670
665
660
655
A-1
B-1
C-1
FINAL MAP
BANNING MINE
EUCLID & PORT ROYAL