


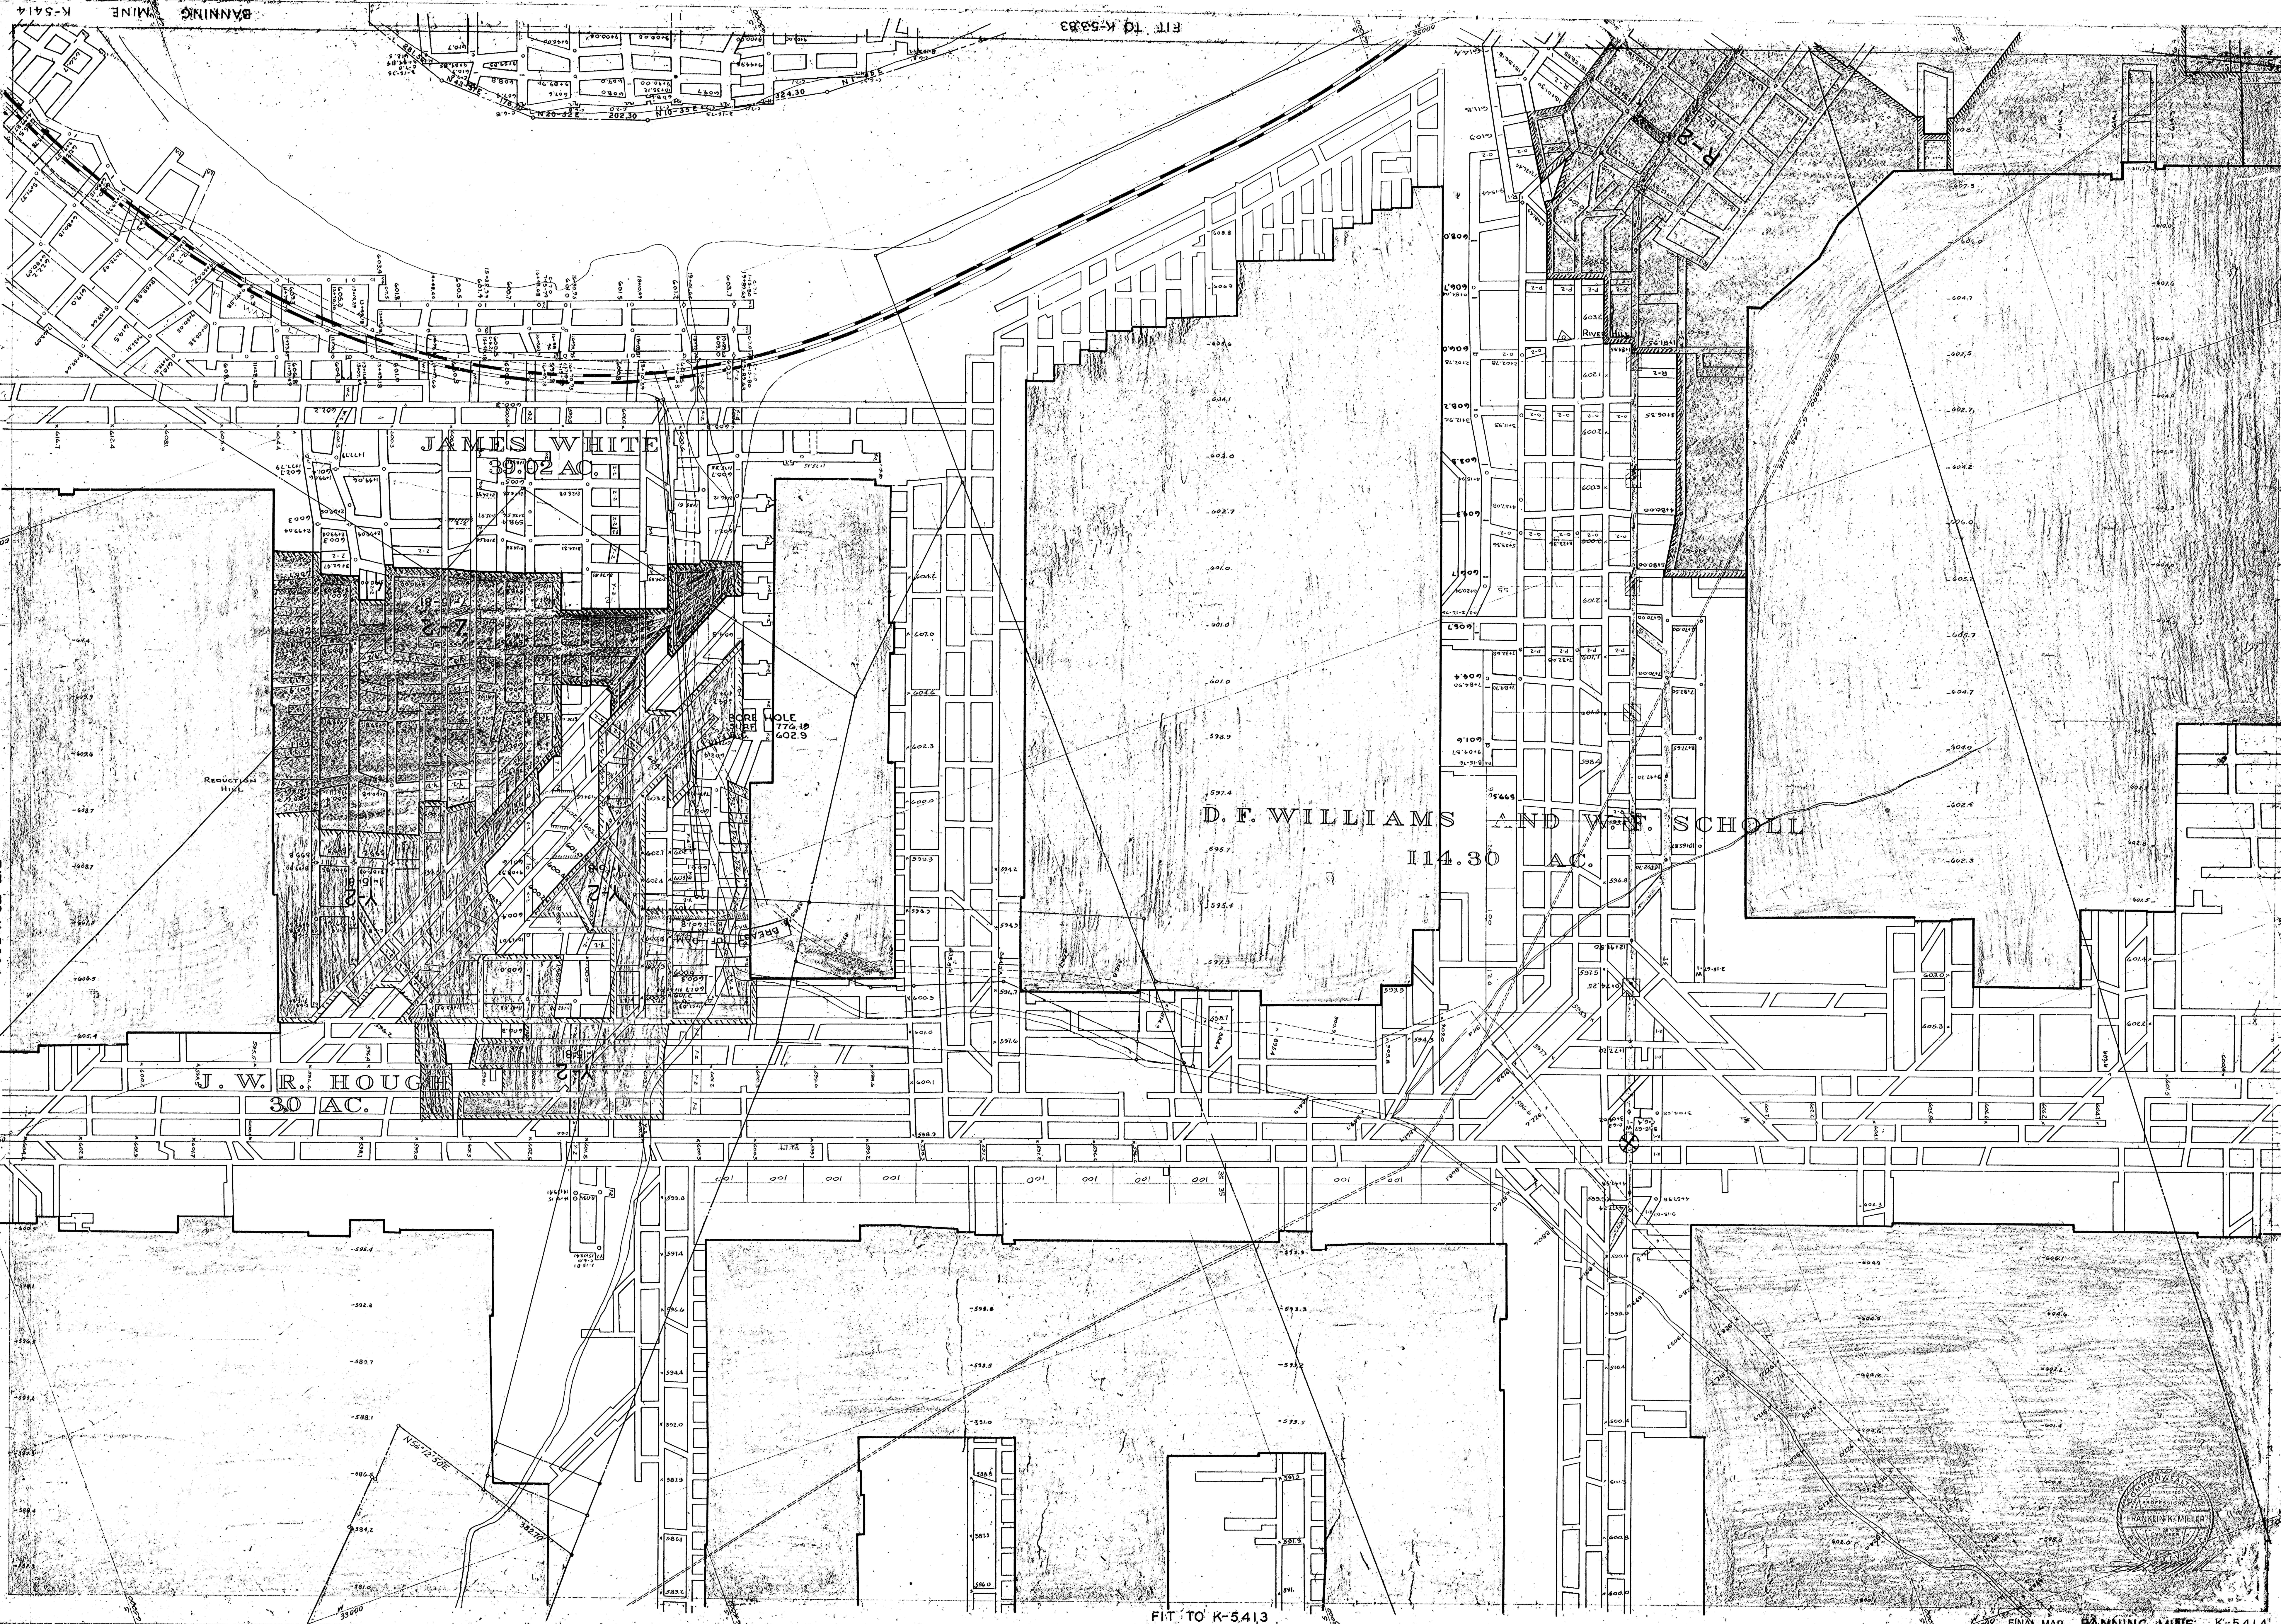

K-5414

FT. TO K-5413

FT. TO K-5361

FT. TO K-5294

FT. TO K-5413

FINAL MAP BANNING MINE K-5414