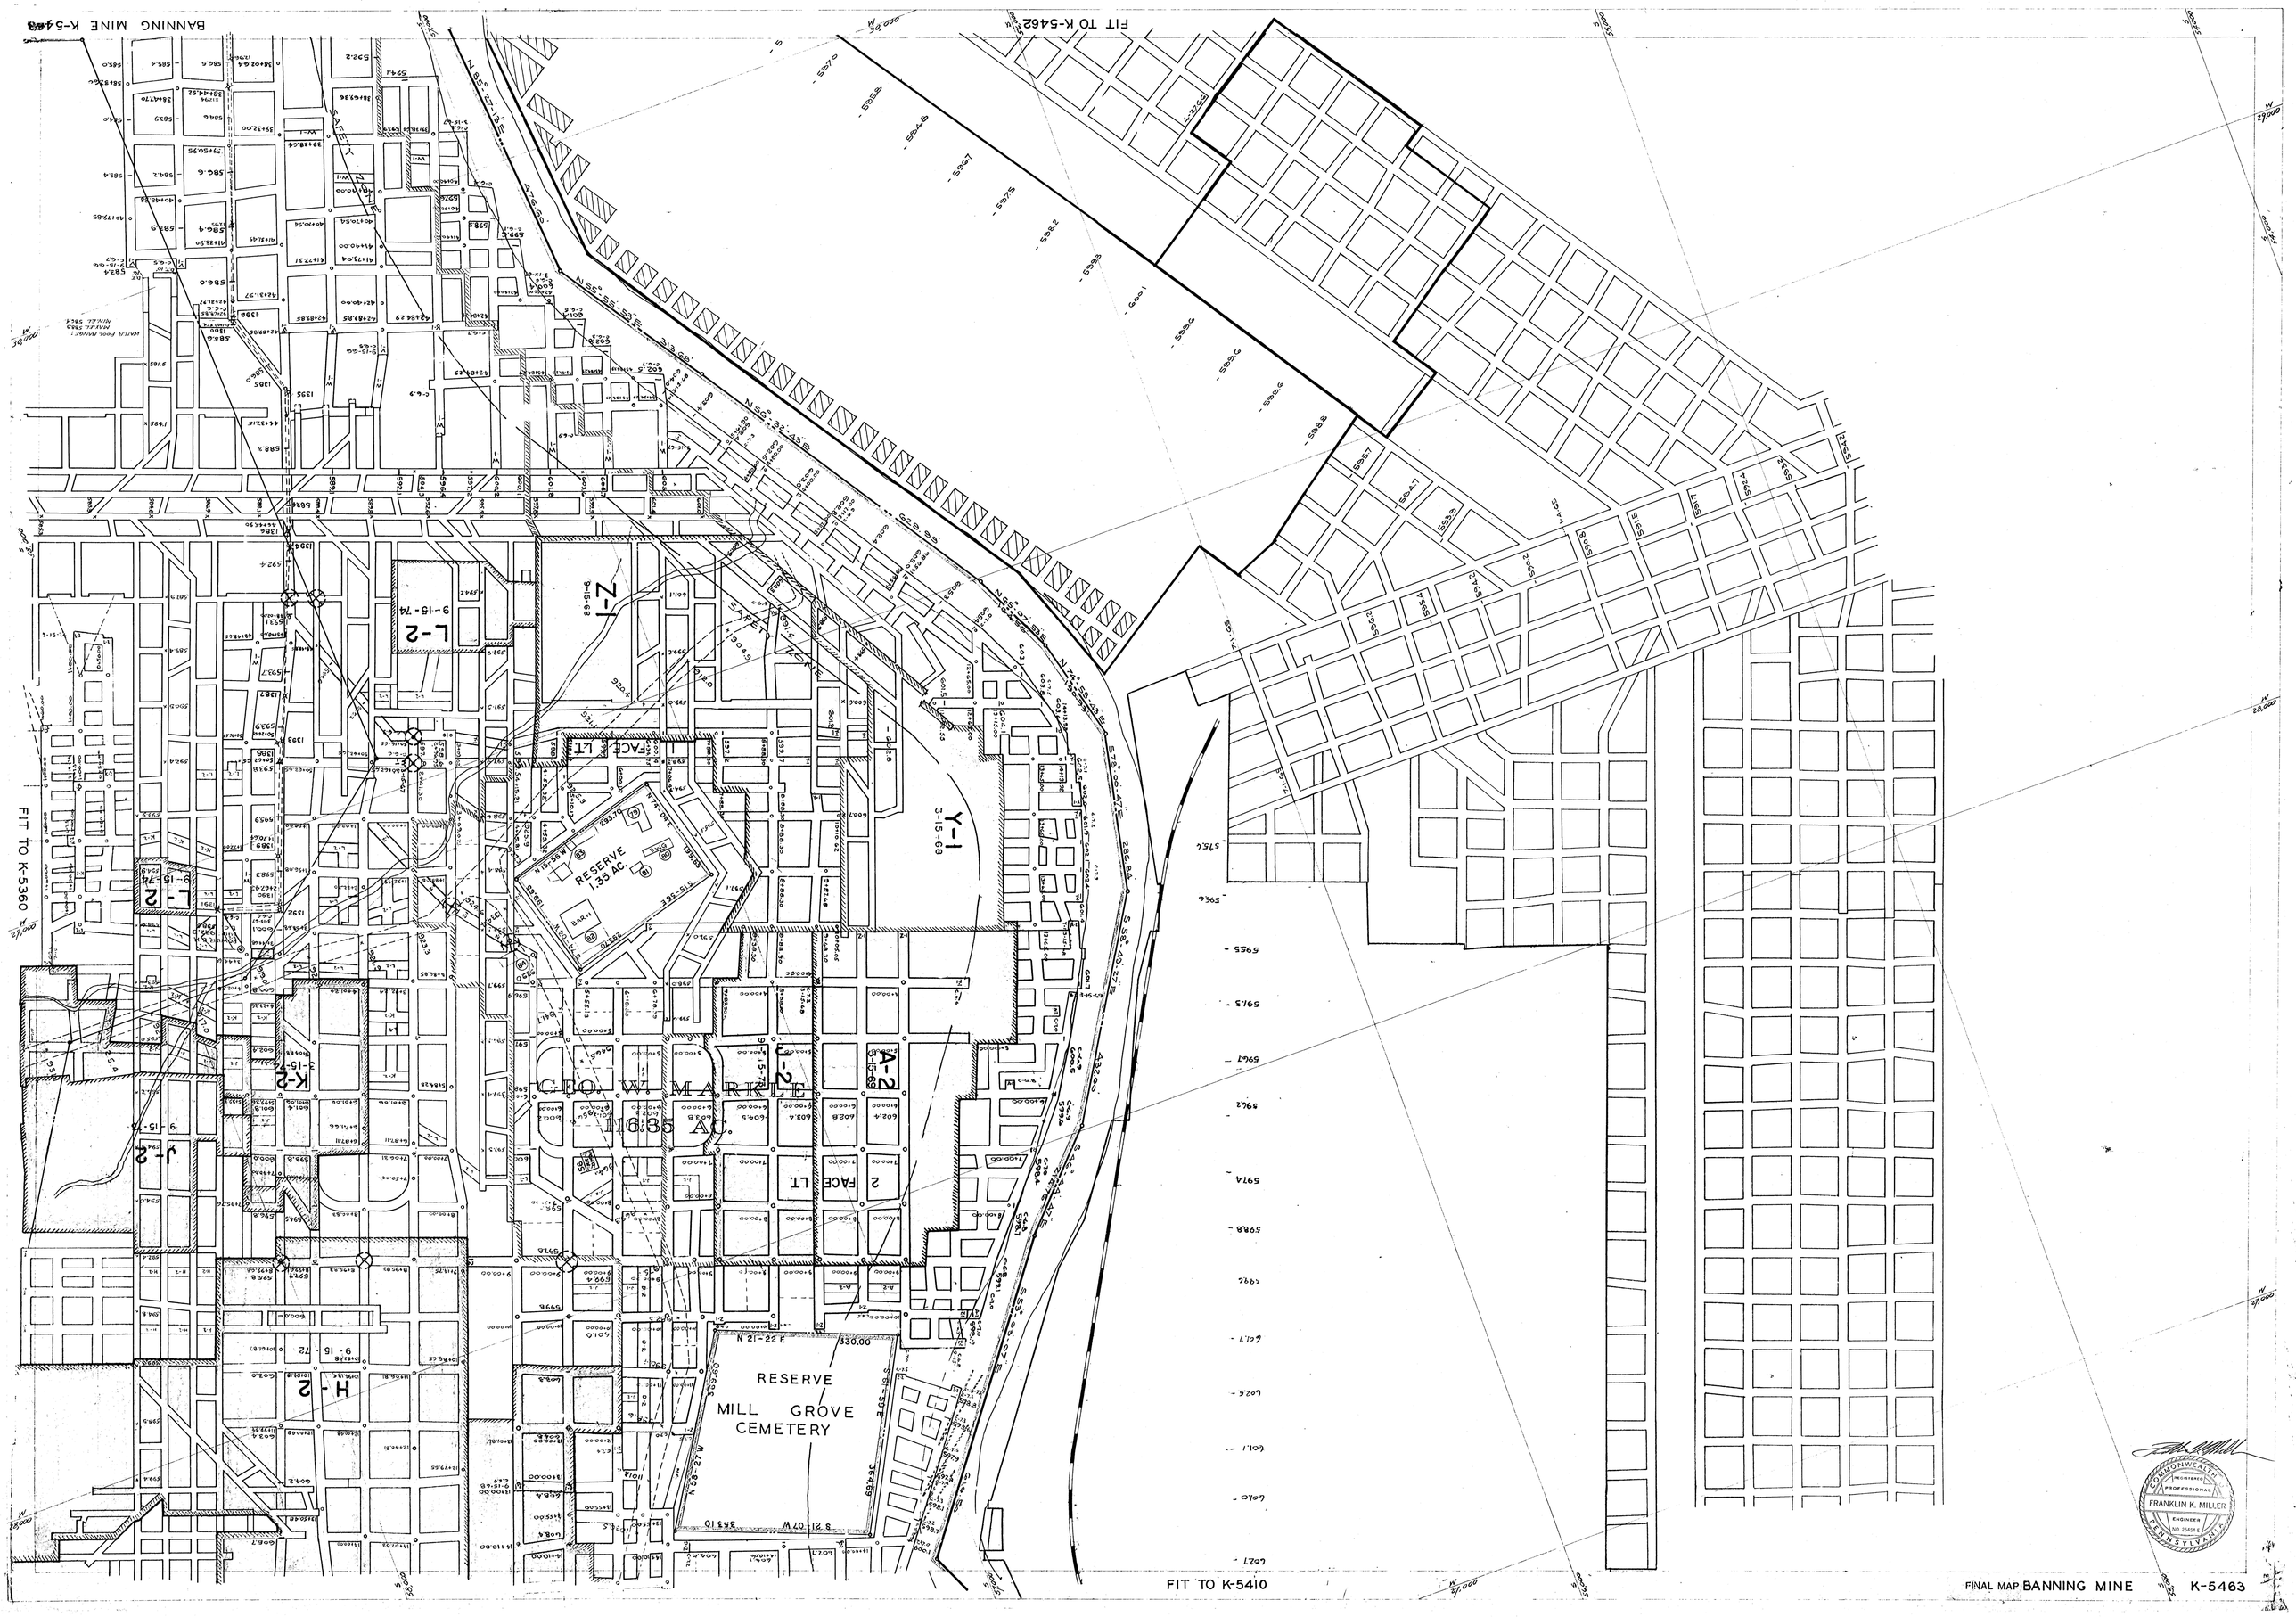
BANNING MINE K-5462
FIT TO K-5462
FIT TO K-5360
FIT TO K-5410
GEO. W. MARKLE
11635 AC.
RESERVE
1.35 AC.
RESERVE
MILL GROVE
CEMETERY
SAFETY
Y-1
3-15-68
Z-1
9-15-68
L-2
9-15-74
J-2
A-2
K-2
H-2
FACE LT
N 21-22 E
330.00
S 21-07 W
N 55-55 E
