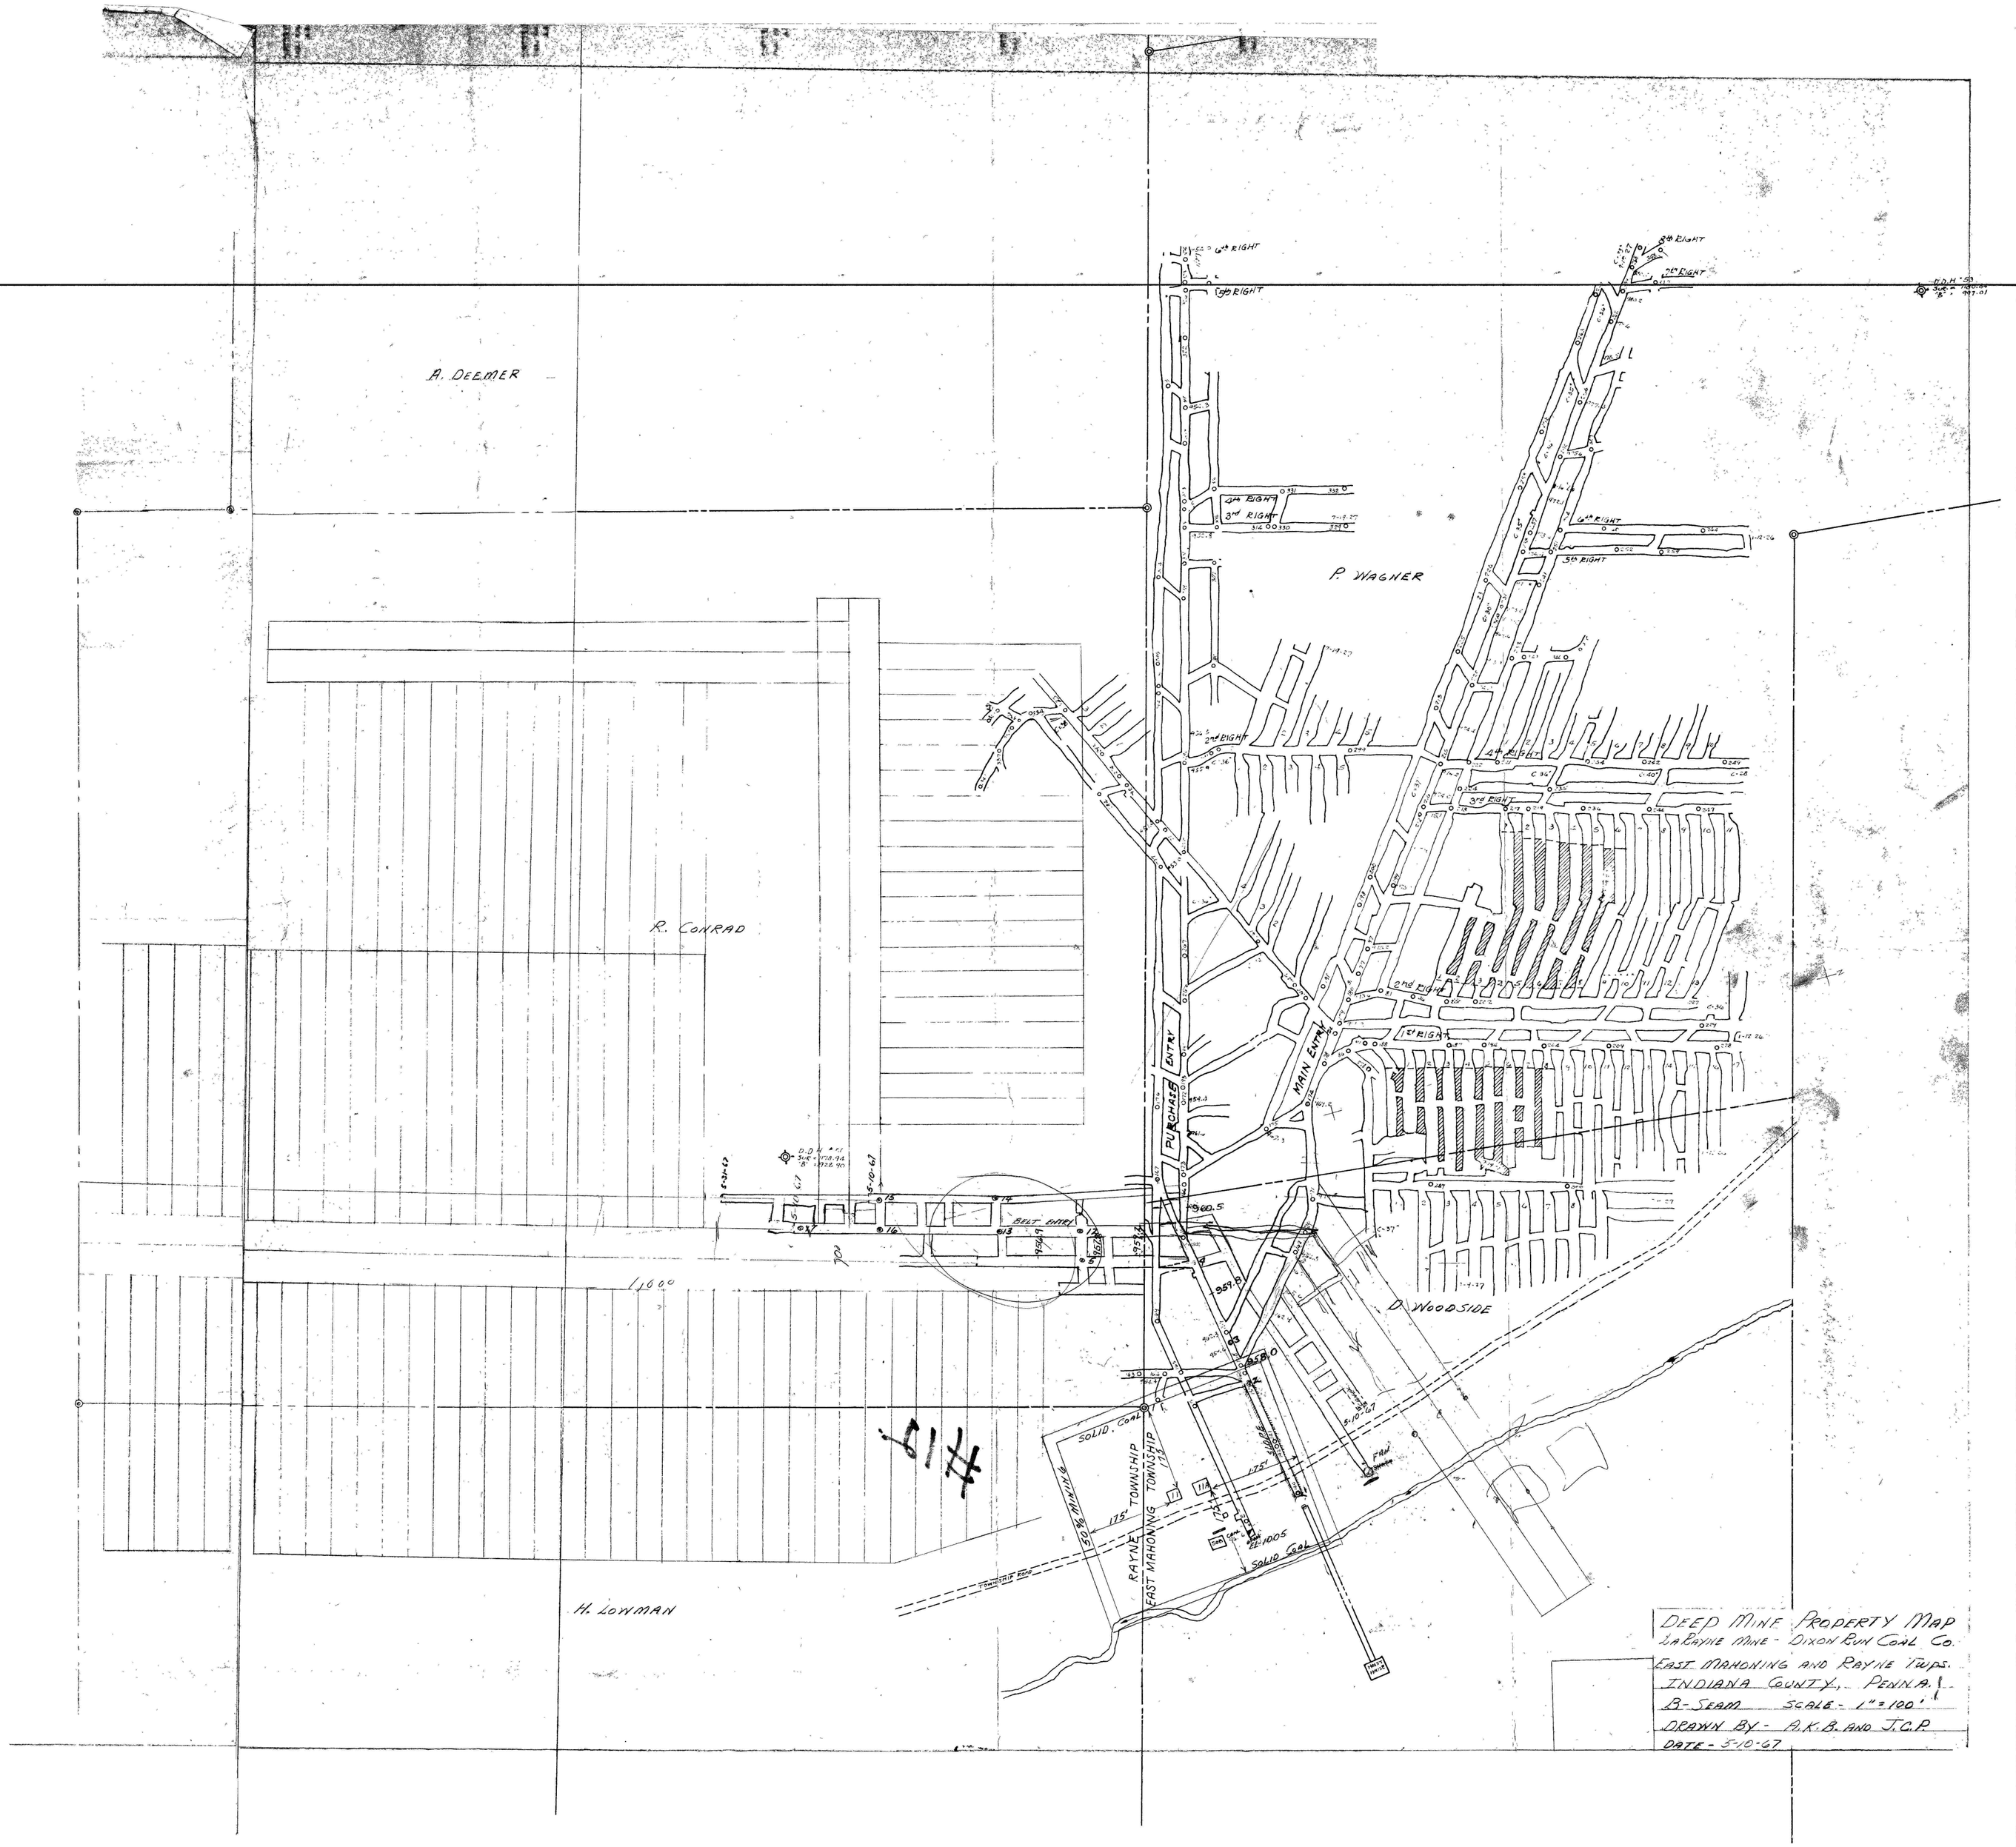
A. DEEMER
R. CONRAD
H. LOWMAN
P. WAGNER
D. WOODSIDE
6th RIGHT
5th RIGHT
4th RIGHT
3rd RIGHT
2nd RIGHT
1st RIGHT
8th RIGHT
7th RIGHT
PURCHASE ENTRY
MAIN ENTRY
BELT ENTRY
SOLID. COAL
RAYNE TOWNSHIP
EAST MAHONING TOWNSHIP
TOWNSHIP ROAD
FAN
1600
#19
DEEP MINE PROPERTY MAP
LA RAYNE MINE - DIXON RUN COAL CO.
EAST MAHONING AND RAYNE TWPS.
INDIANA COUNTY, PENNA.
B-SEAM SCALE - 1" = 100'
DRAWN BY - A.K.B. AND J.C.P.
DATE - 5-10-67