


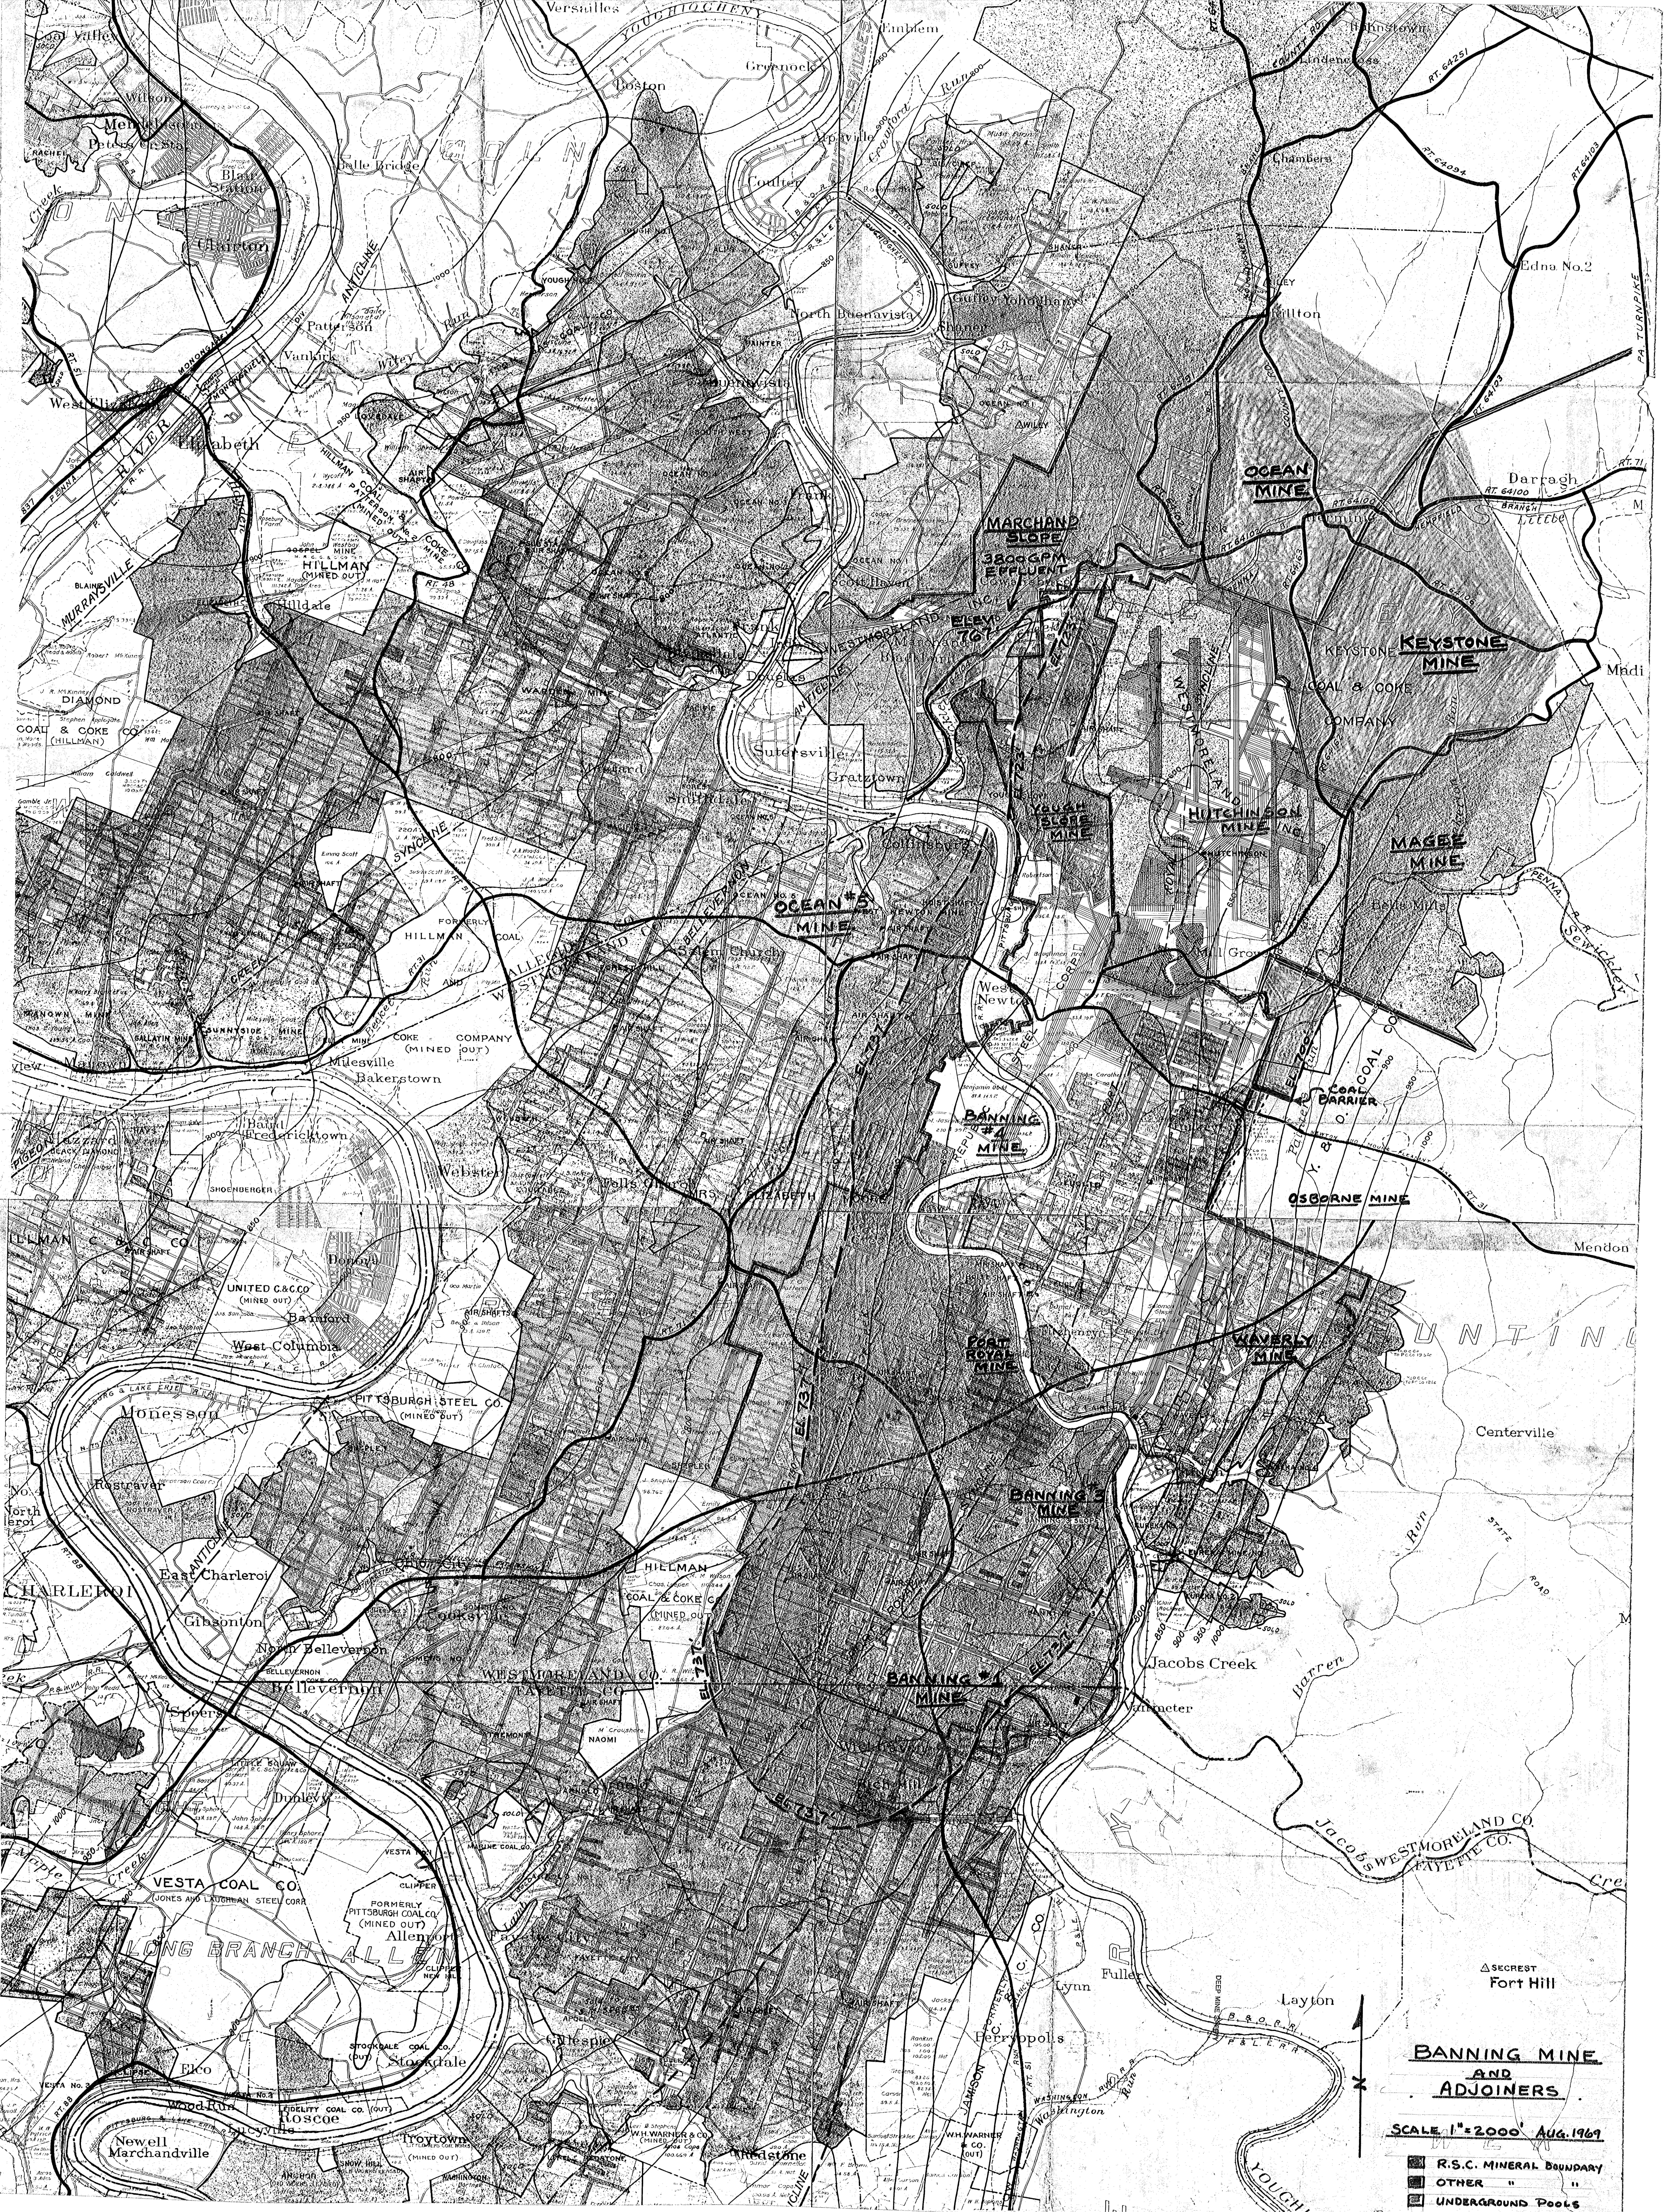

**BANNING MINE
AND
ADJOINERS**

SCALE 1"=2000' AUG. 1969

- R.S.C. MINERAL BOUNDARY
- OTHER " "
- UNDERGROUND POOLS