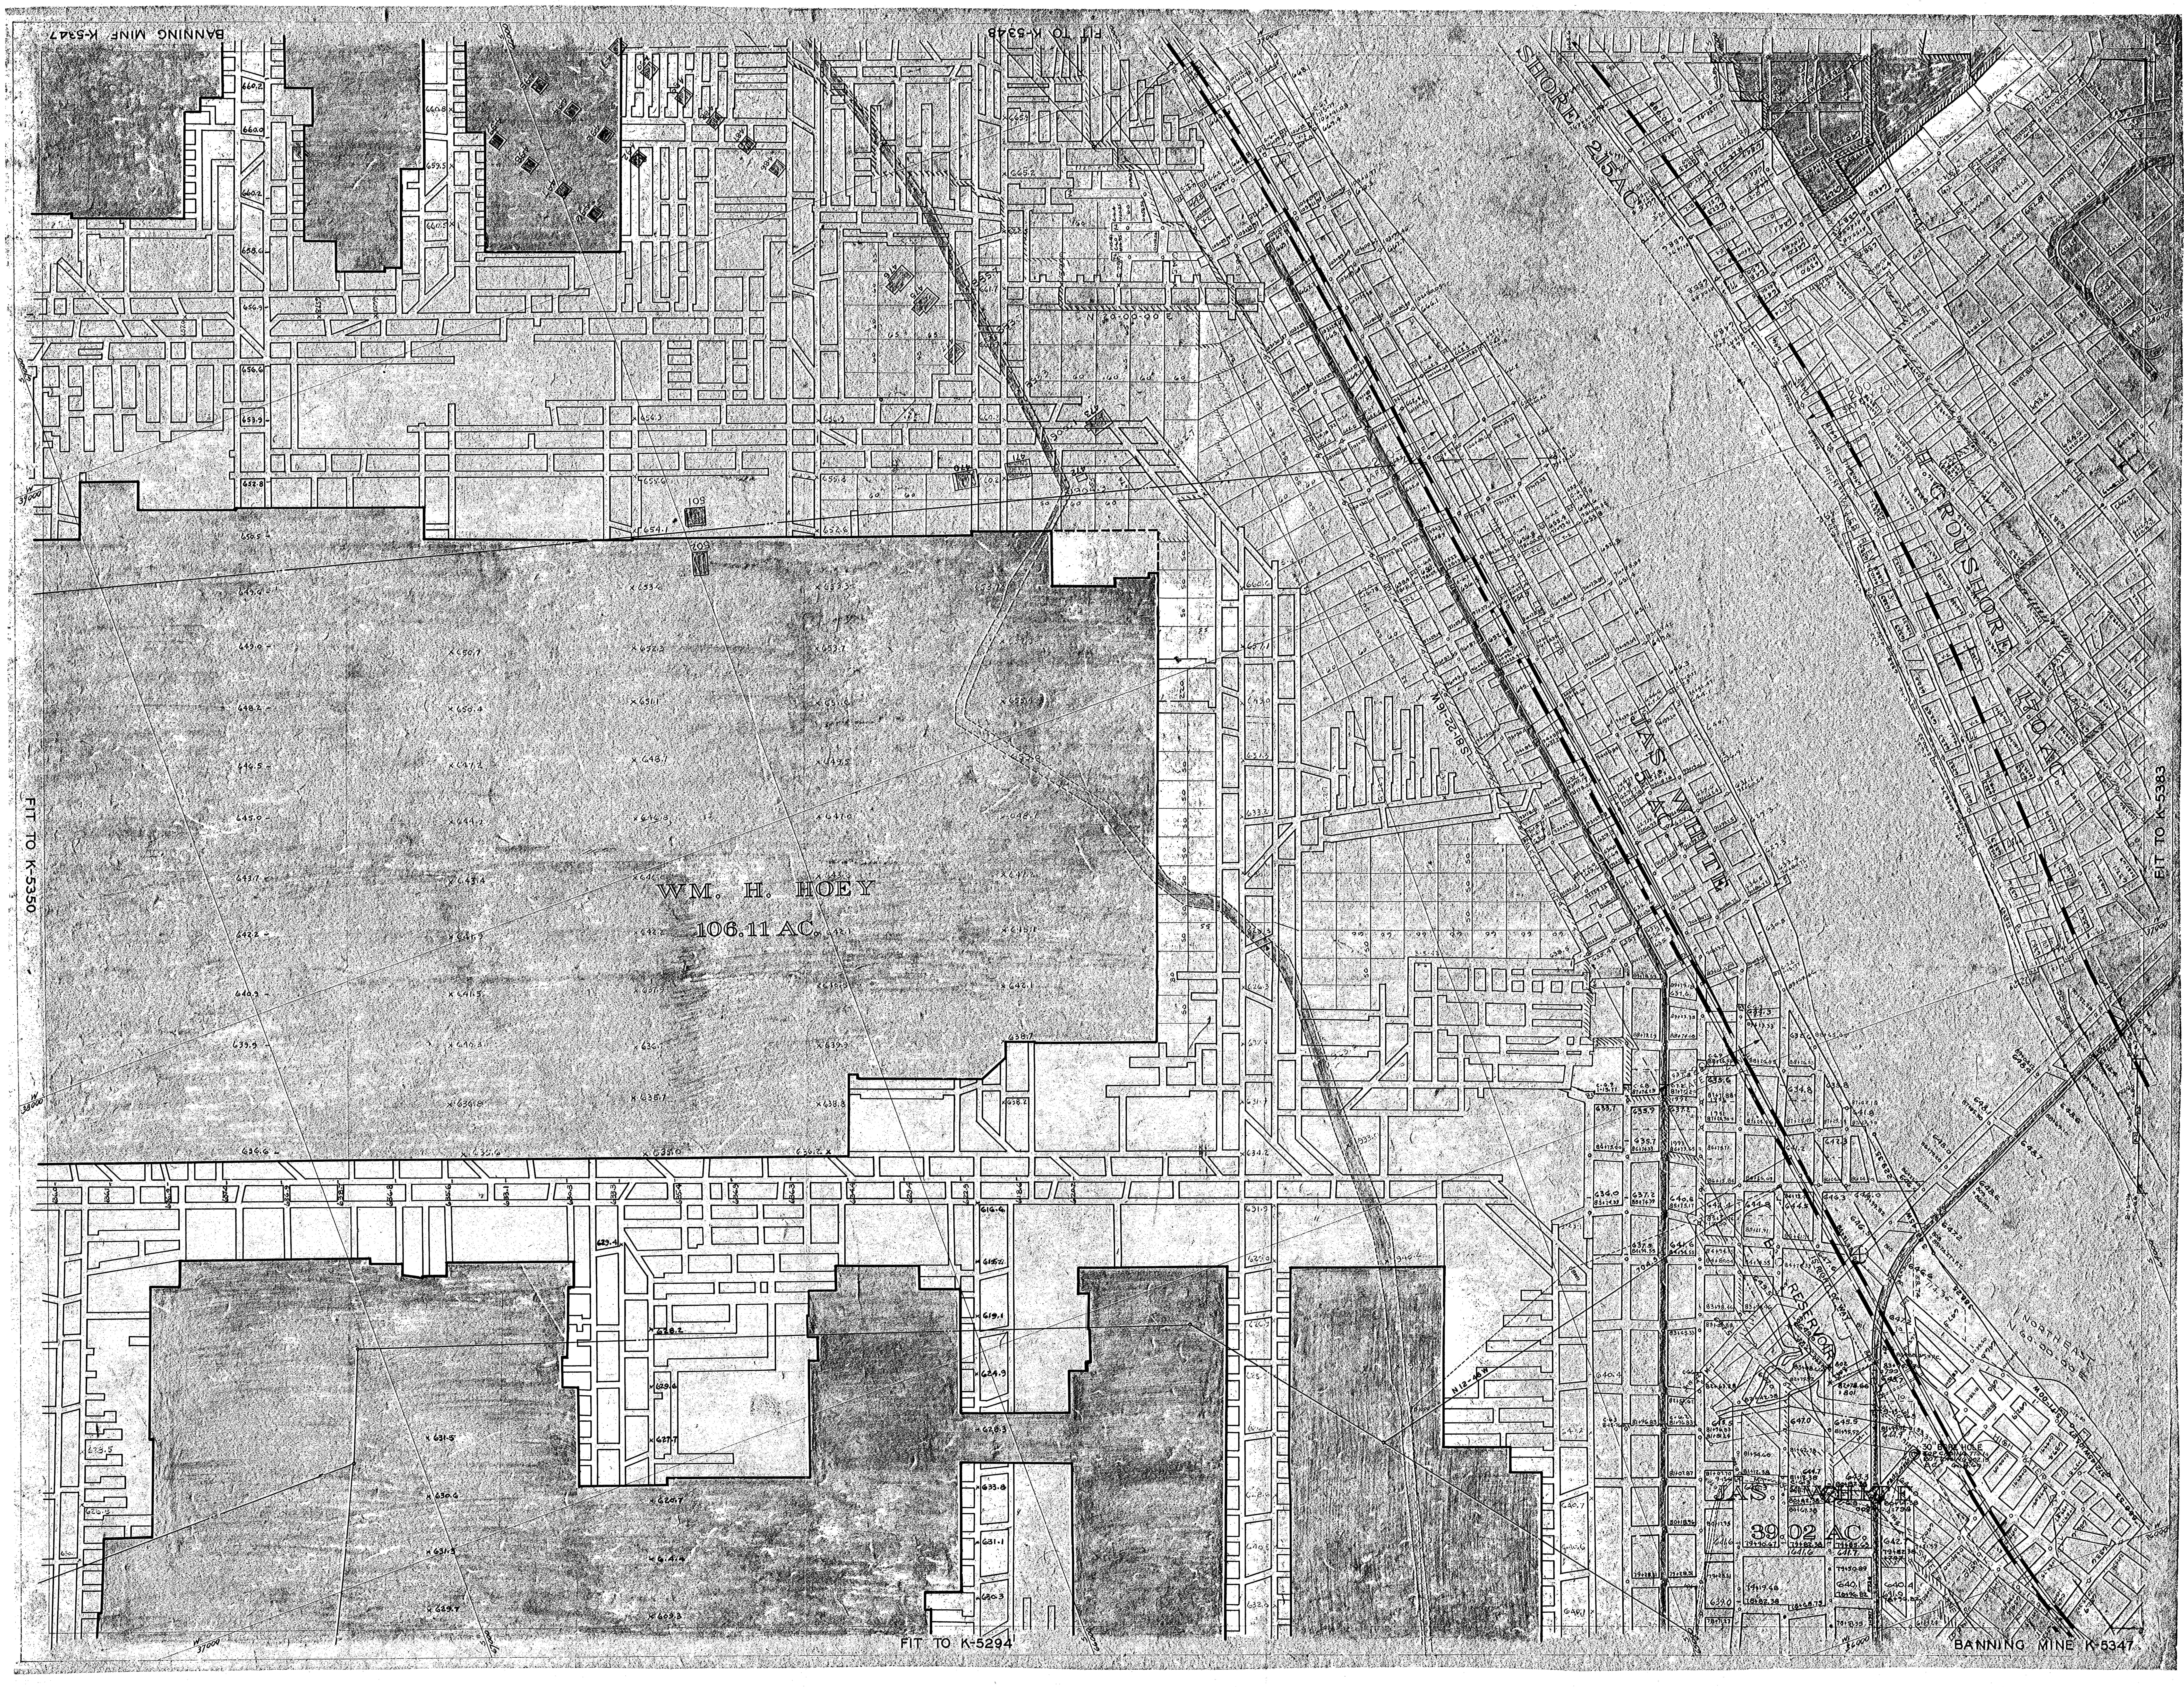
BANNING MINE K-5347
FIT TO K-5348
FIT TO K-5350
FIT TO K-5383
FIT TO K-5294
BANNING MINE K-5347
WM. H. HOEY
106.11 AC.
SHORE 215 AC.
H. CROUSHORE 170 AC.
JAS. WHITE
JAS. WHITE
39.02 AC.
RESERVOIR
NORTHEAST
N 60-00-00 E
N 20-00-00 E
S 81-22-16 W
N 12-48 W
SAFETY ZONE
HIGH WATER LINE
30" BORE HOLE
W 39000
W 38000
W 37000
W 36000