


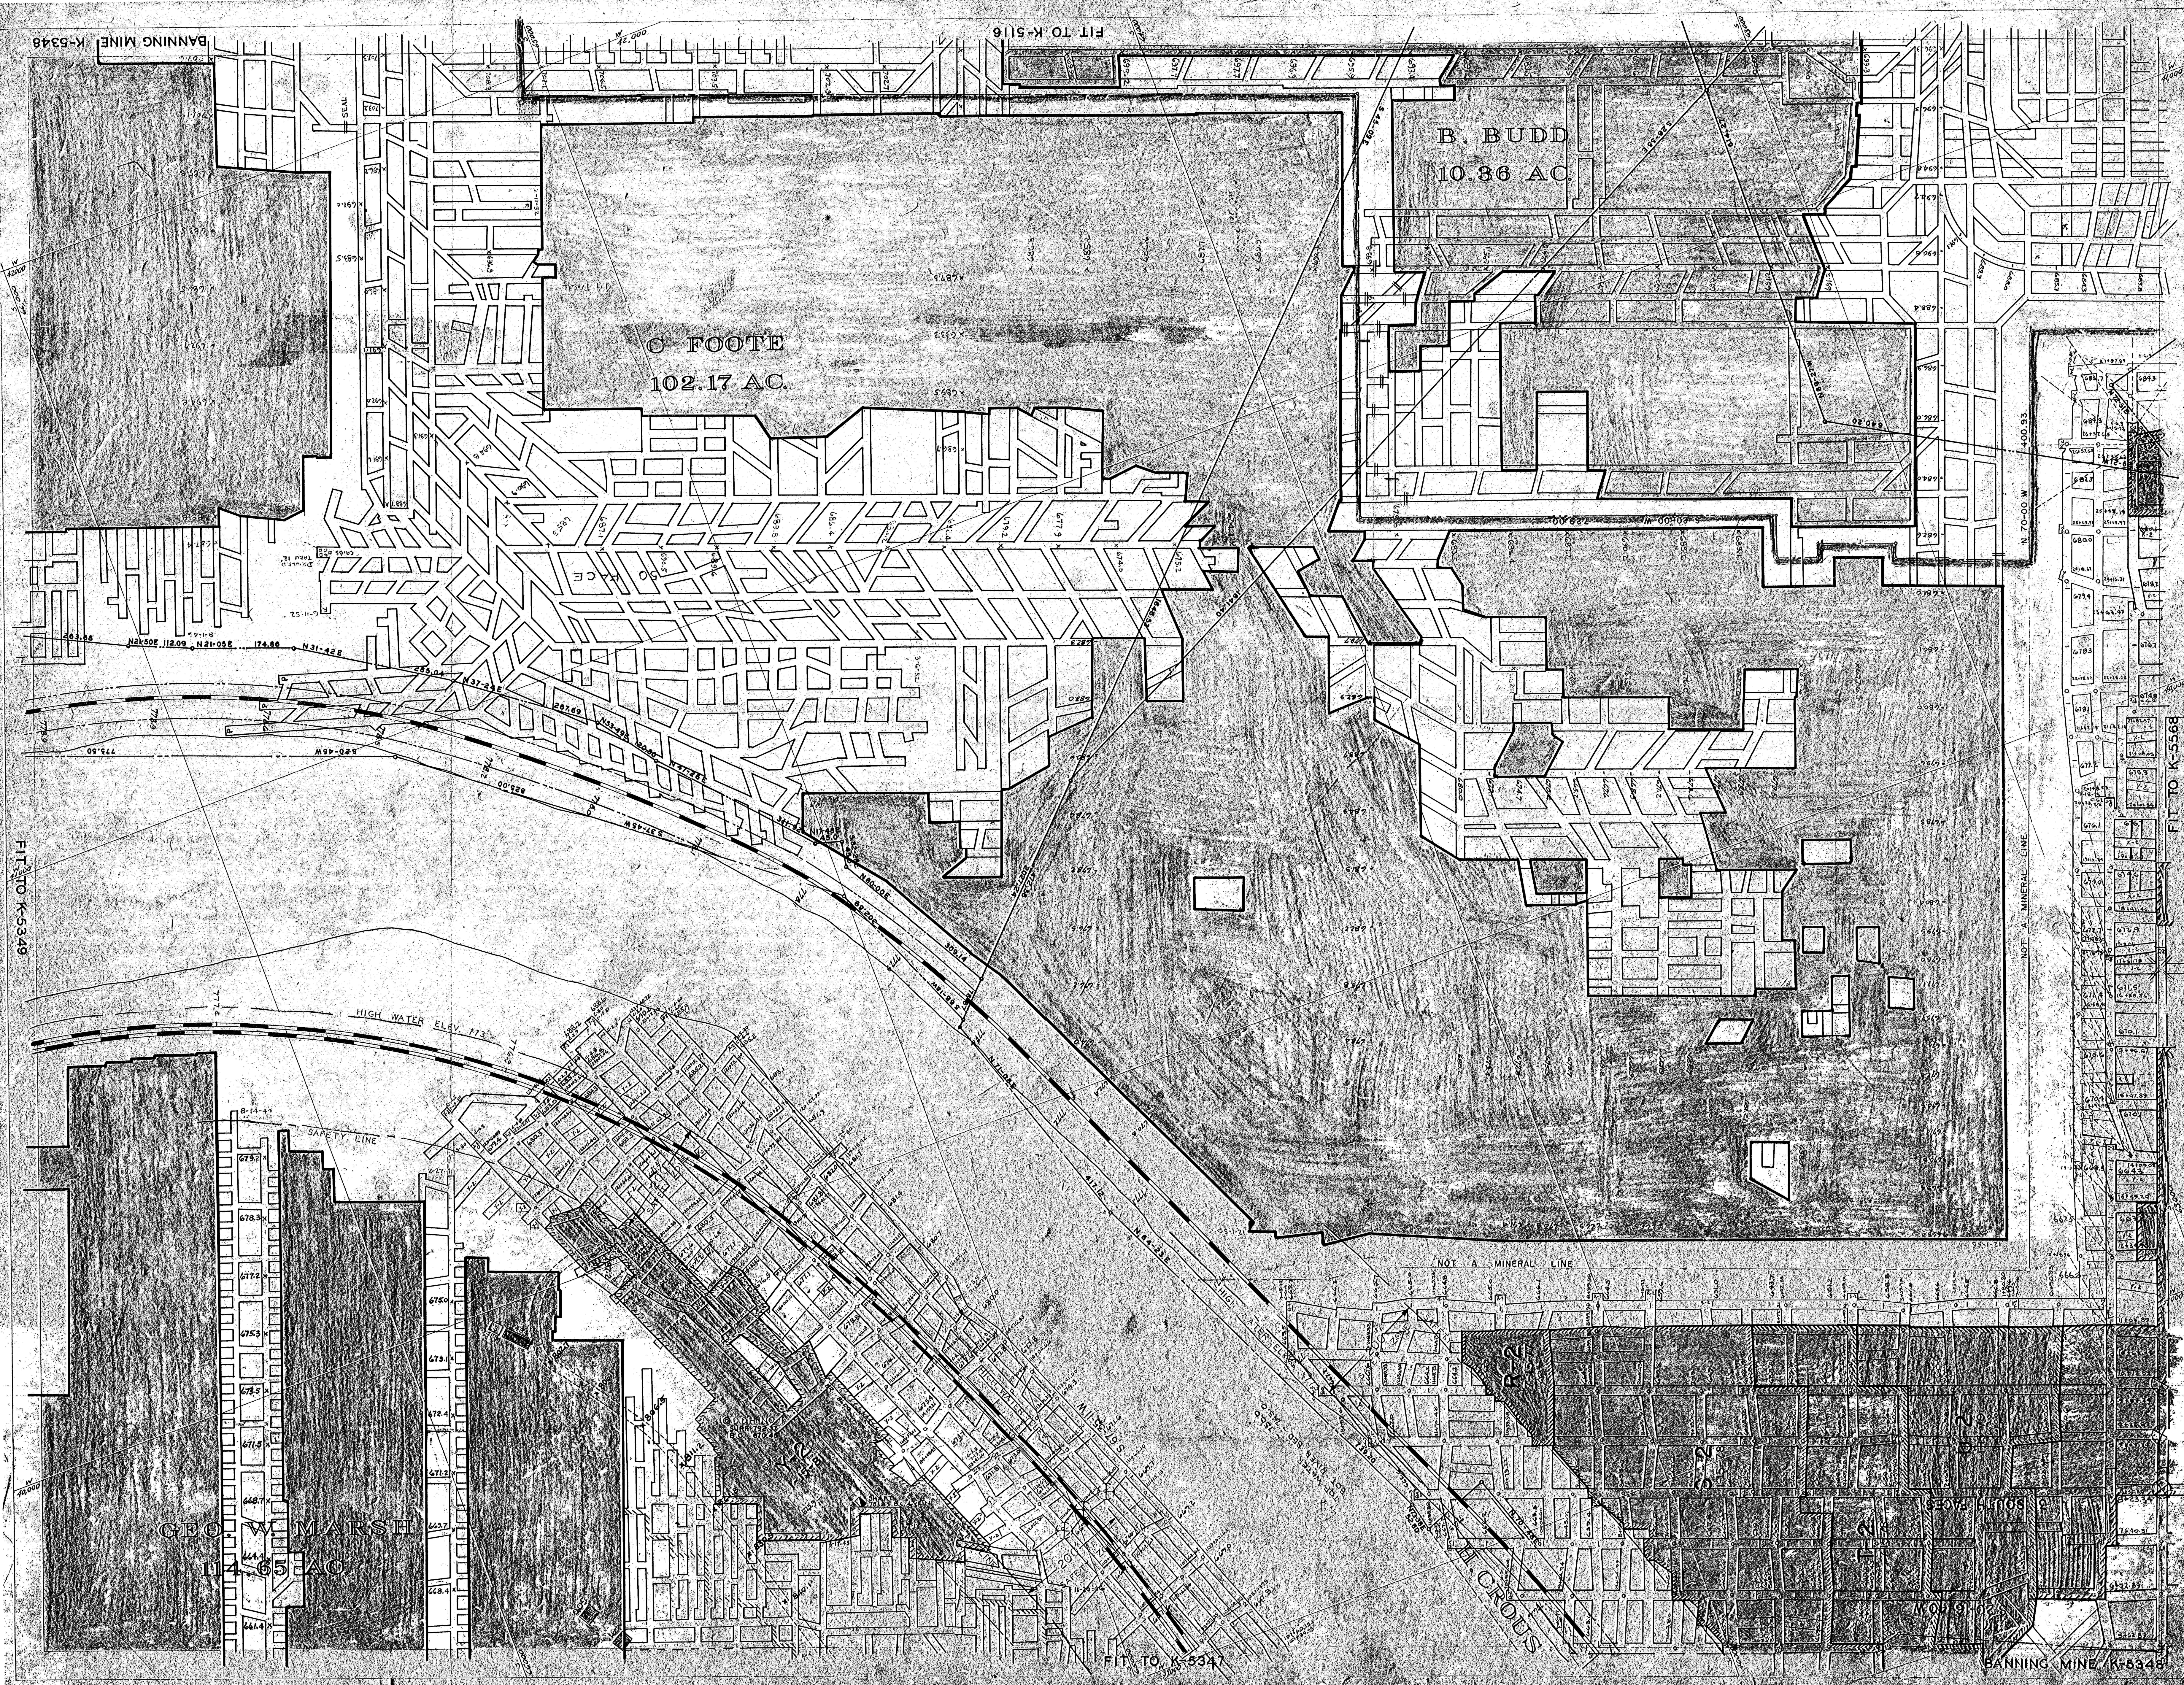

BANNING MINE K-5348

FIT TO K-5116

C. FOOTE
102.17 AC.

B. BUDD
10.36 AC.

114.65 AC.

BANNING MINE K-5348

FIT TO K-5347


FIT TO K-5349

NOT A MINERAL LINE

NOT A MINERAL LINE


HIGH WATER ELEV. 773

SAFETY LINE