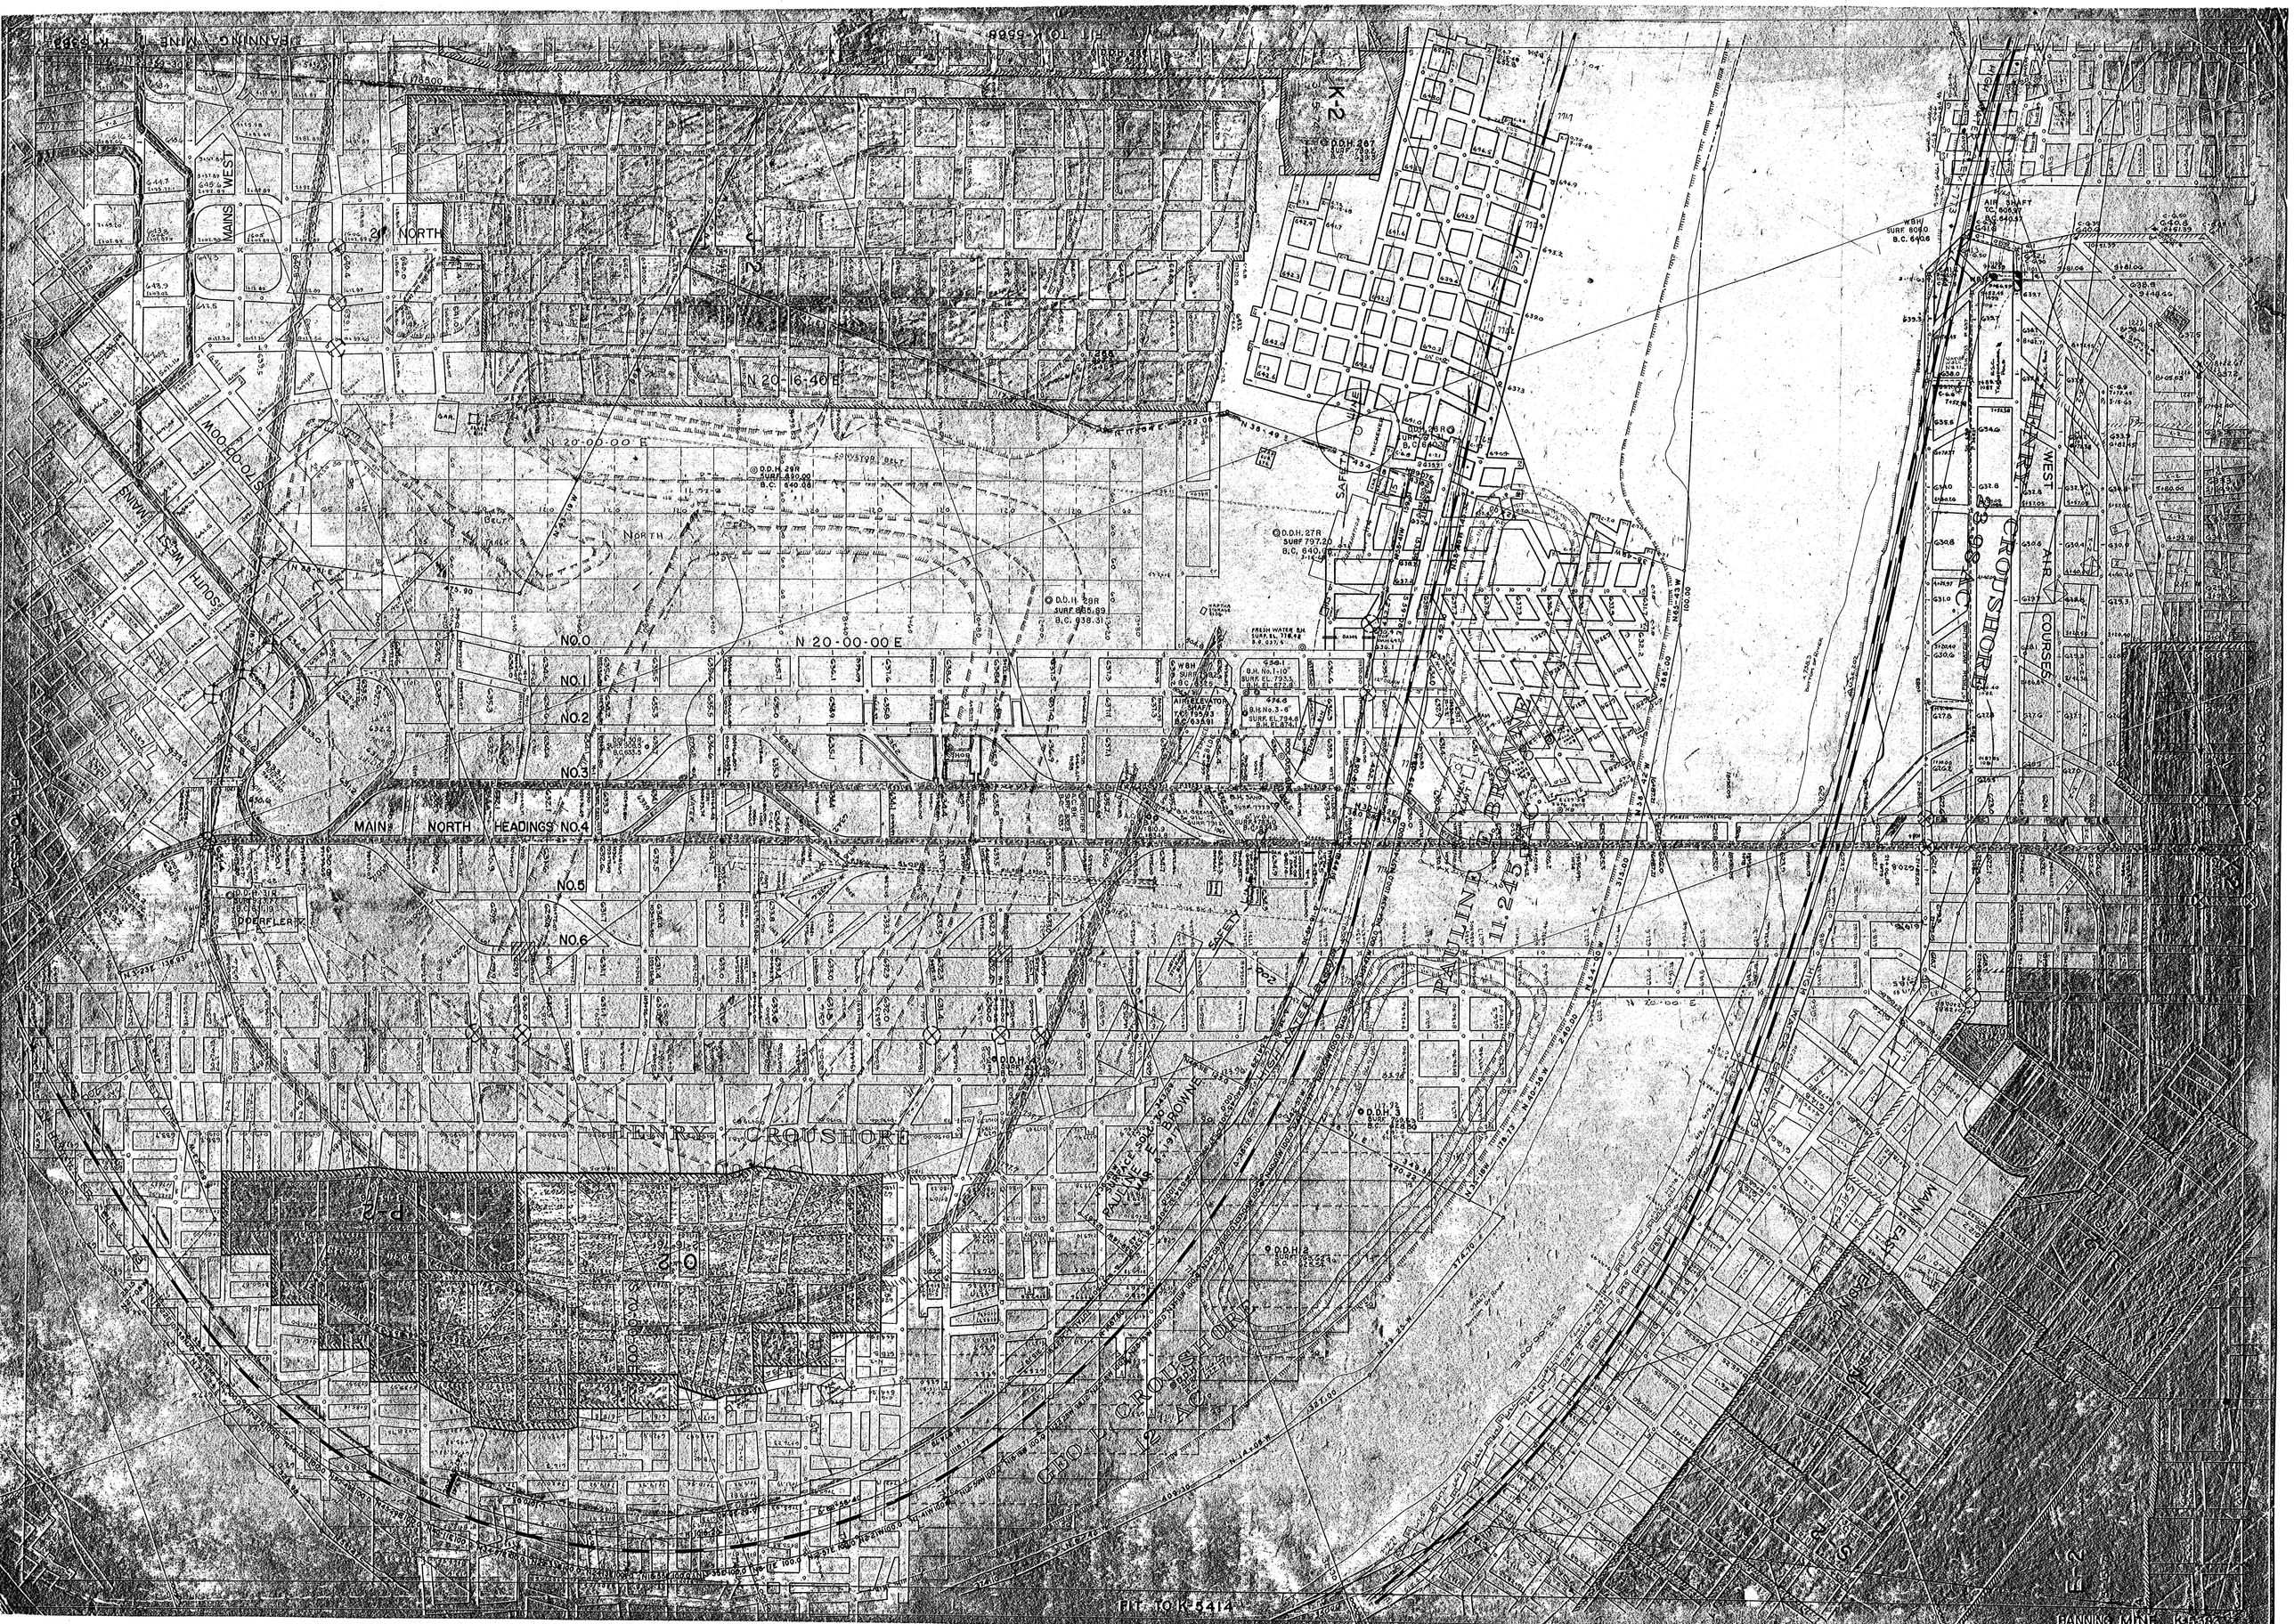

BANNING MINE K-5383
FIT TO K-5568
FIT TO K-5347
FIT TO K-5302
FIT TO K-5414
BANNING MINE K-5383
MAINS WEST
21 NORTH
N 20-16-40 E
K-2
D.D.H. 267 SURF 799.2 B.C. 639.8
SOUTH WEST MAINS
S 70-00-00 W
N 20-00-00 E
NORTH
BELT TRACK
CONVEYOR BELT
D.D.H. 29R SURF 890.00 B.C. 640.08
D.D.H. 28R SURF 865.89 B.C. 638.31
D.D.H. 27R SURF 797.20 B.C. 640.00
D.D.H. 26R
THICKENER
SAFETY LINE
NAPTHA STORAGE BLDG.
FRESH WATER B.H.
NO.0
NO.1
NO.2
NO.3
MAIN NORTH HEADINGS NO.4
NO.5
NO.6
W.B.H. SURF 798.2 B.C. 637.5
AIR ELEVATOR SHAFT T.C. 795.93 B.C. 633.91
B.H. No.1-10" SURF. EL. 793.3 B.H. EL. 672.8
B.H. No.3-6" SURF. EL. 794.6 B.H. EL. 874.1
DDH 30R SURF 906.5 B.C. 633.5
RECTIFIER
ROCK DUST
SLOPE
D.D.H. 31R SURF 933.77 B.C. 631.19
DOERFLER
HENRY CROUSHORE
P-2
O-2
S 70-00-00 E
PAULINE BROWNE 11.245 AC.
PAULINE E. BROWNE
D.D.H. 4
D.D.H. 3 SURF 769.63 B.C. 628.80
D.D.H. 2 SURF 769.62 B.C. 625.54
GEO. L. CROUSHORE 12 AC.
HIGH WATER LINE
BOTTOM OF RIVER
HENRY CROUSHORE 3.98 AC.
WEST AIR COURSES
AIR SHAFT T.C. 806.97 B.C. 640.57
W.B.H. SURF 806.0 B.C. 640.6
4" FRESH WATER LINE
N 20-00 E
MAIN EAST HEADINGS
E-2
N 65-43 W
N 58-42 W
N 54-00 W
N 40-56 W
S 33-00-00 E