


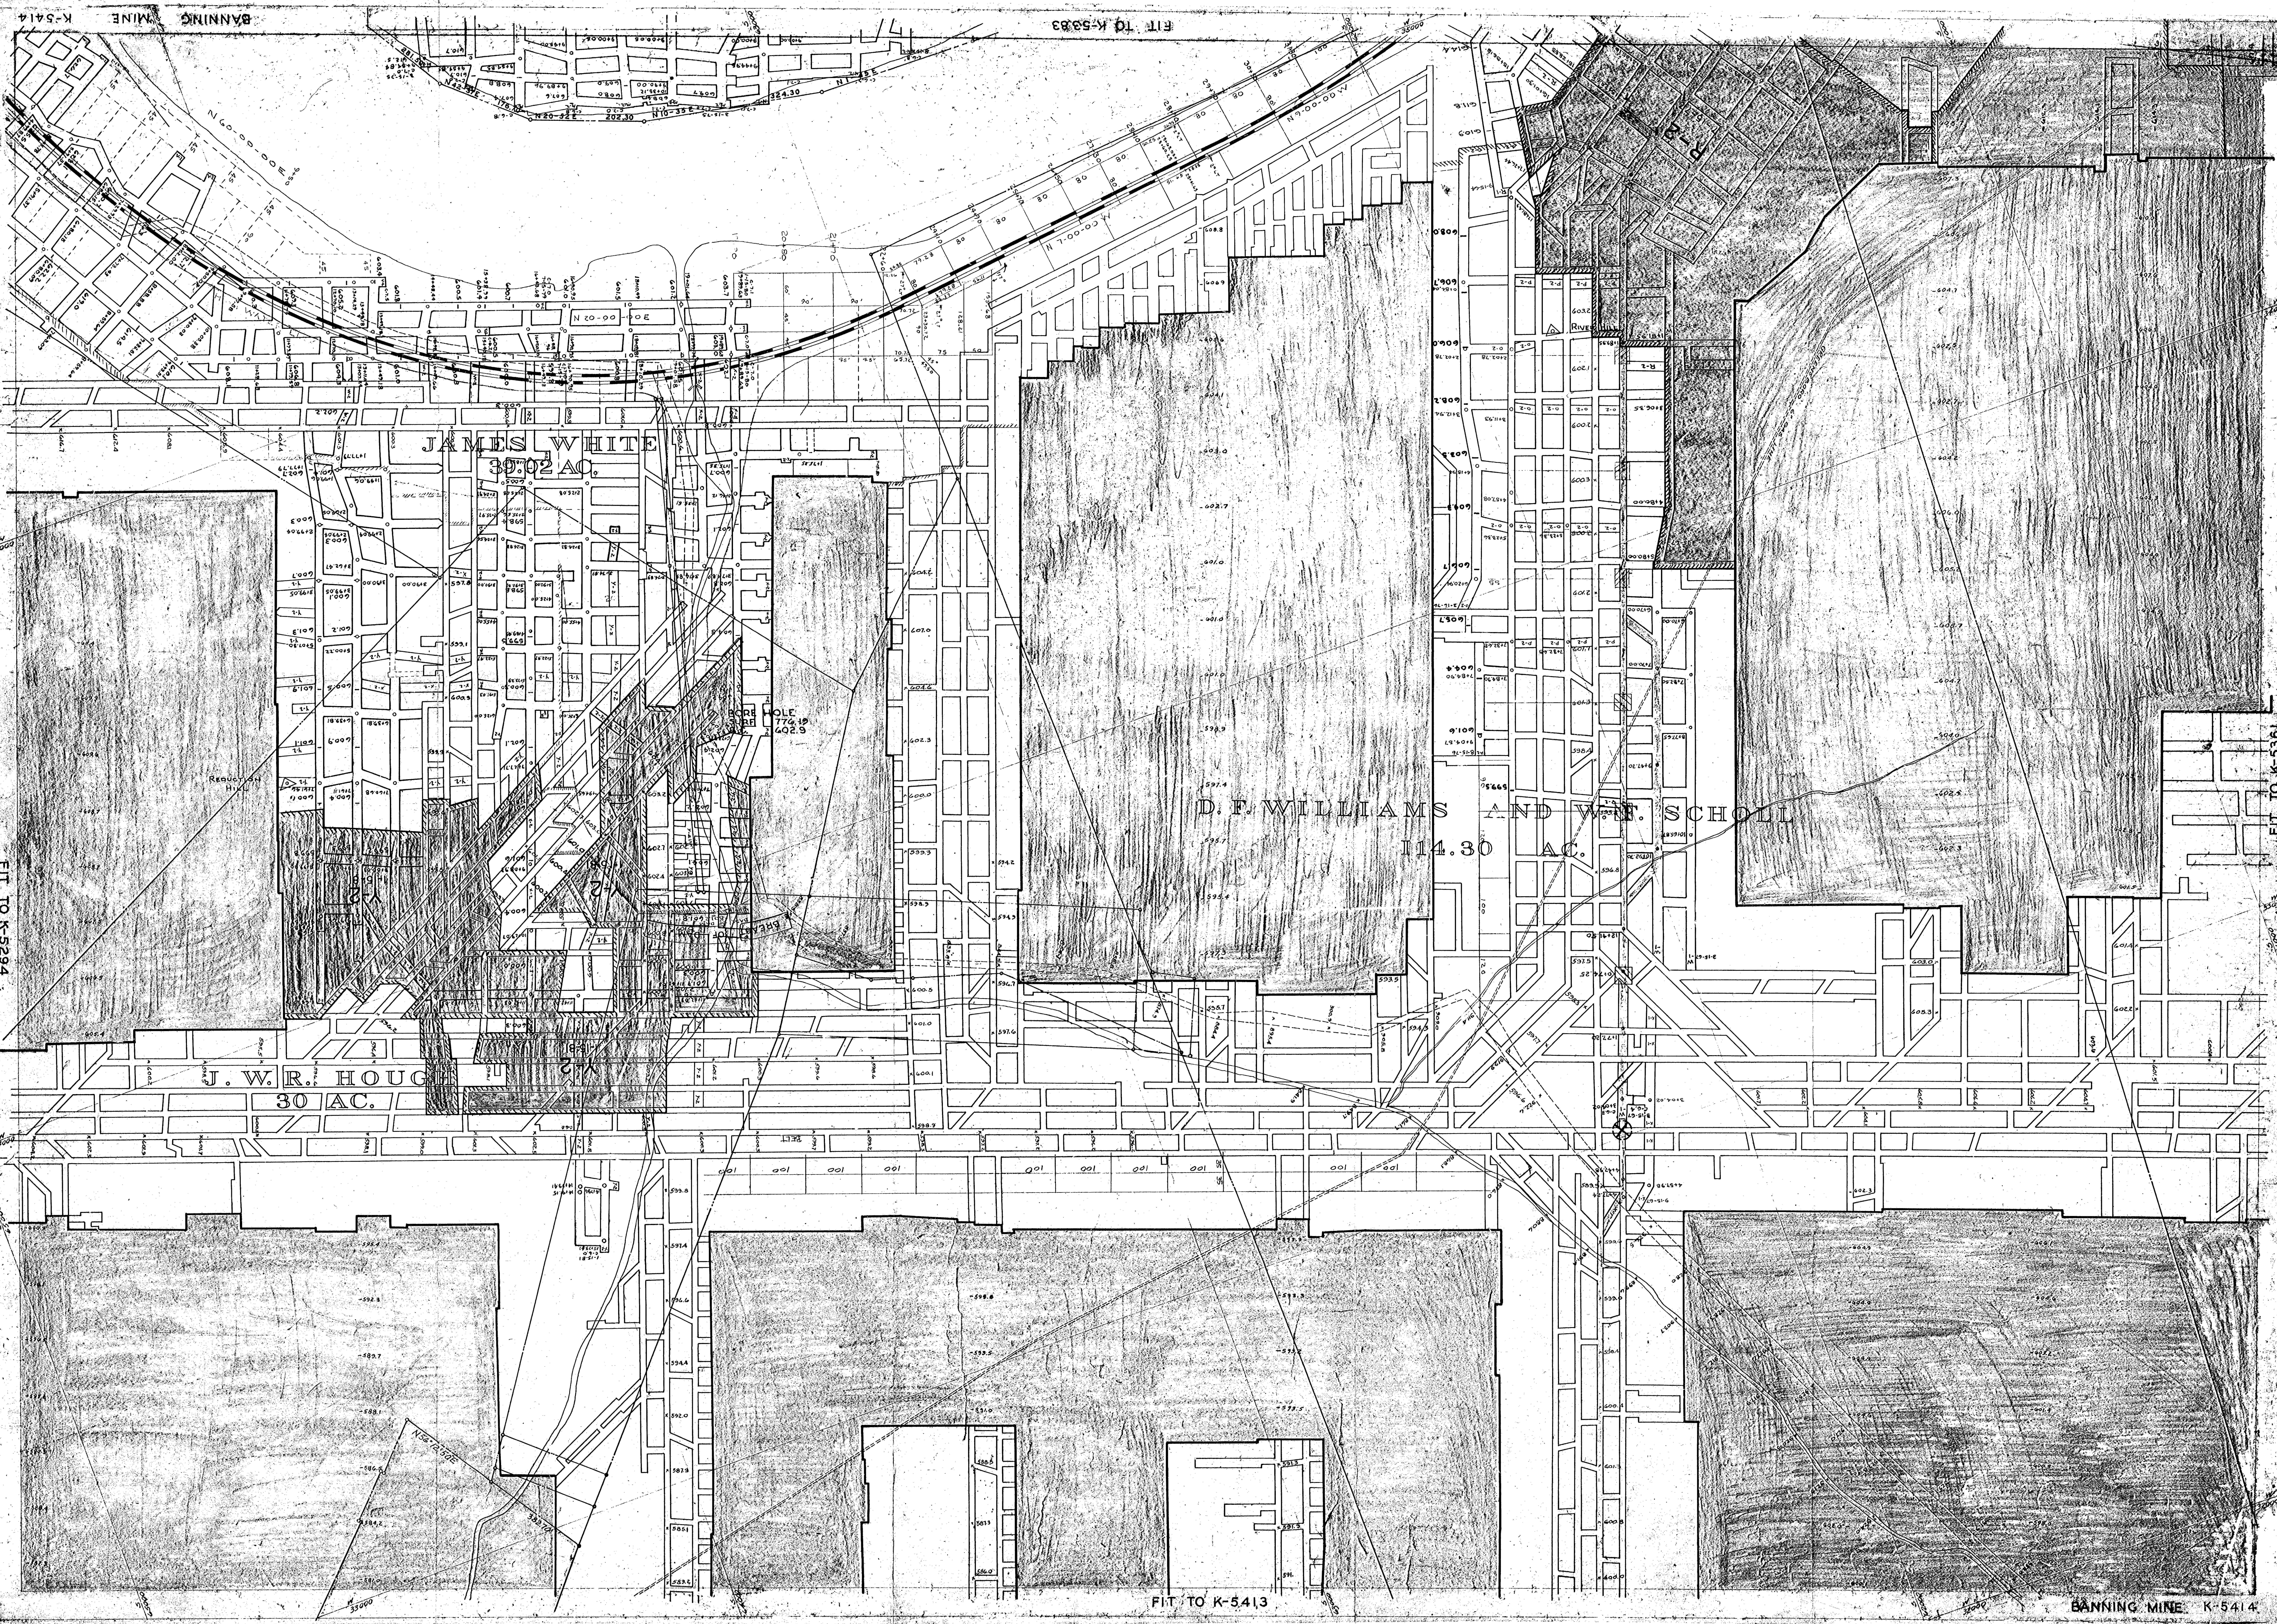

K-5414

BANNING MINE


FIT TO K-5381

FIT TO K-5413

BANNING MINE K-5414