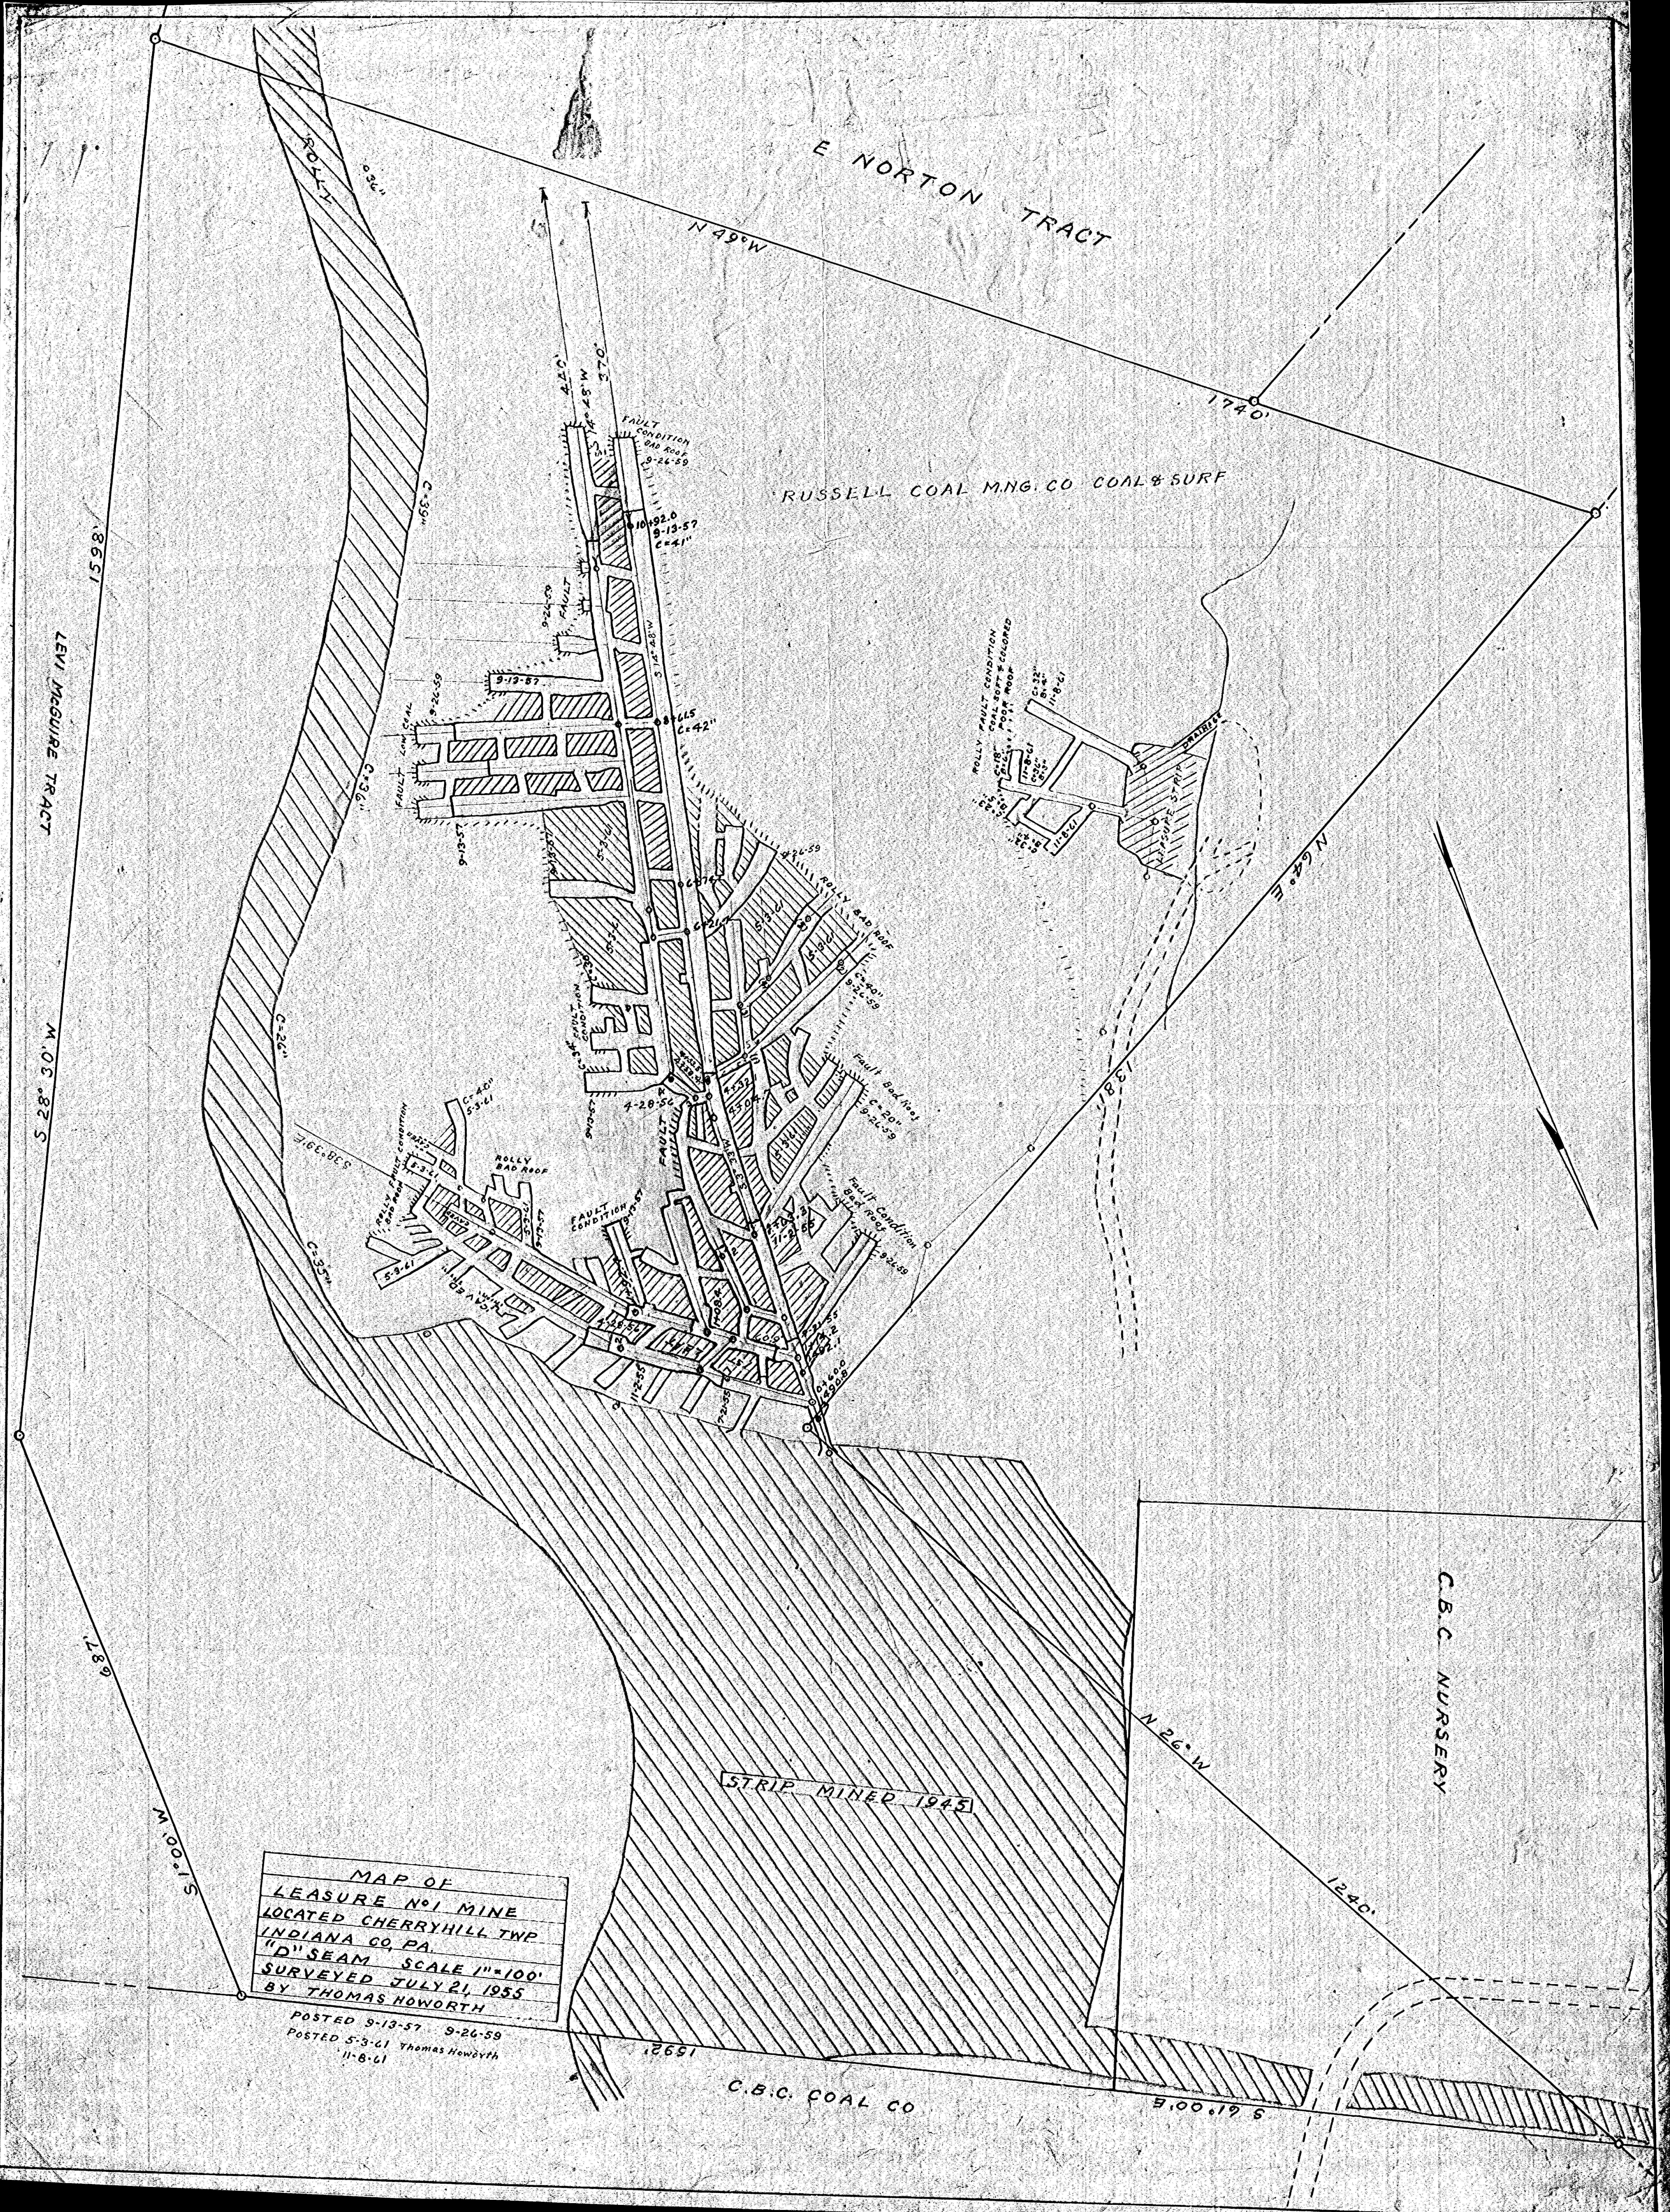
E NORTON TRACT
N 49° W
1740'
RUSSELL COAL MNG. CO COAL & SURF
LEVI McGUIRE TRACT
S 28° 30' W
1598'
687'
S 1° 00' W
C.B.C. COAL CO
S 61° 00' E
1592'
C.B.C. NURSERY
N 26° W
1240'
N 64° E
1381'
STRIP MINED 1945
ROLLY
C=36"
C=39"
C=26"
C=35"
C=33"
420'
S 14° 48' W
370'
FAULT CONDITION BAD ROOF 9-26-59
10+92.0 9-13-57 C=41"
FAULT 9-26-59
9-13-57
FAULT LOW COAL 9-26-59
8+61.5 C=42"
9-13-57
5-3-61
6+87
6+21.7
9-26-59
ROLLY BAD ROOF
C=40" 9-26-59
FAULT CONDITION C=34"
9-13-57
4+33.5
4+30.4
4-28-56
FAULT
4+32.1
4+04
5-3-61
Fault Bad Roof C=20" 9-26-59
Fault Condition Bad Roof 9-26-59
C=40" 5-3-61
ROLLY FAULT CONDITION 5-3-61
CAVED
ROLLY BAD ROOF
5-3-61 9-13-57
ROLLY BAD ROOF
S 38° 39' E
FAULT CONDITION 9-13-57
CAVED
2+05.3 11-2-55
1+08.4
4-28-56
LEAK
11-2-55
7-21-55
0+60.0
490.8
1+13.2
492.1
ROLLY FAULT CONDITION COAL SOFT & COLORED POOR ROOF
C=32" B=4" 11-8-61
C=18" B=6"
11-8-61 C=36" B=3"
C=23" B=5"
C=32" B=4" 11-8-61
LEASURE STRIP
DRAINAGE

MAP OF
LEASURE No1 MINE
LOCATED CHERRYHILL TWP
INDIANA CO, PA.
"D" SEAM SCALE 1" = 100'
SURVEYED JULY 21, 1955
BY THOMAS HOWORTH

POSTED 9-13-57 9-26-59
POSTED 5-3-61 Thomas Howorth
11-8-61
]