


SURVEY DATES

- A - NOV 18, 1951.
- B - APR. 21, 1952.
- C - DEC. 2, 1952.
- D - SEPT. 18, 1953
- E - SEPT. 25, 1954
- F - OCT. 25, 1955
- G - OCT. 24, 1956
- H - APRIL 16, 1957
- I - Nov. 15, 1957
- J - MAY 9, 1958
- K - MARCH 13, 1959

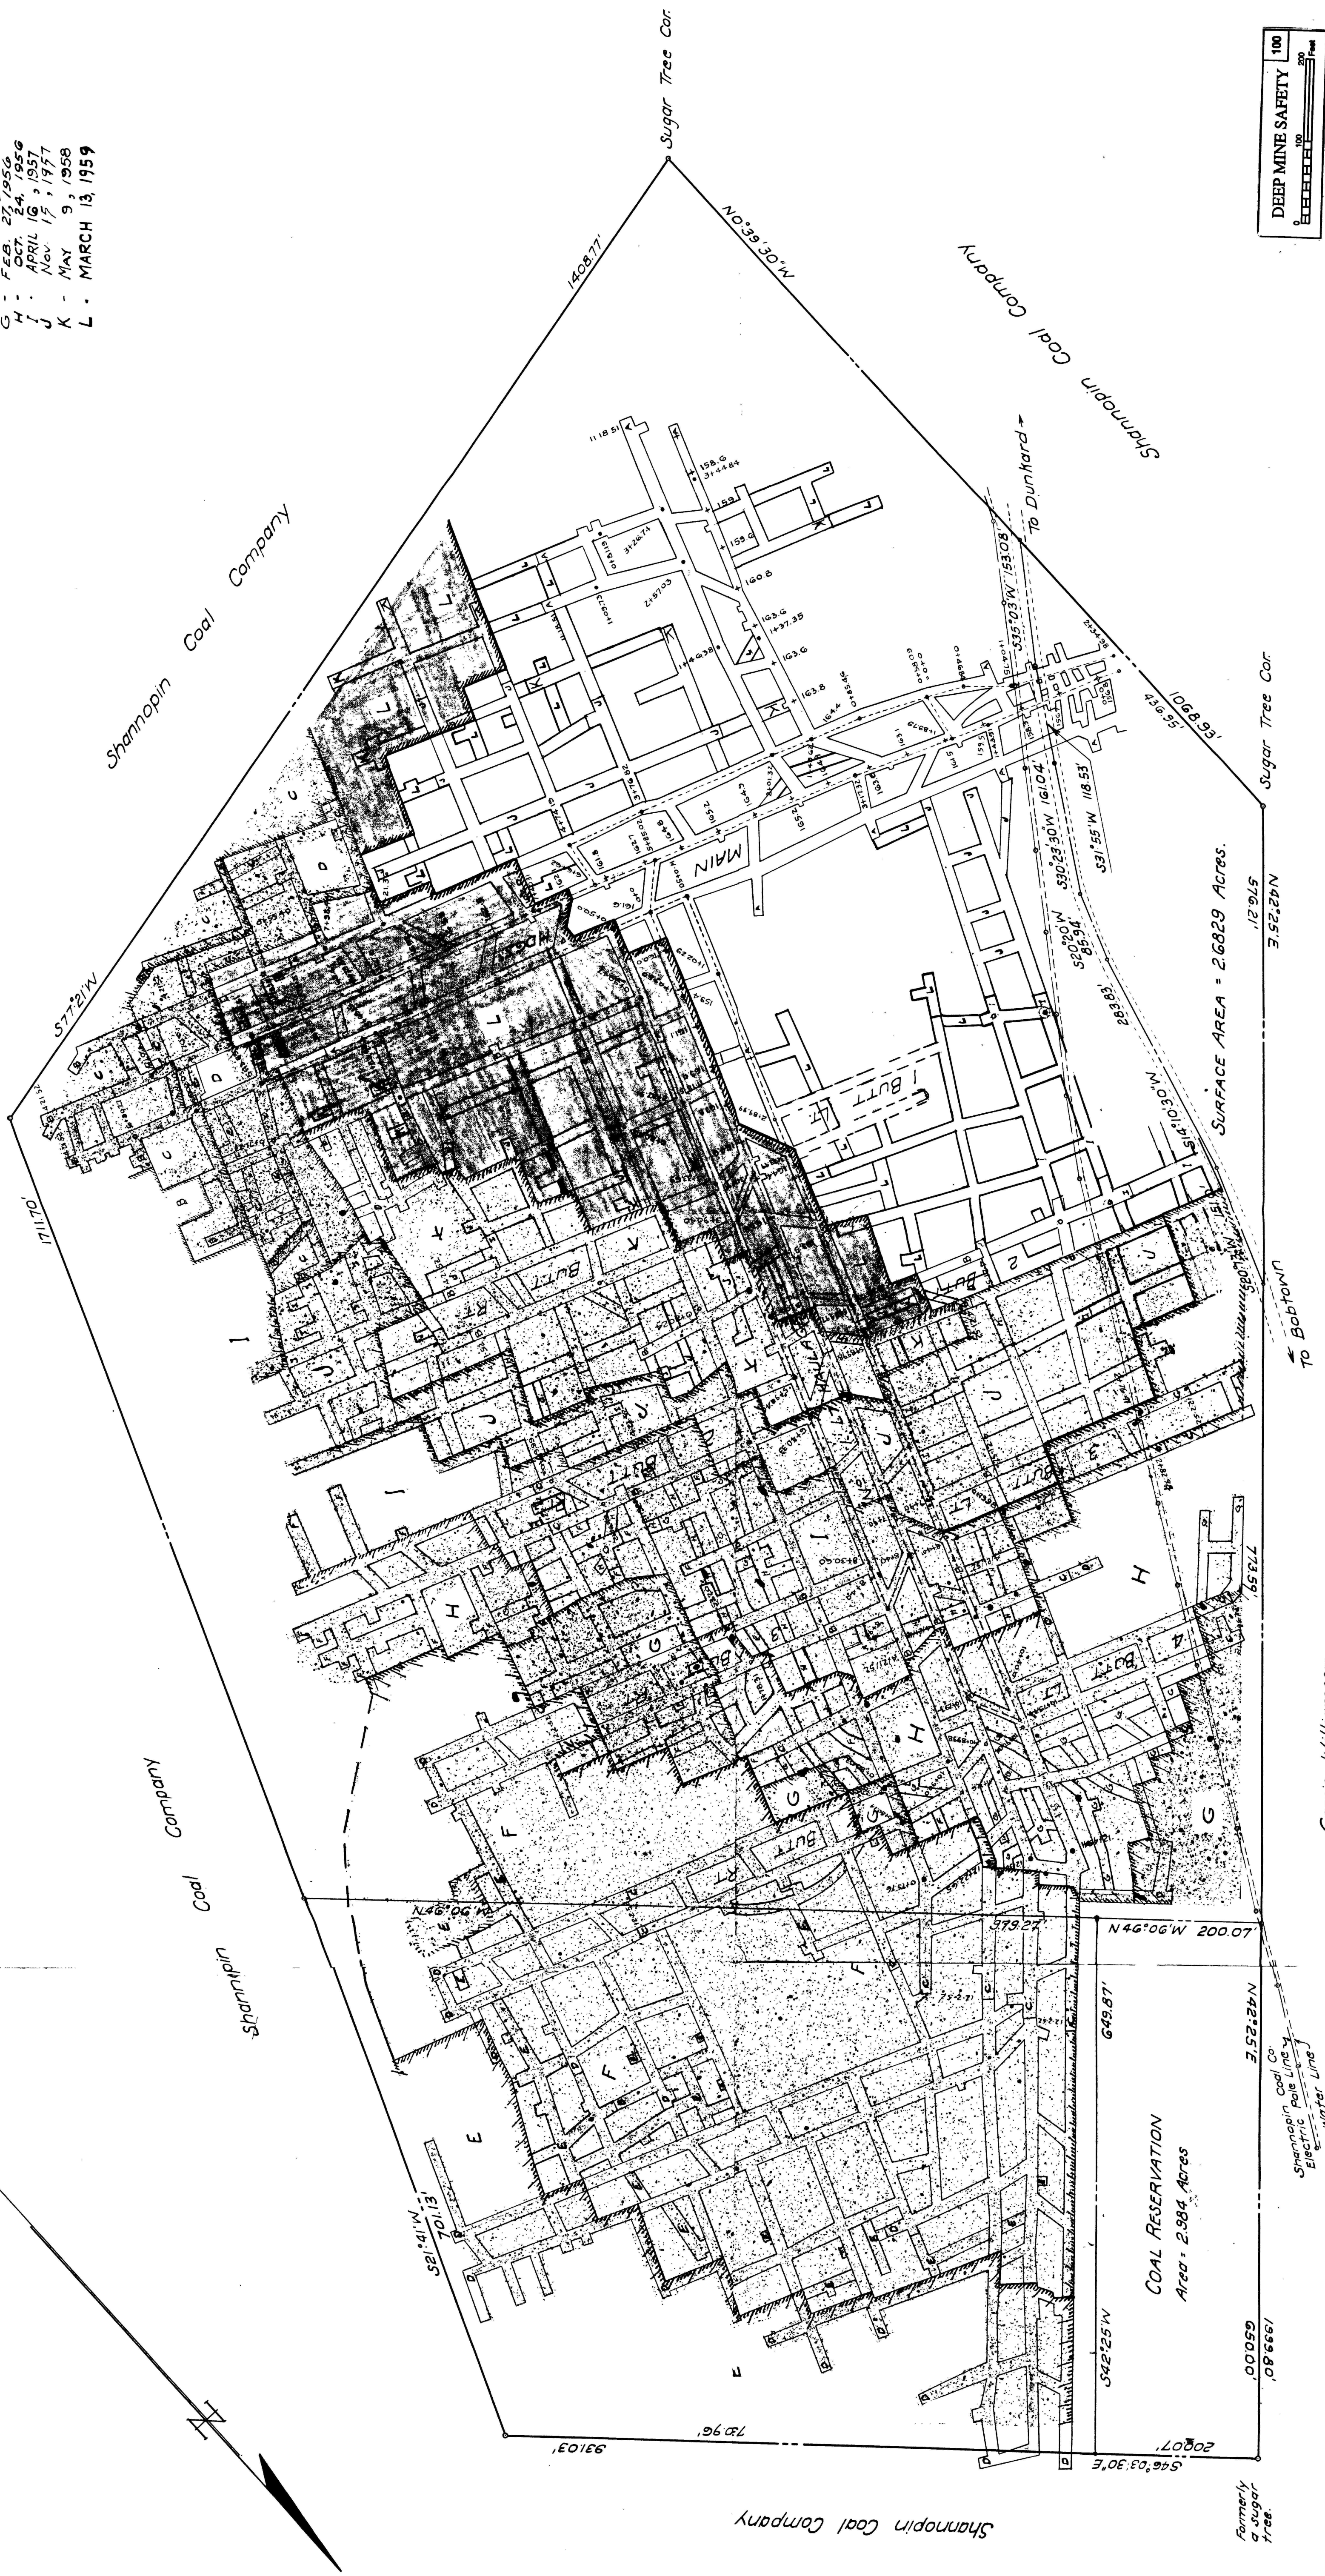

MINE MAP OF
 LECKRONE NO. 2 MINE
 OF
 THE LECKRONE COAL & COKE COMPANY
 Dunkard Twp, Greene County, Pa.
 Scale 1" = 100'
 A.J. Oppermann, R.P.E., Uniontown, Pa.
 11/23/51