
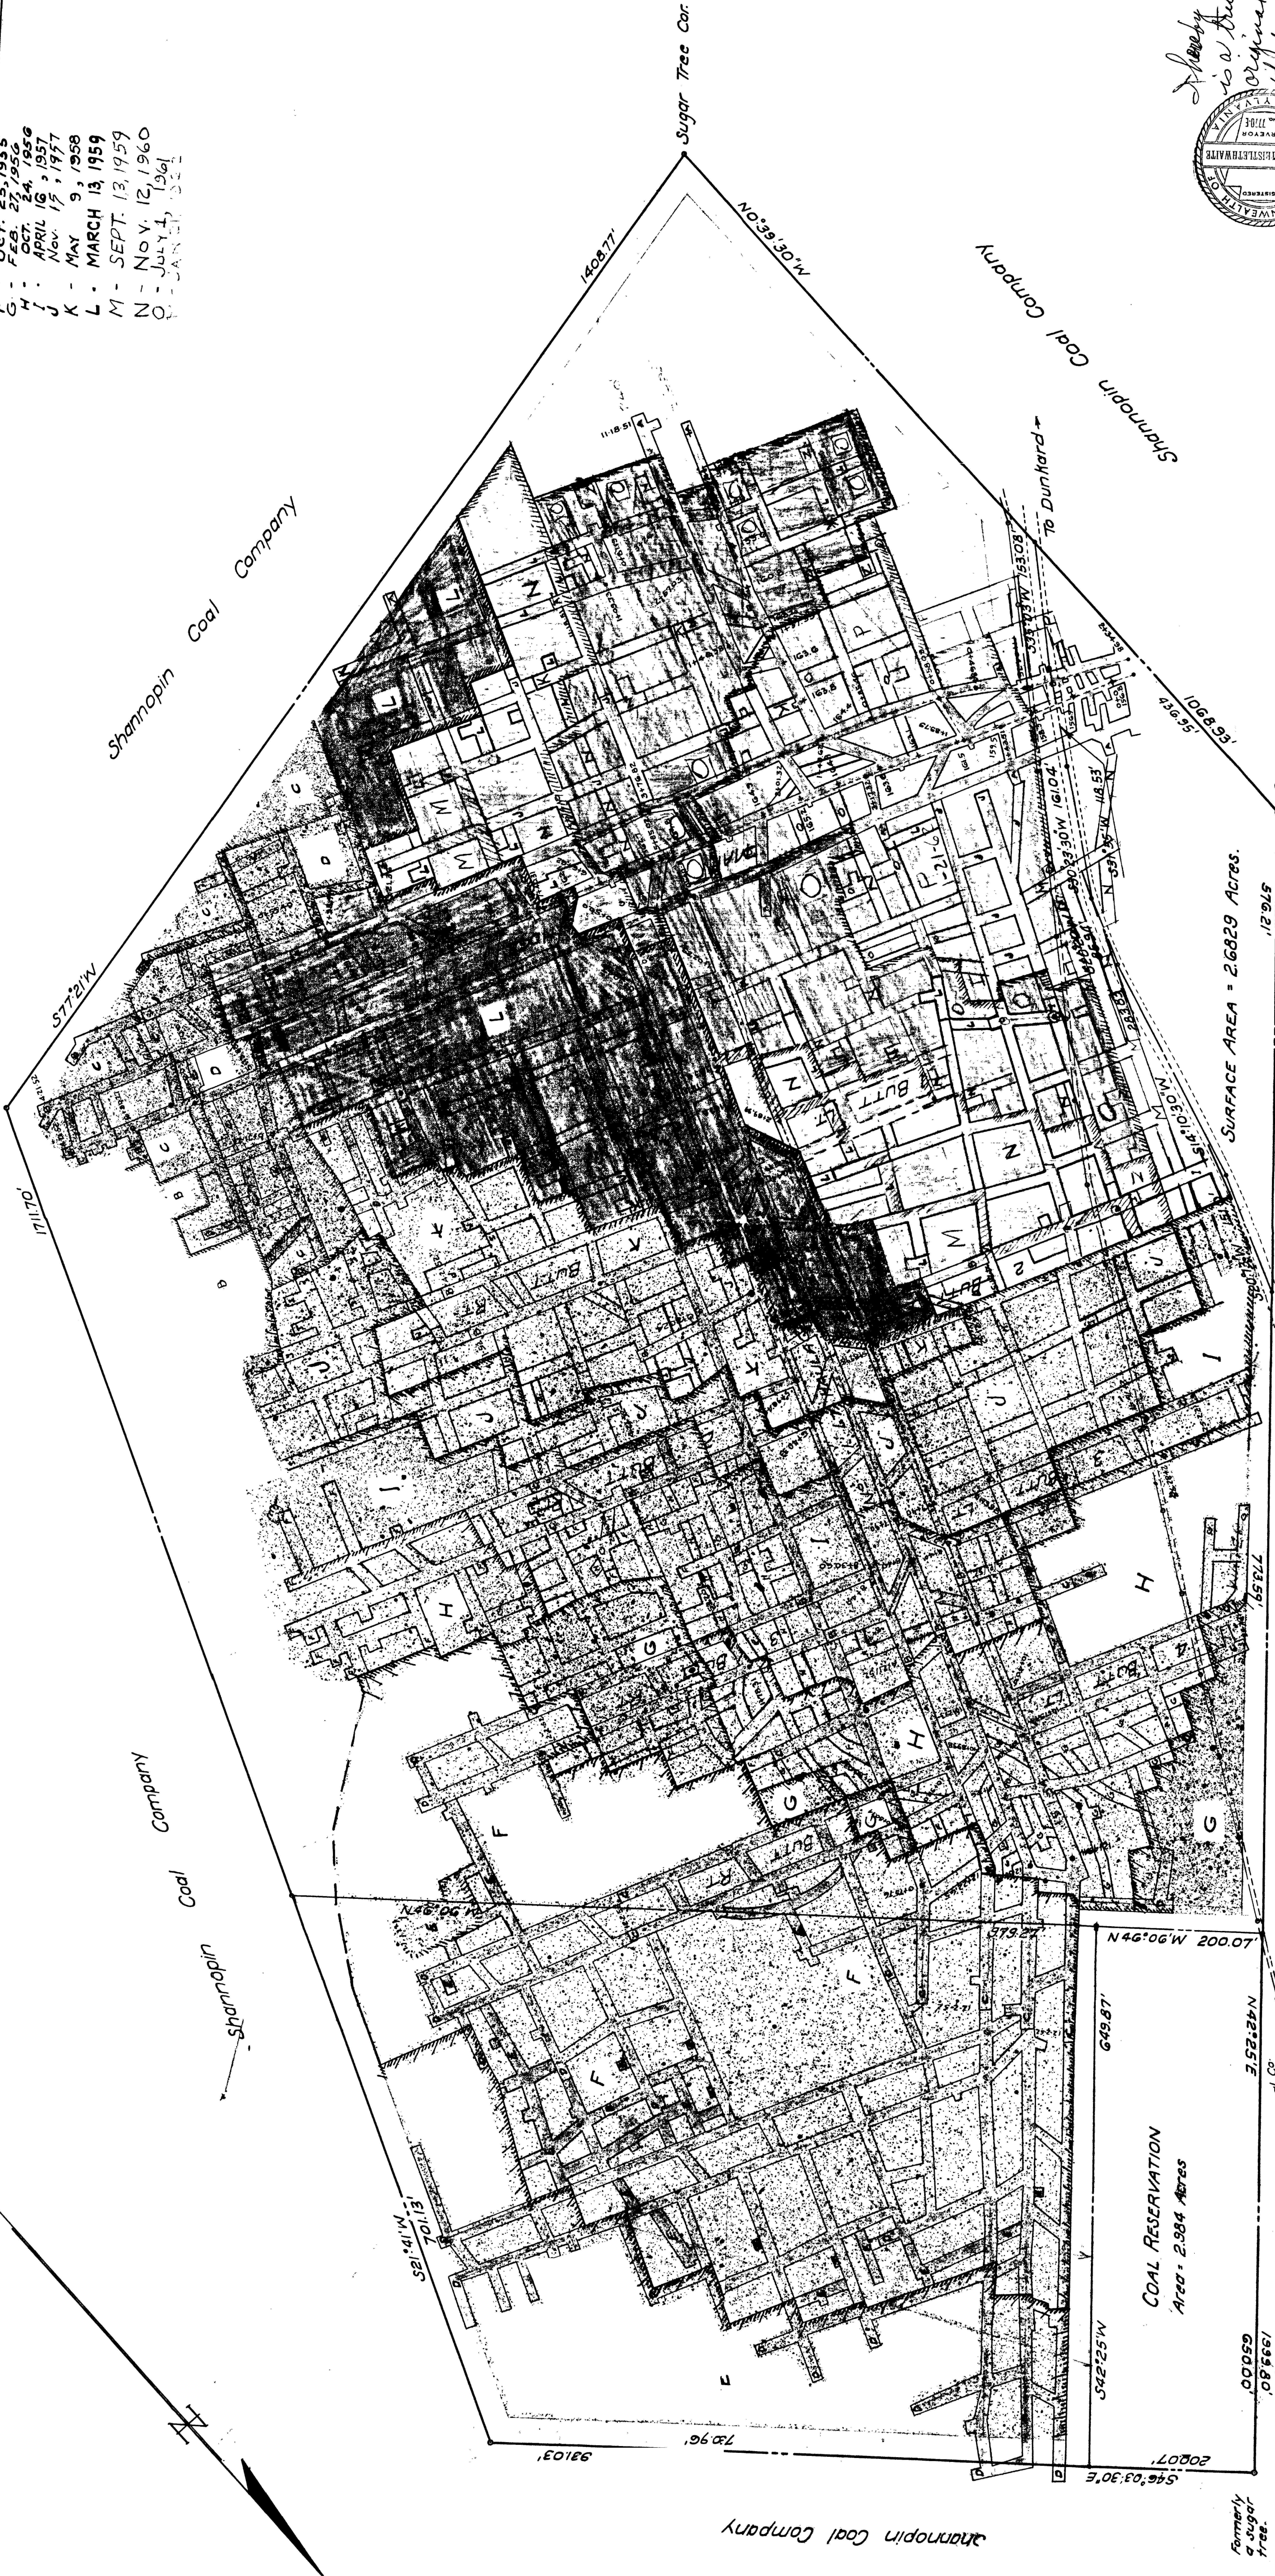


SURVEY DATES

- A - NOV 18, 1951.
- B - APR 25, 1952.
- C - DEC 12, 1952.
- D - SEPT 18, 1953.
- E - SEPT 25, 1954.
- F - FEB 27, 1955.
- G - OCT 24, 1956.
- H - APRIL 16, 1957.
- I - Nov 15, 1957.
- J - MAY 9, 1958.
- K - MARCH 13, 1959.
- L - SEPT 13, 1959.
- M - Nov 12, 1960.
- N - JULY 4, 1961.
- O - JAN 1, 1962.

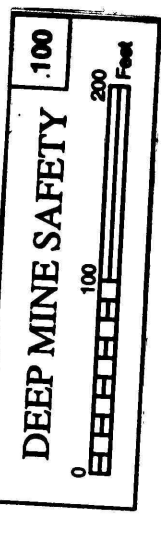

William O. Throckmold

**MINE MAP OF
LECKRONE No. 2 MINE**

OF

THE LECKRONE COAL & COKE COMPANY
 Dunbar Twp., Greene County, Pa.
 Scale 1" = 100'
 A.J. Oppermann, R.P.E., Uniontown, Pa.
 11-23-51