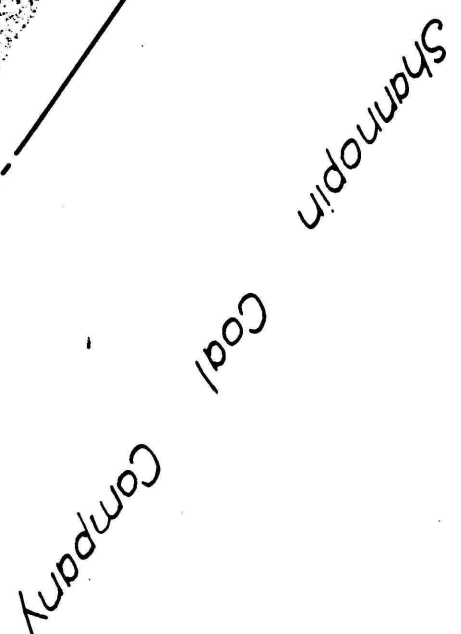


[illegible]

MINE MAP OF
LECKRONE No 2 MINE
OF
THE LECKRONE COAL & COKE COMPANY
Dunford Twp., Greene County, Pa.
Scale 1"=100'
A. J. Oppermann, R. P. E., Uniontown, Pa.
11-23-51