


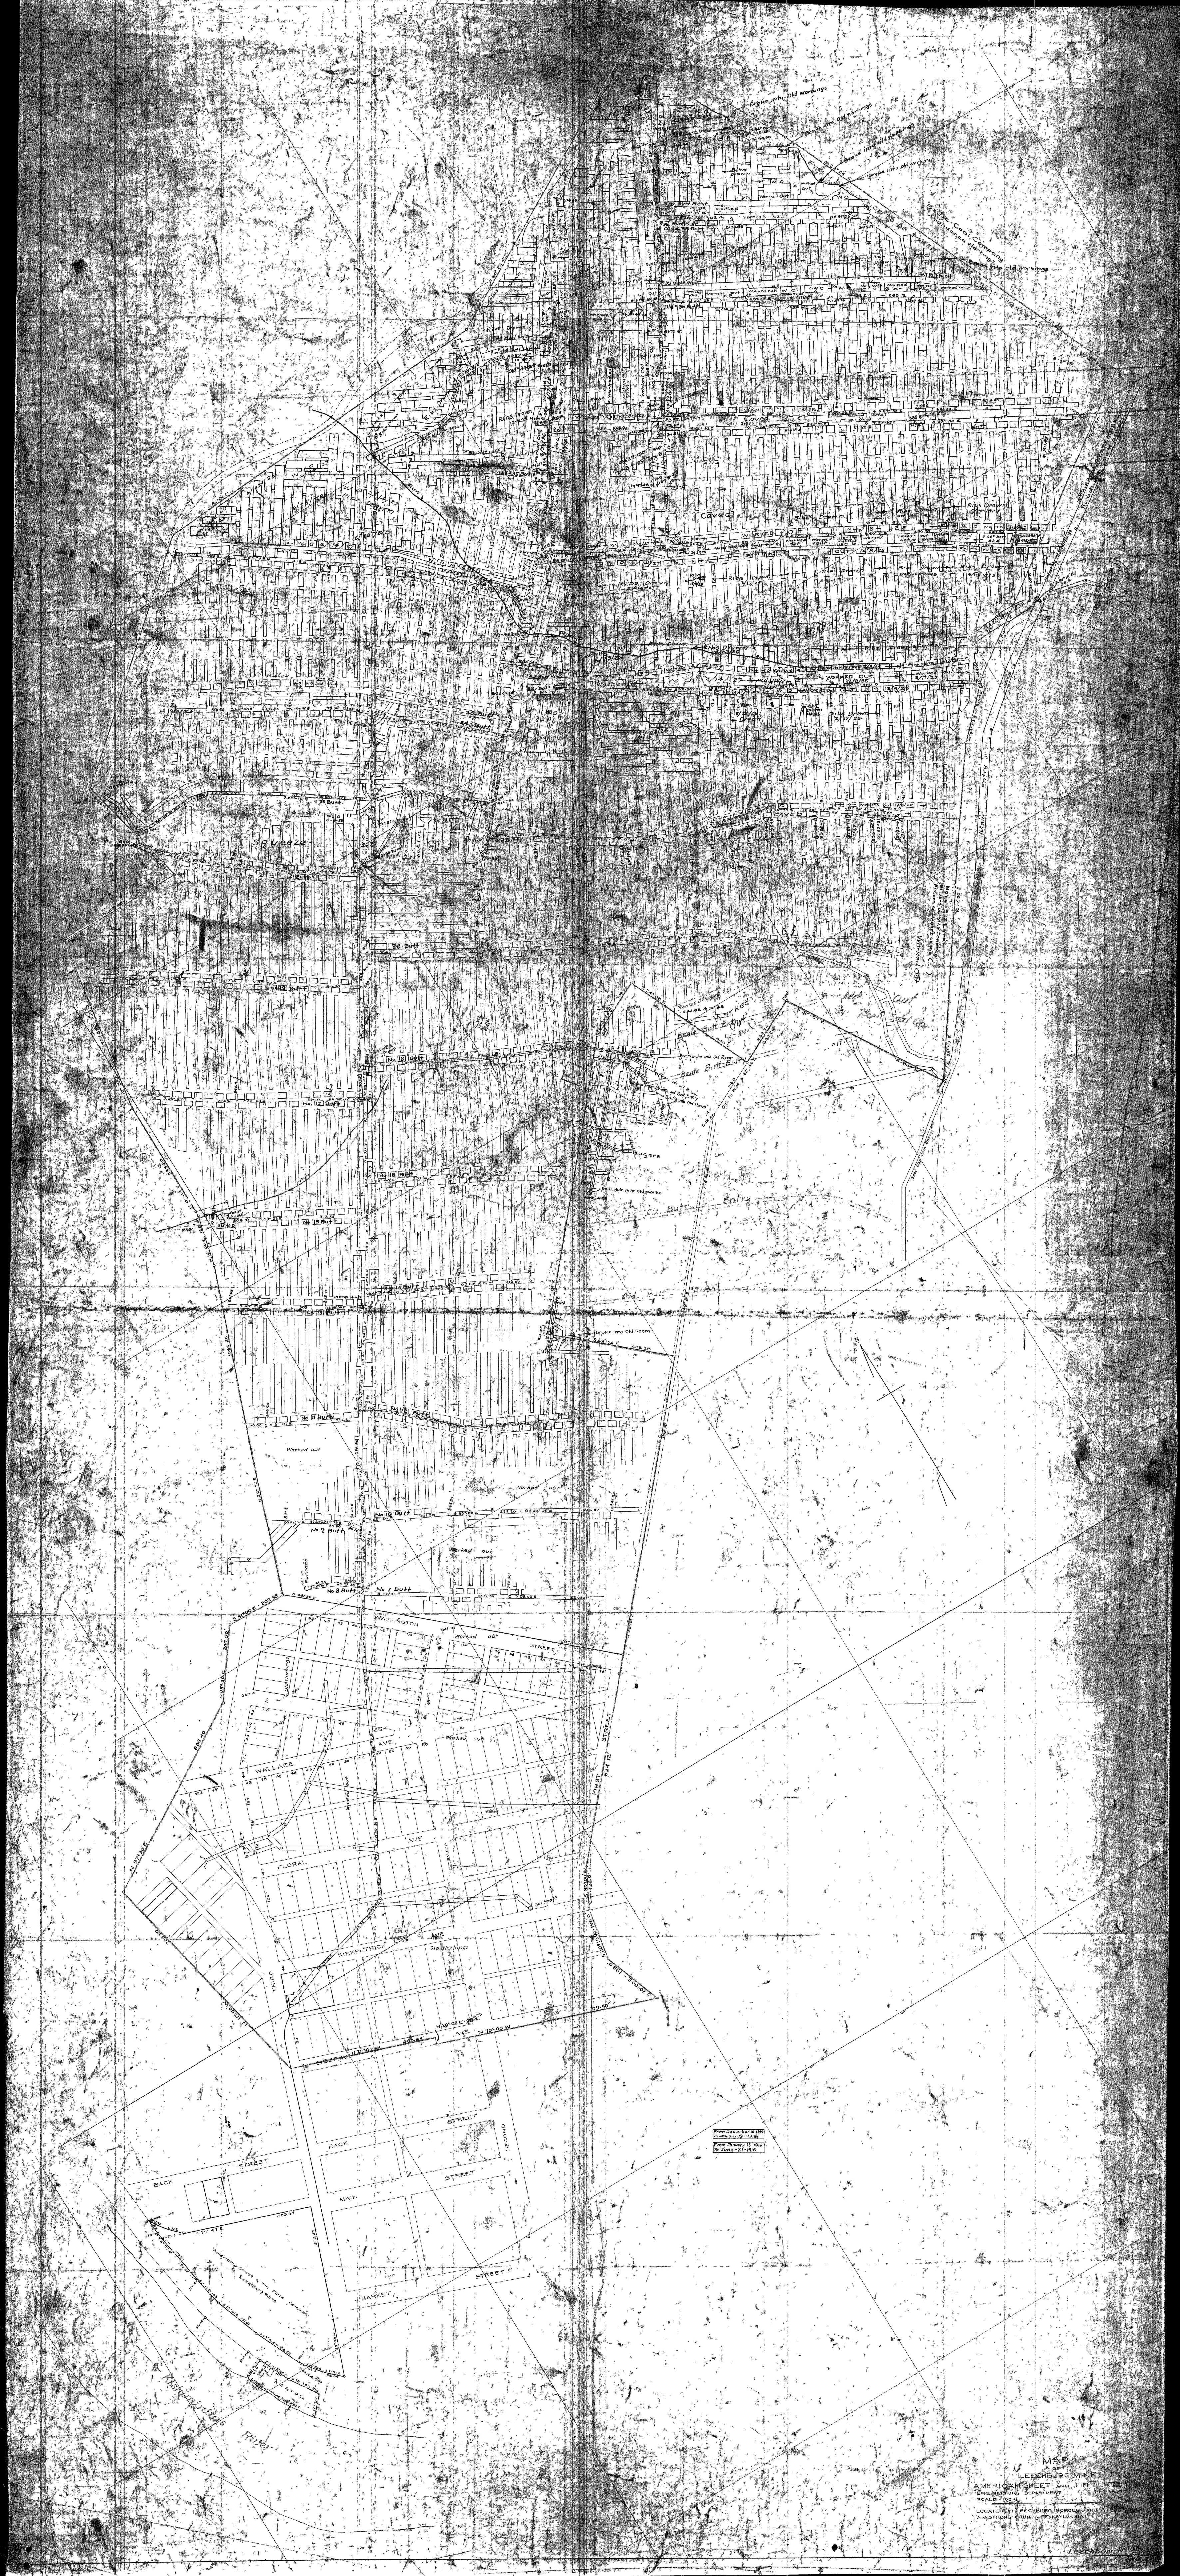

MAP
LEECBURG, PA.
ENGINEERING DEPARTMENT
SCALE 1" = 100'
LOCATED BY LEACHBURG, PENNSYLVANIA
