


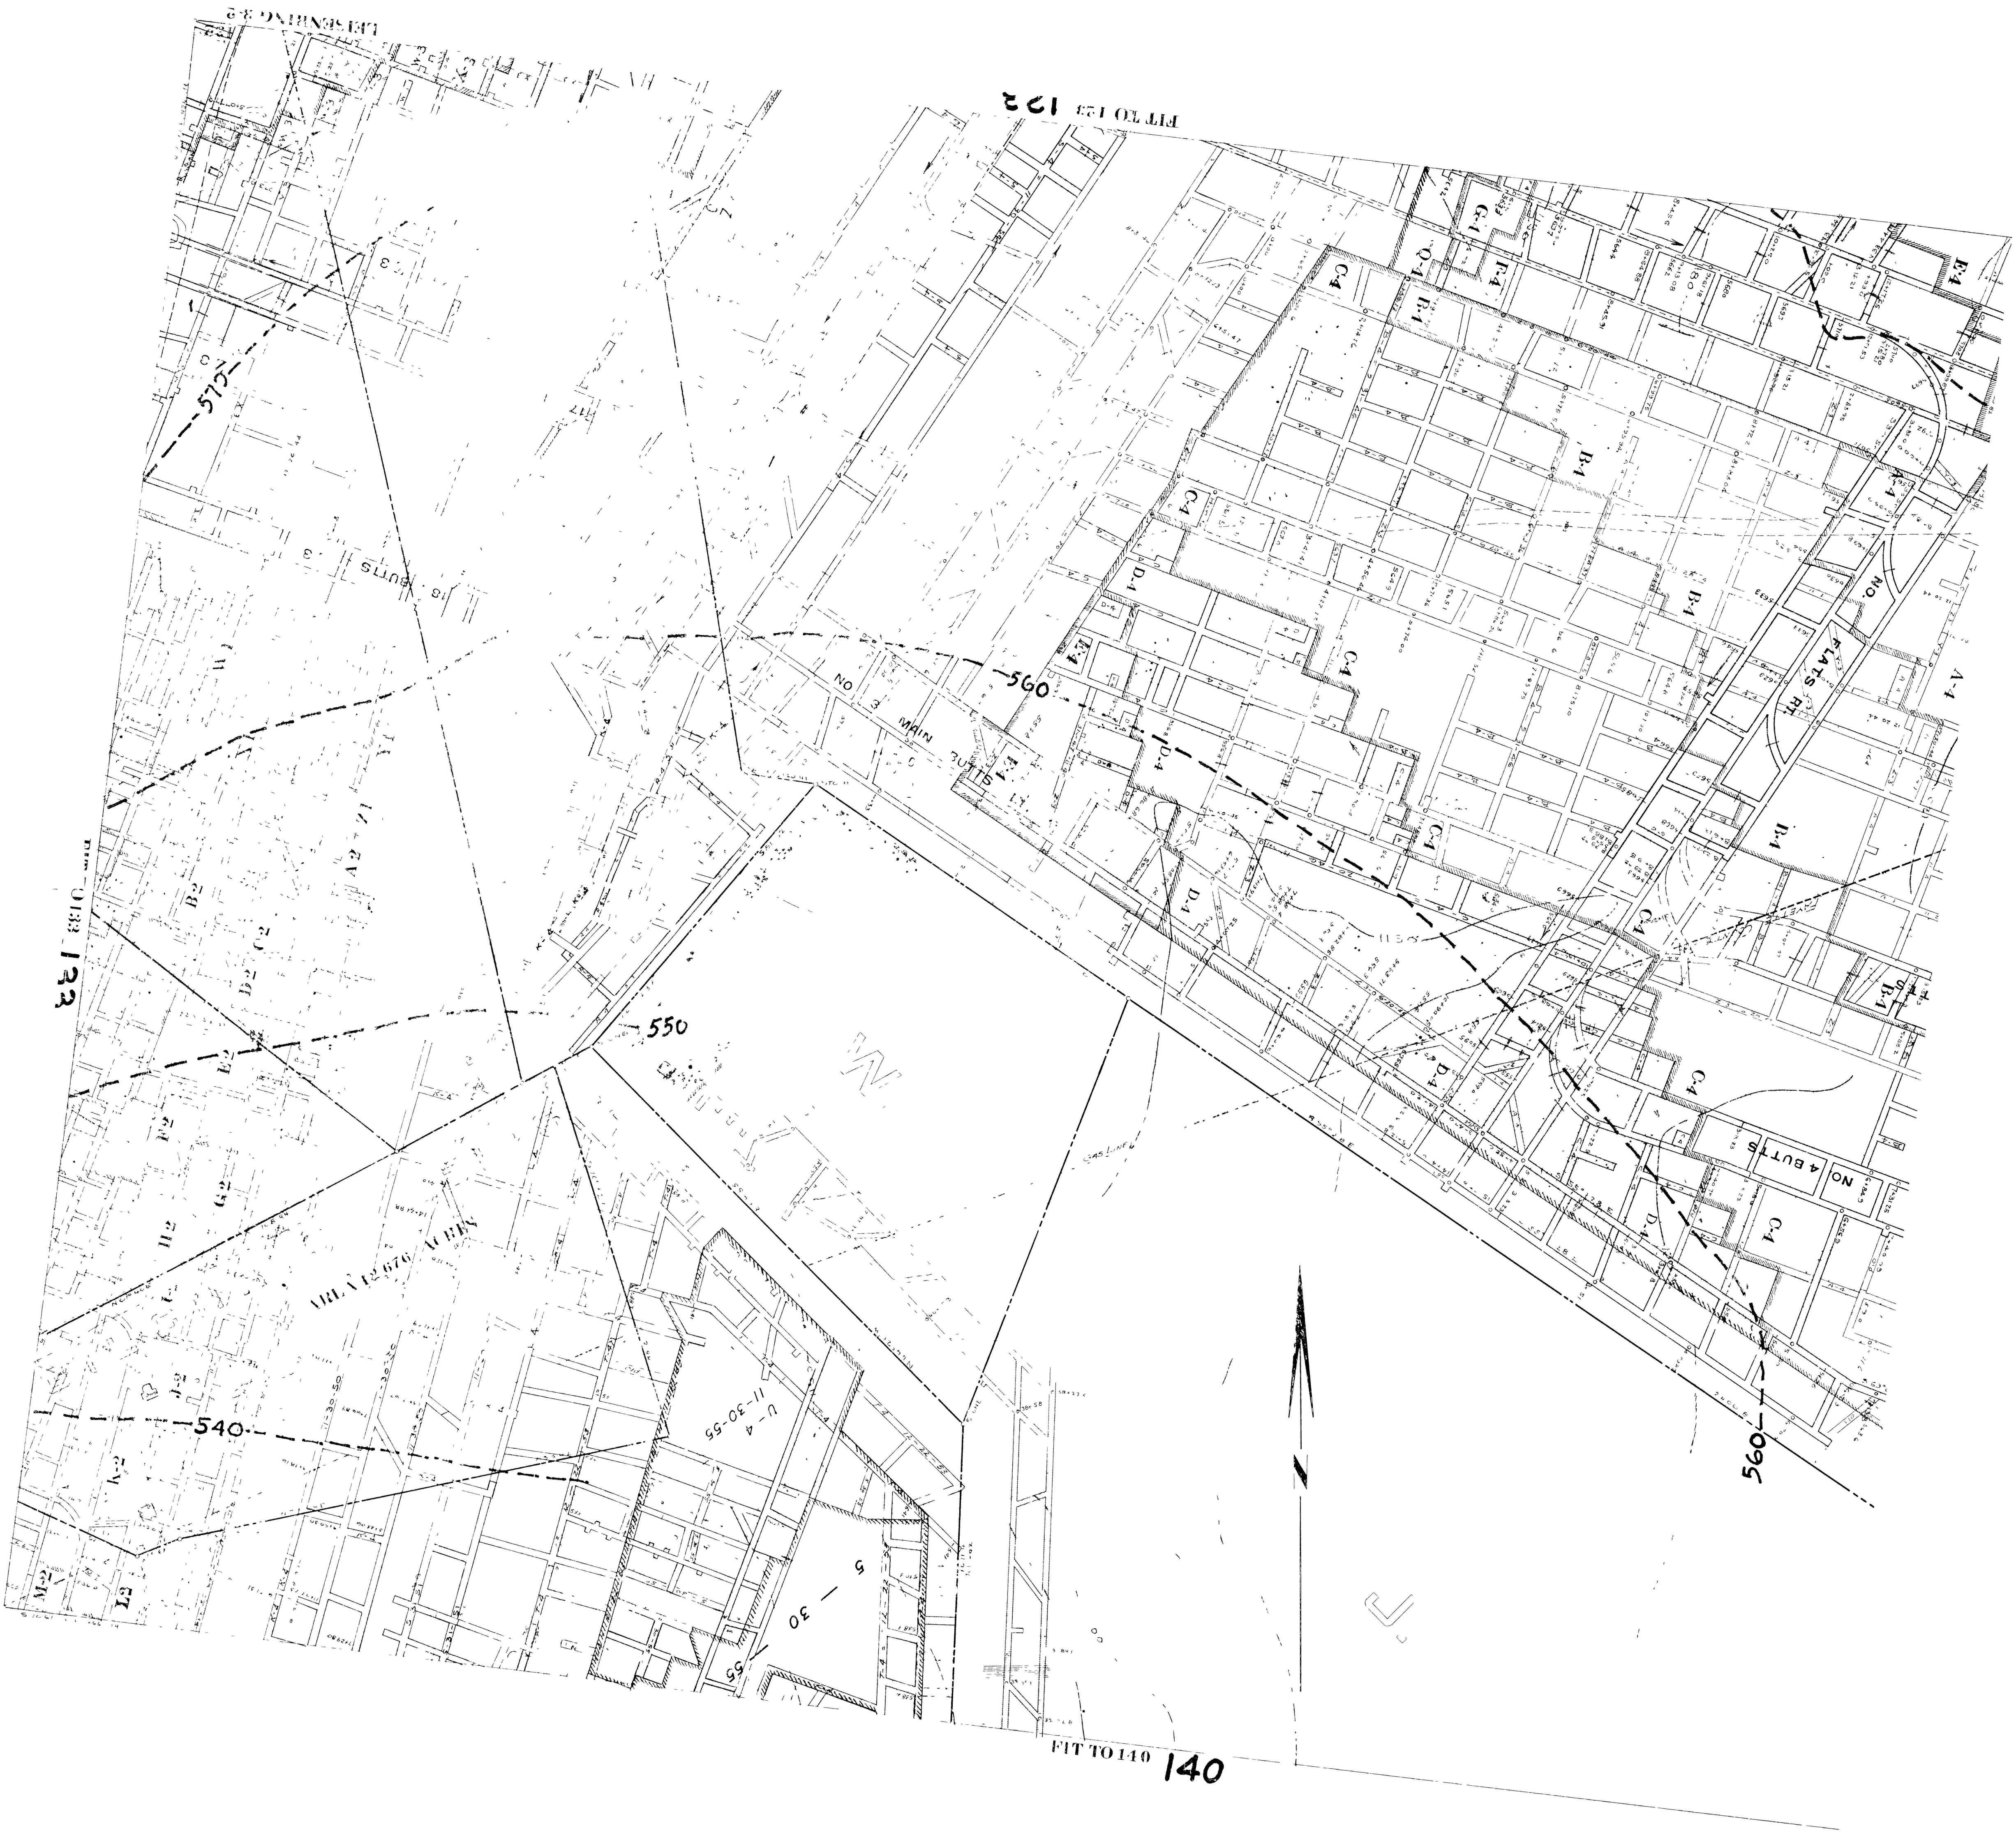

FIT TO 128 122

FIT TO 128 122

FIT TO 140 140