


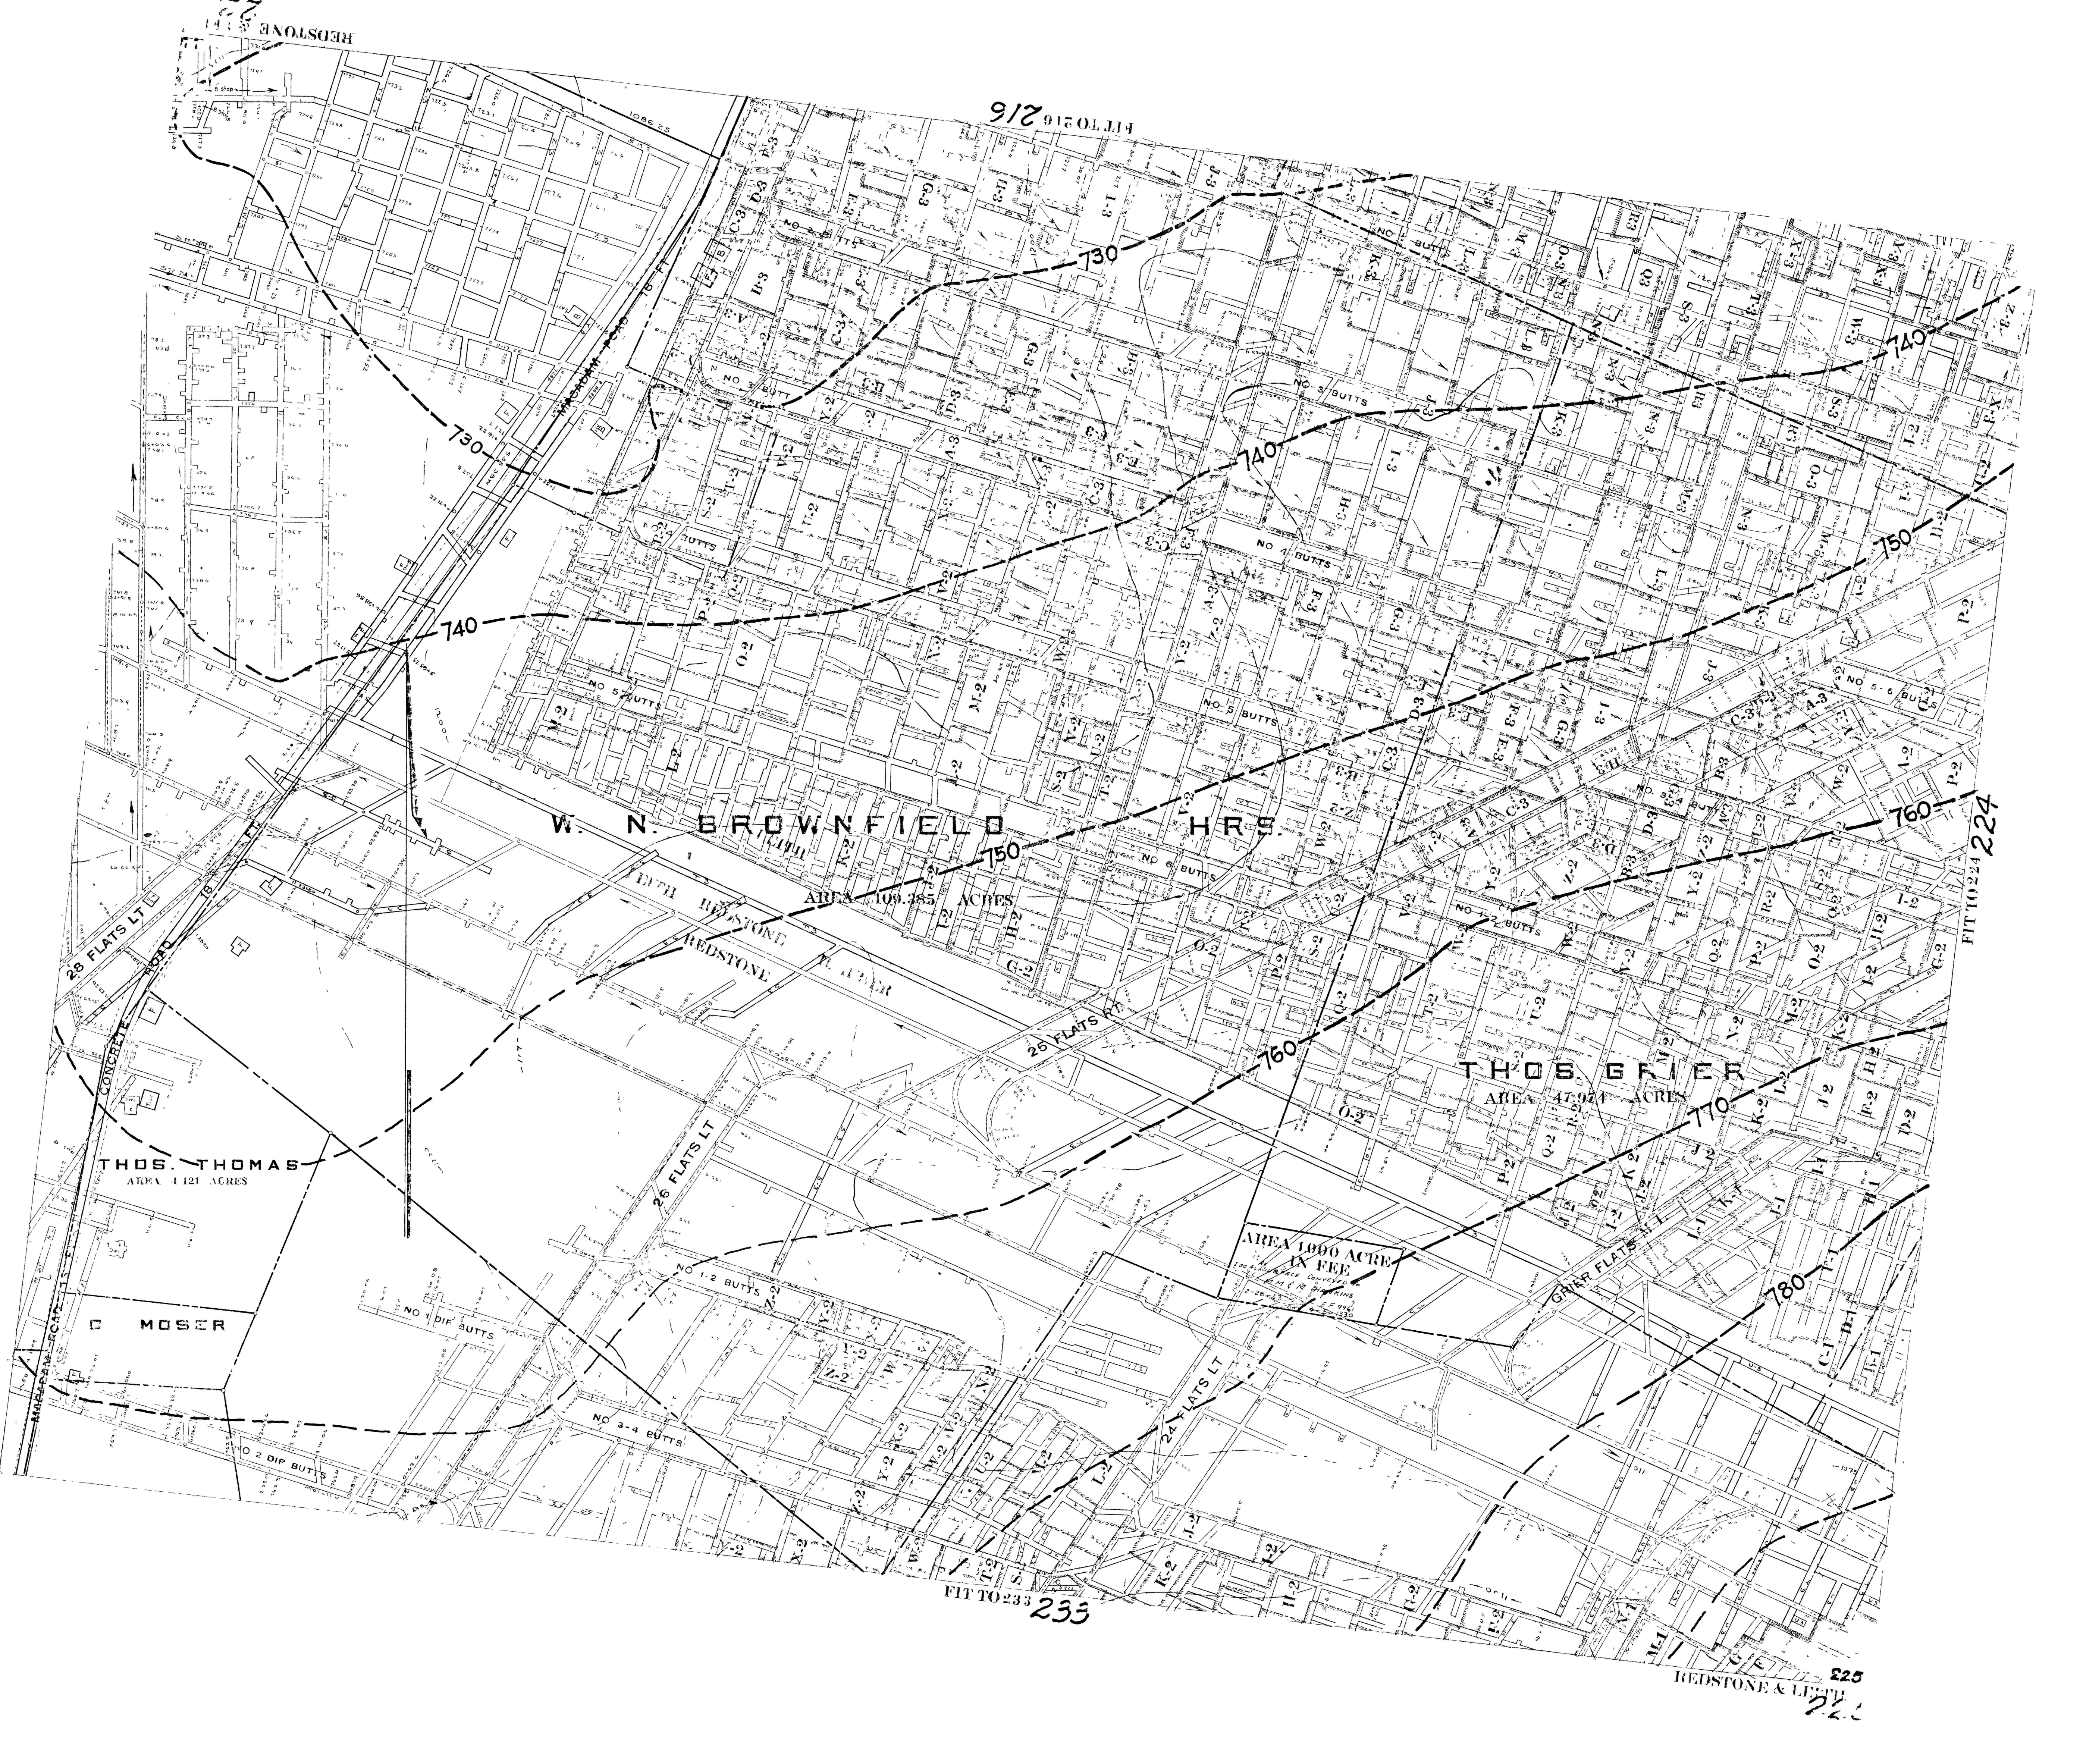

216

233

224

225

REDSTONE & LEE