


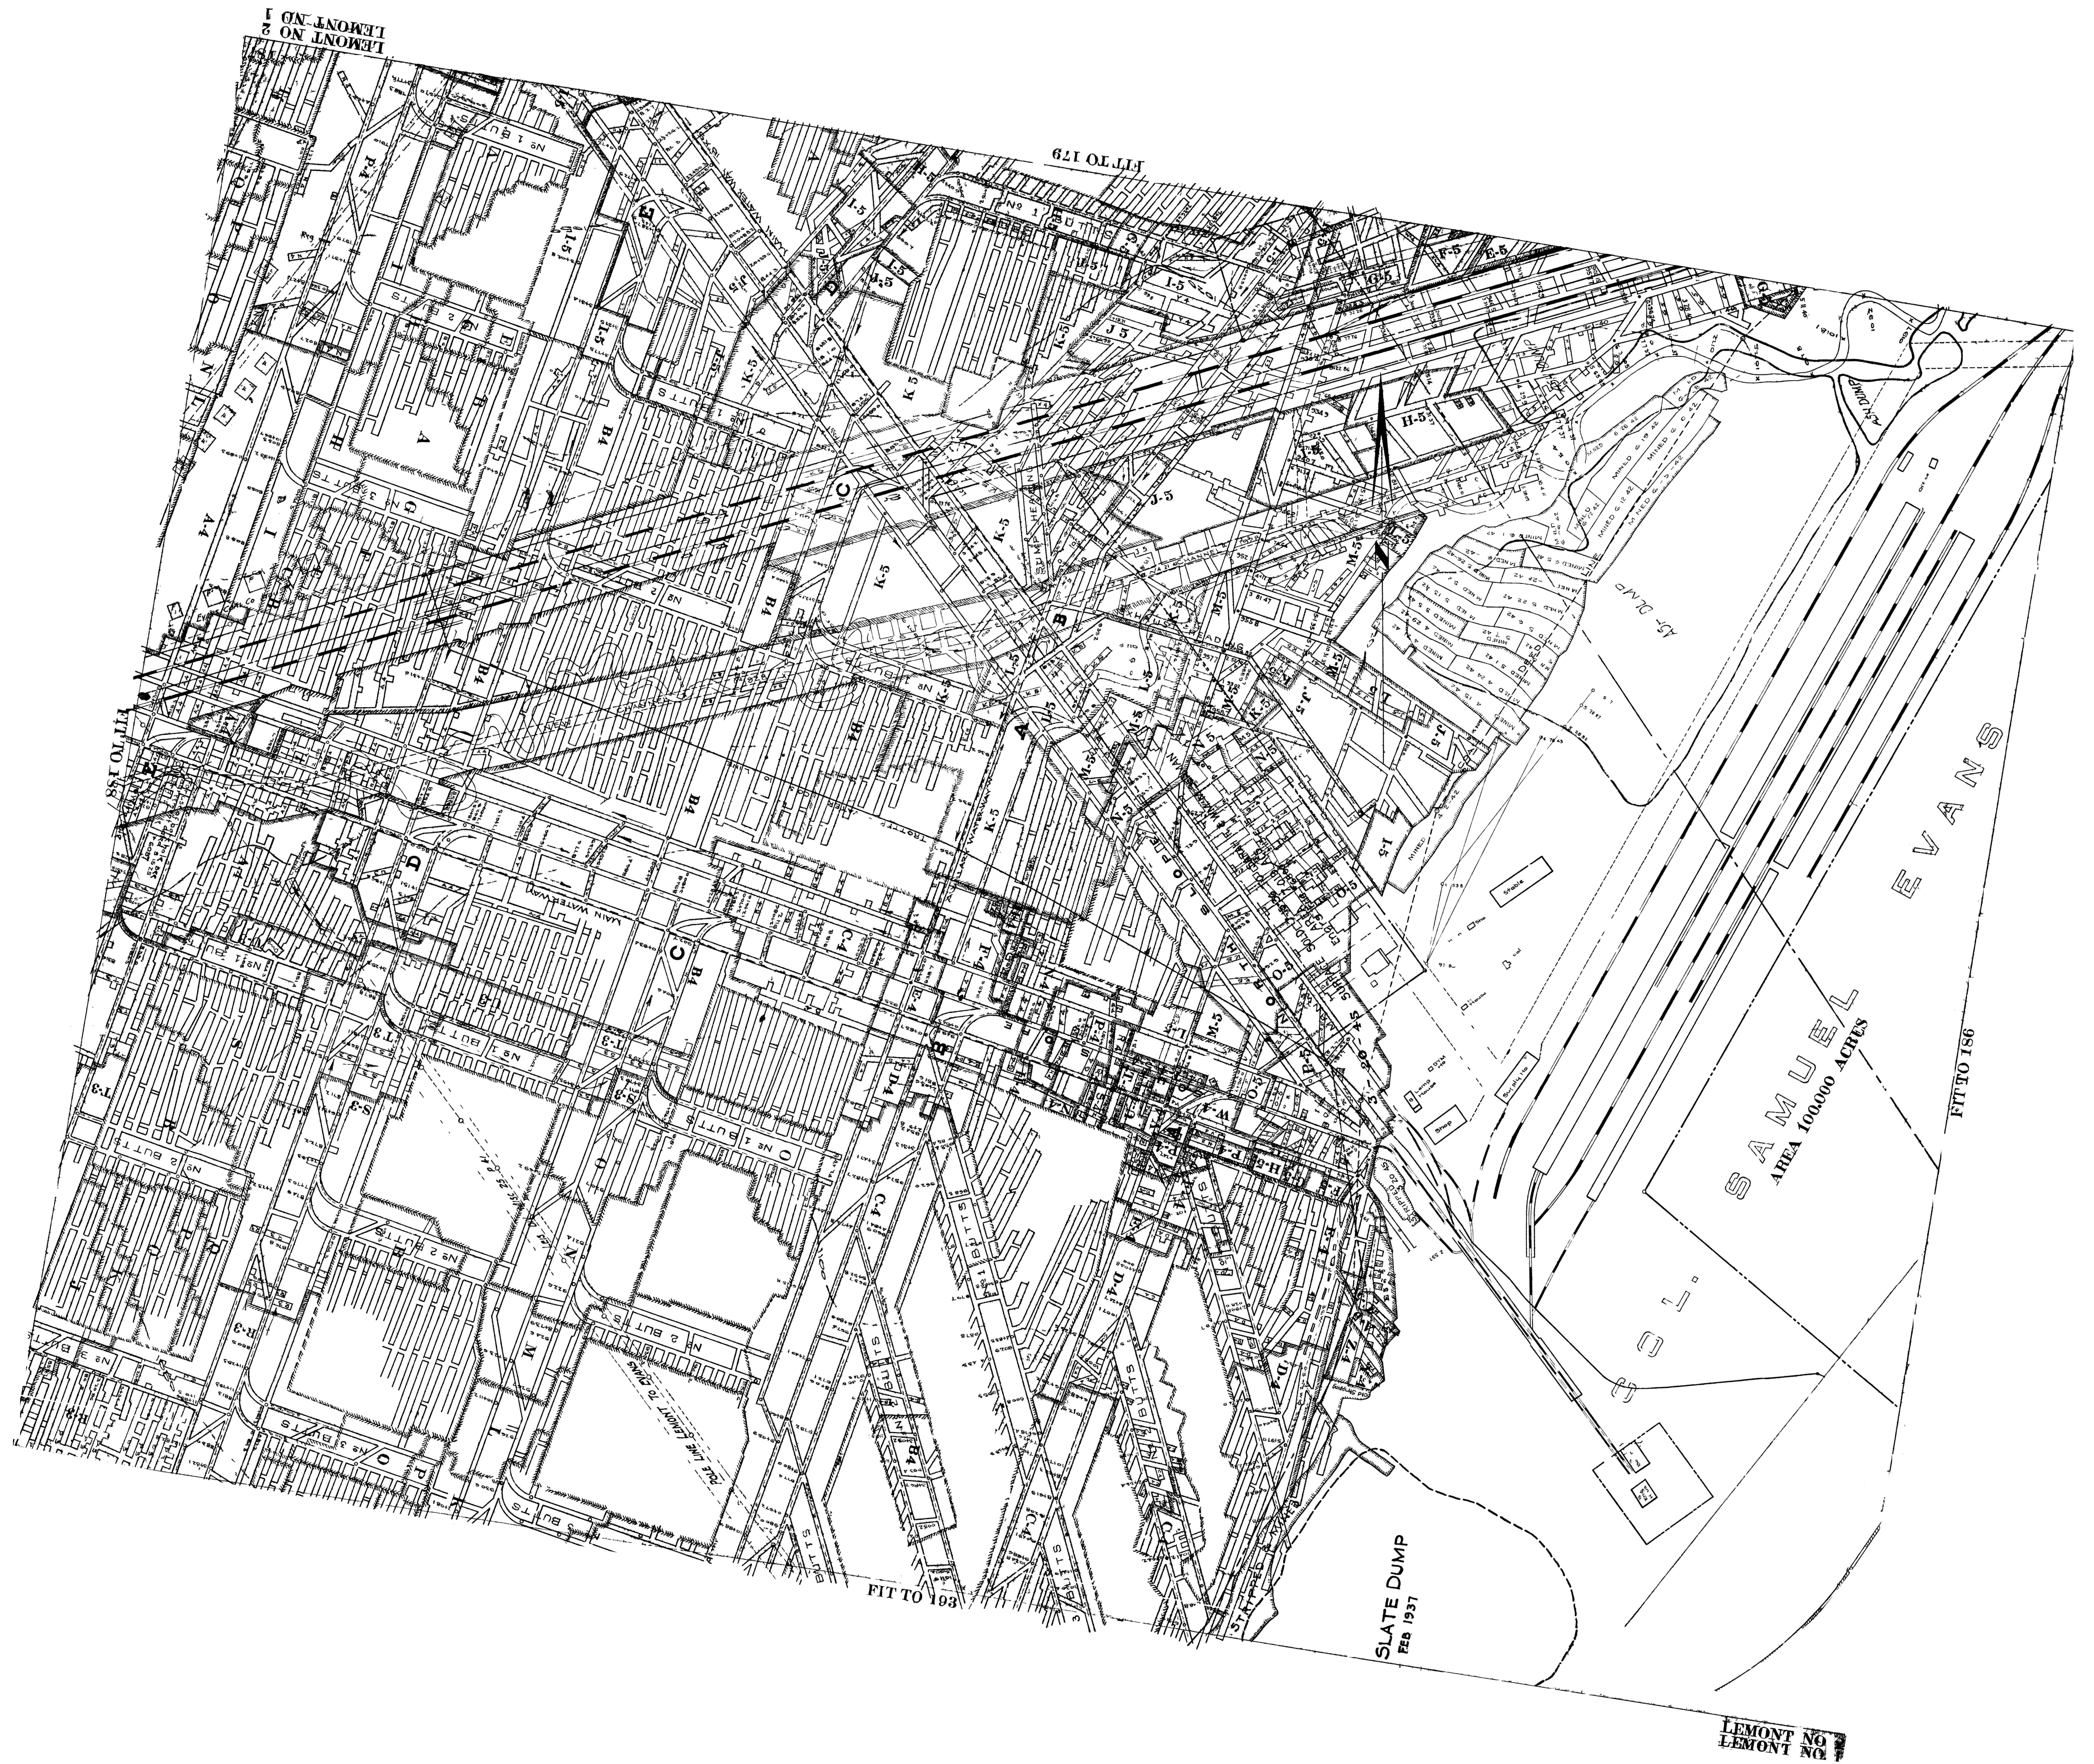

LEMONT NO 2
LEMONT NO 1

FIT TO 179

FIT TO 183

SLATE DUMP
FEB 1937

SAMUEL
AREA 100000 ACRES

FIT TO 186

LEMONT NO
LEMONT NO