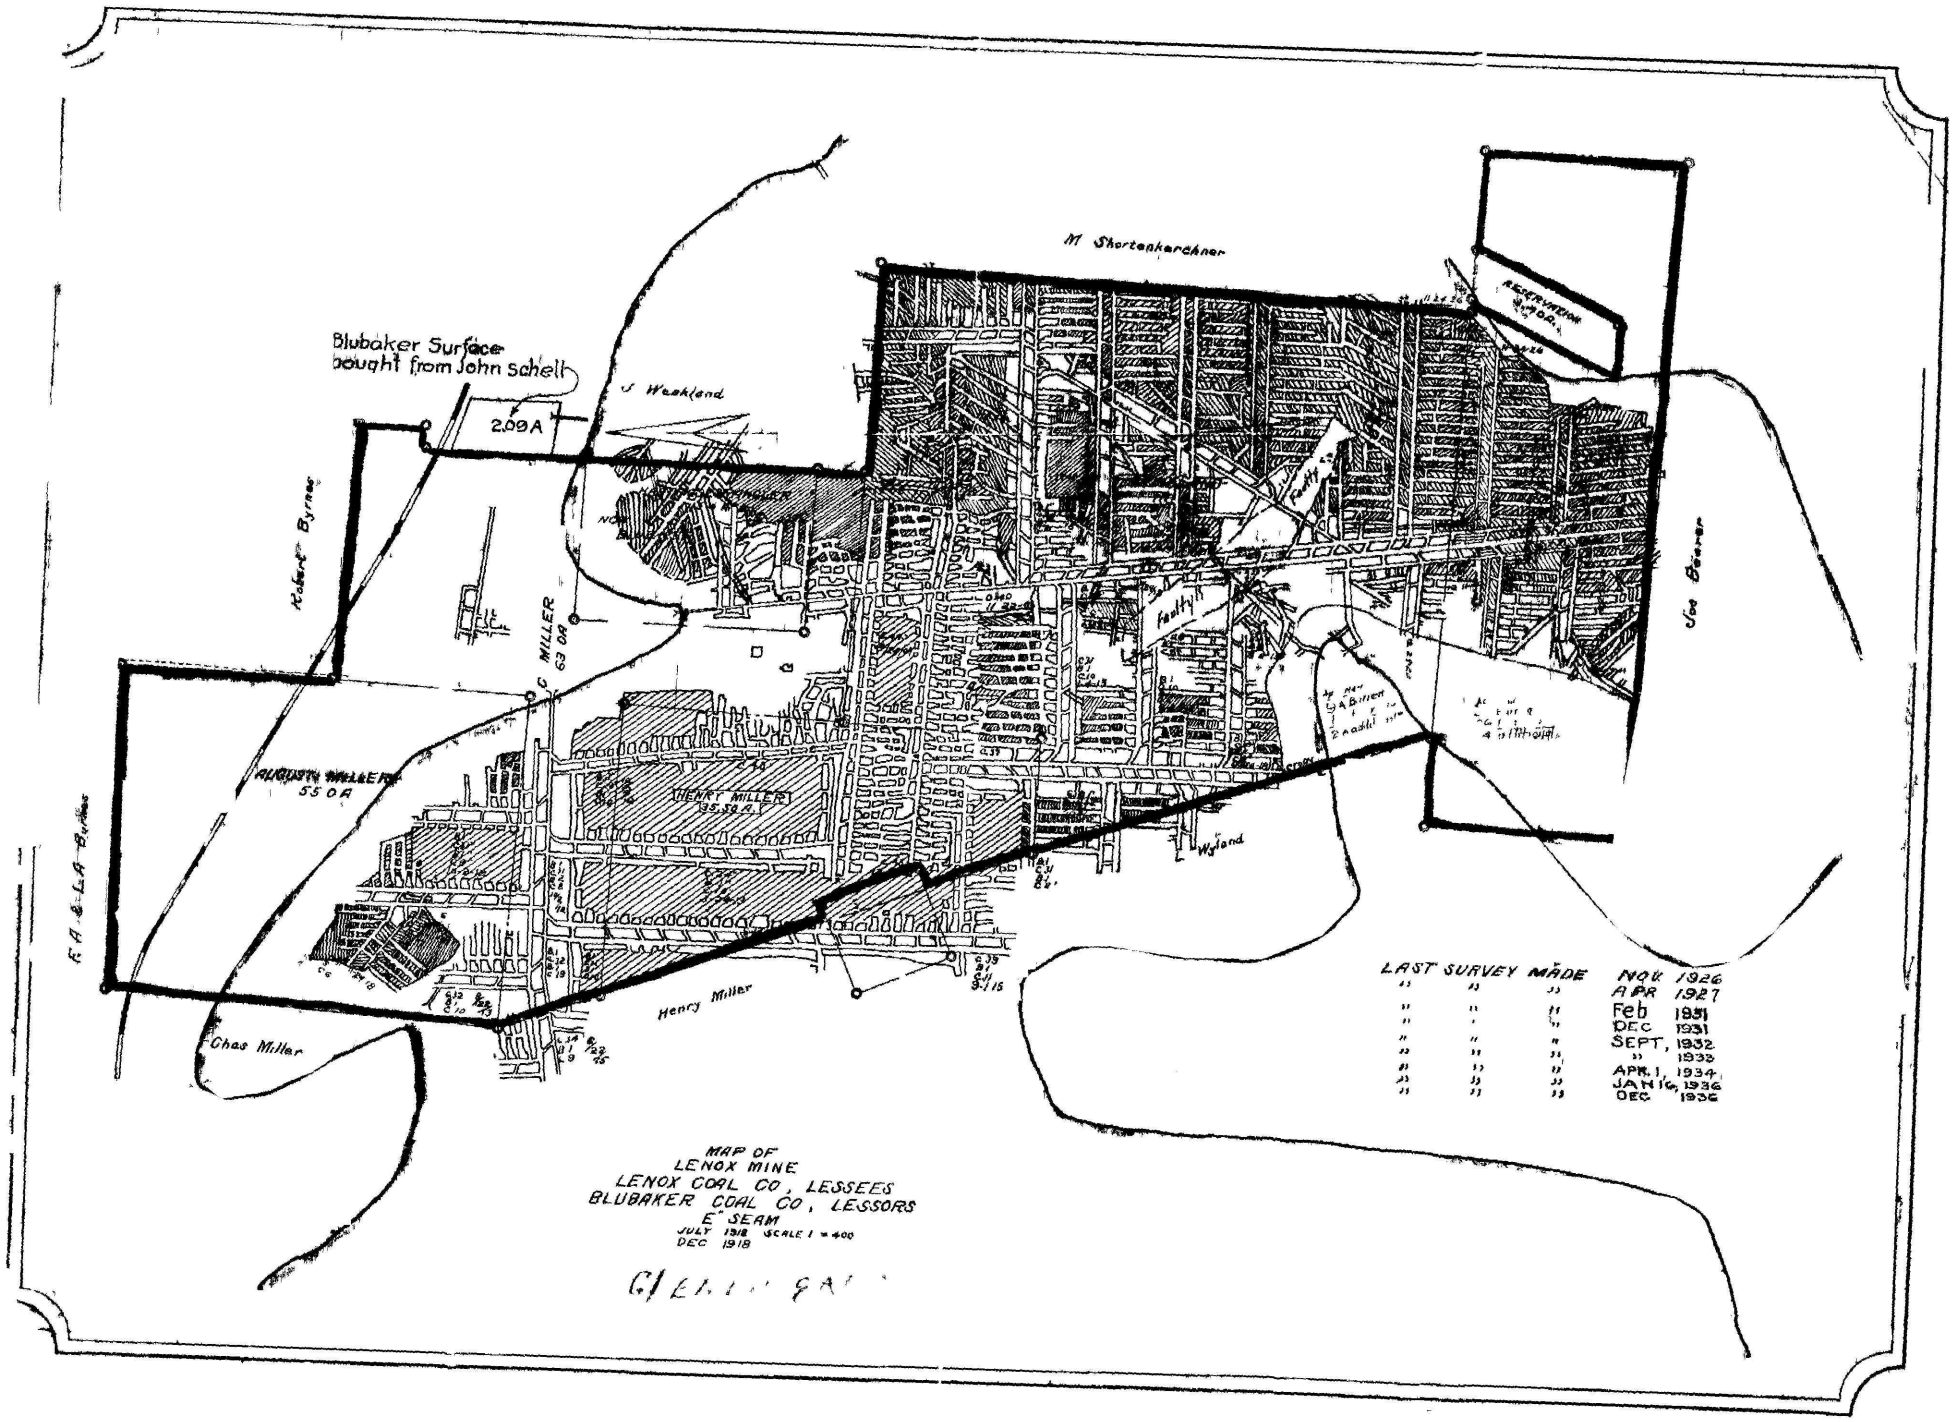
M Shortenkerchner
Blubaker Surface
bought from John Schell
2.09 A
S Weakland
Kelly Byrne
C MILLER
63 OA
AUGUSTUS MILLER
55 OA
HENRY MILLER
Faulty
Faulty
Wyland
Henry Miller
Chas Miller
E A & L A Butler
Joe Beaver
LAST SURVEY MADE
" " " NOV 1926
" " " APR 1927
" " " Feb 1931
" " " DEC 1931
" " " SEPT, 1932
" " " 1932
" " " APR. 1, 1934
" " " JAN 16, 1936
" " " DEC 1936
MAP OF
LENOX MINE
LENOX COAL CO, LESSEES
BLUBAKER COAL CO, LESSORS
E SEAM
JULY 1918 SCALE 1 = 400
DEC 1918