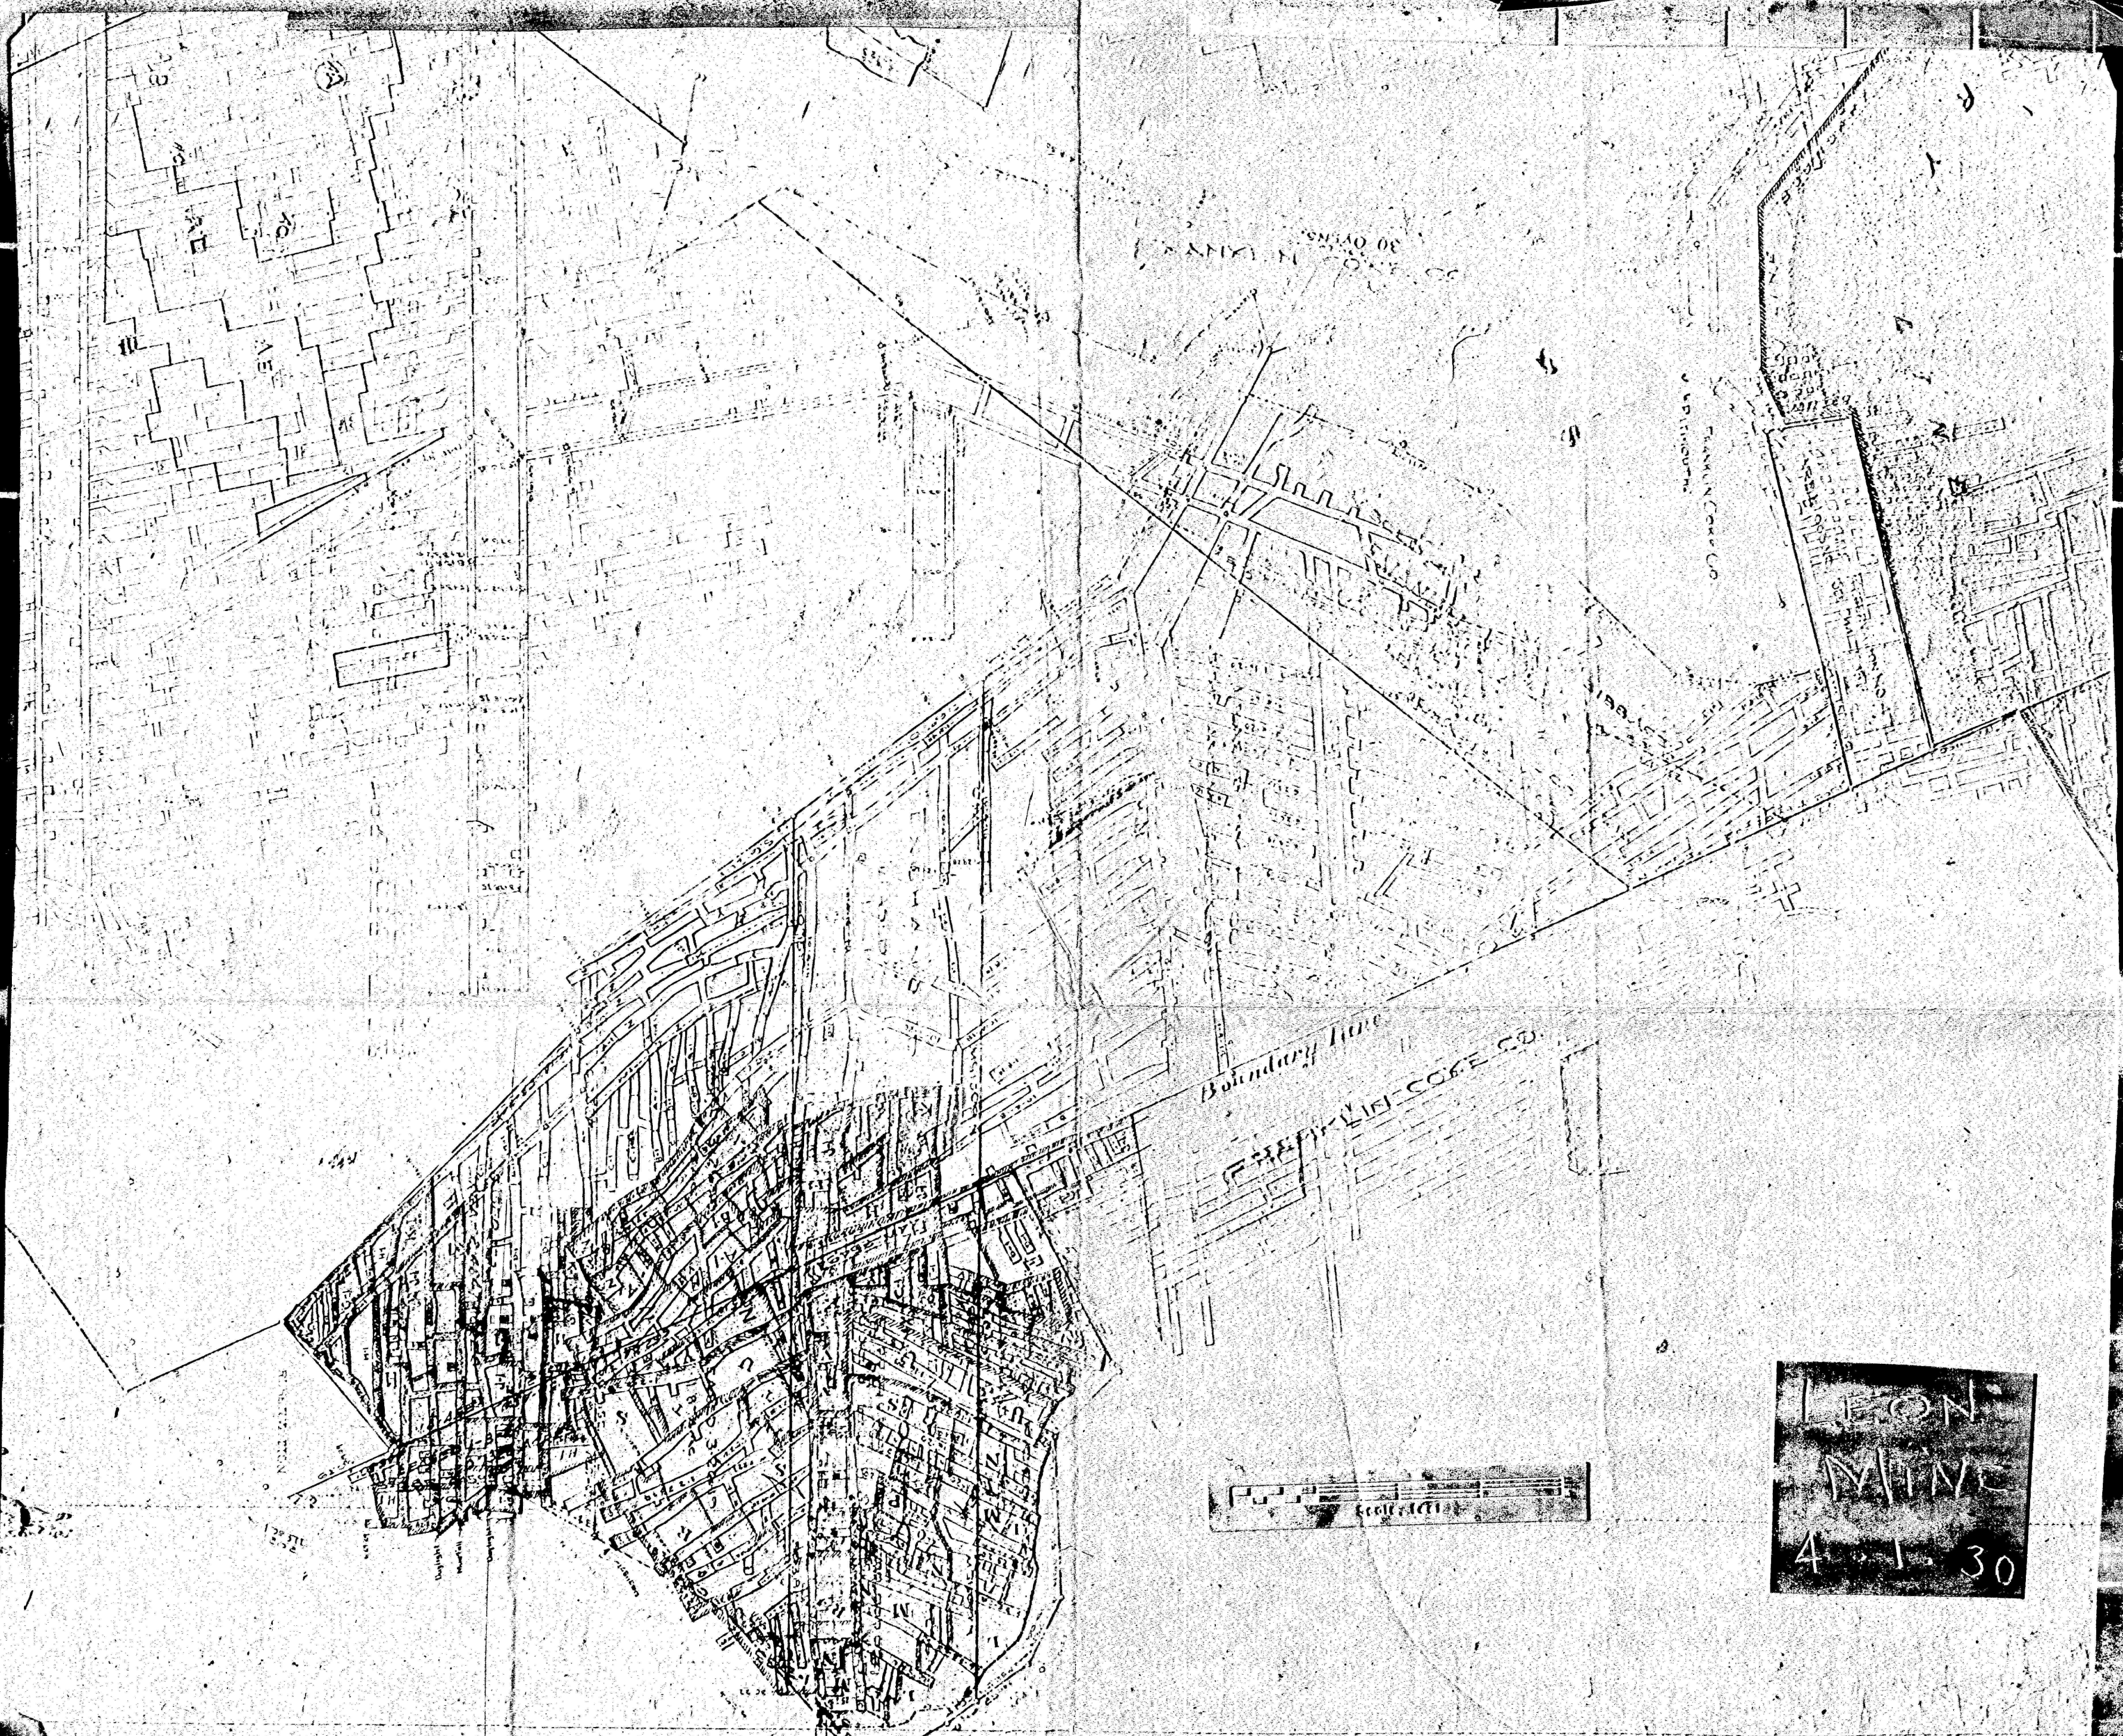


LEON
MINE
4-1-30

FEO

03119 405 20X 344954