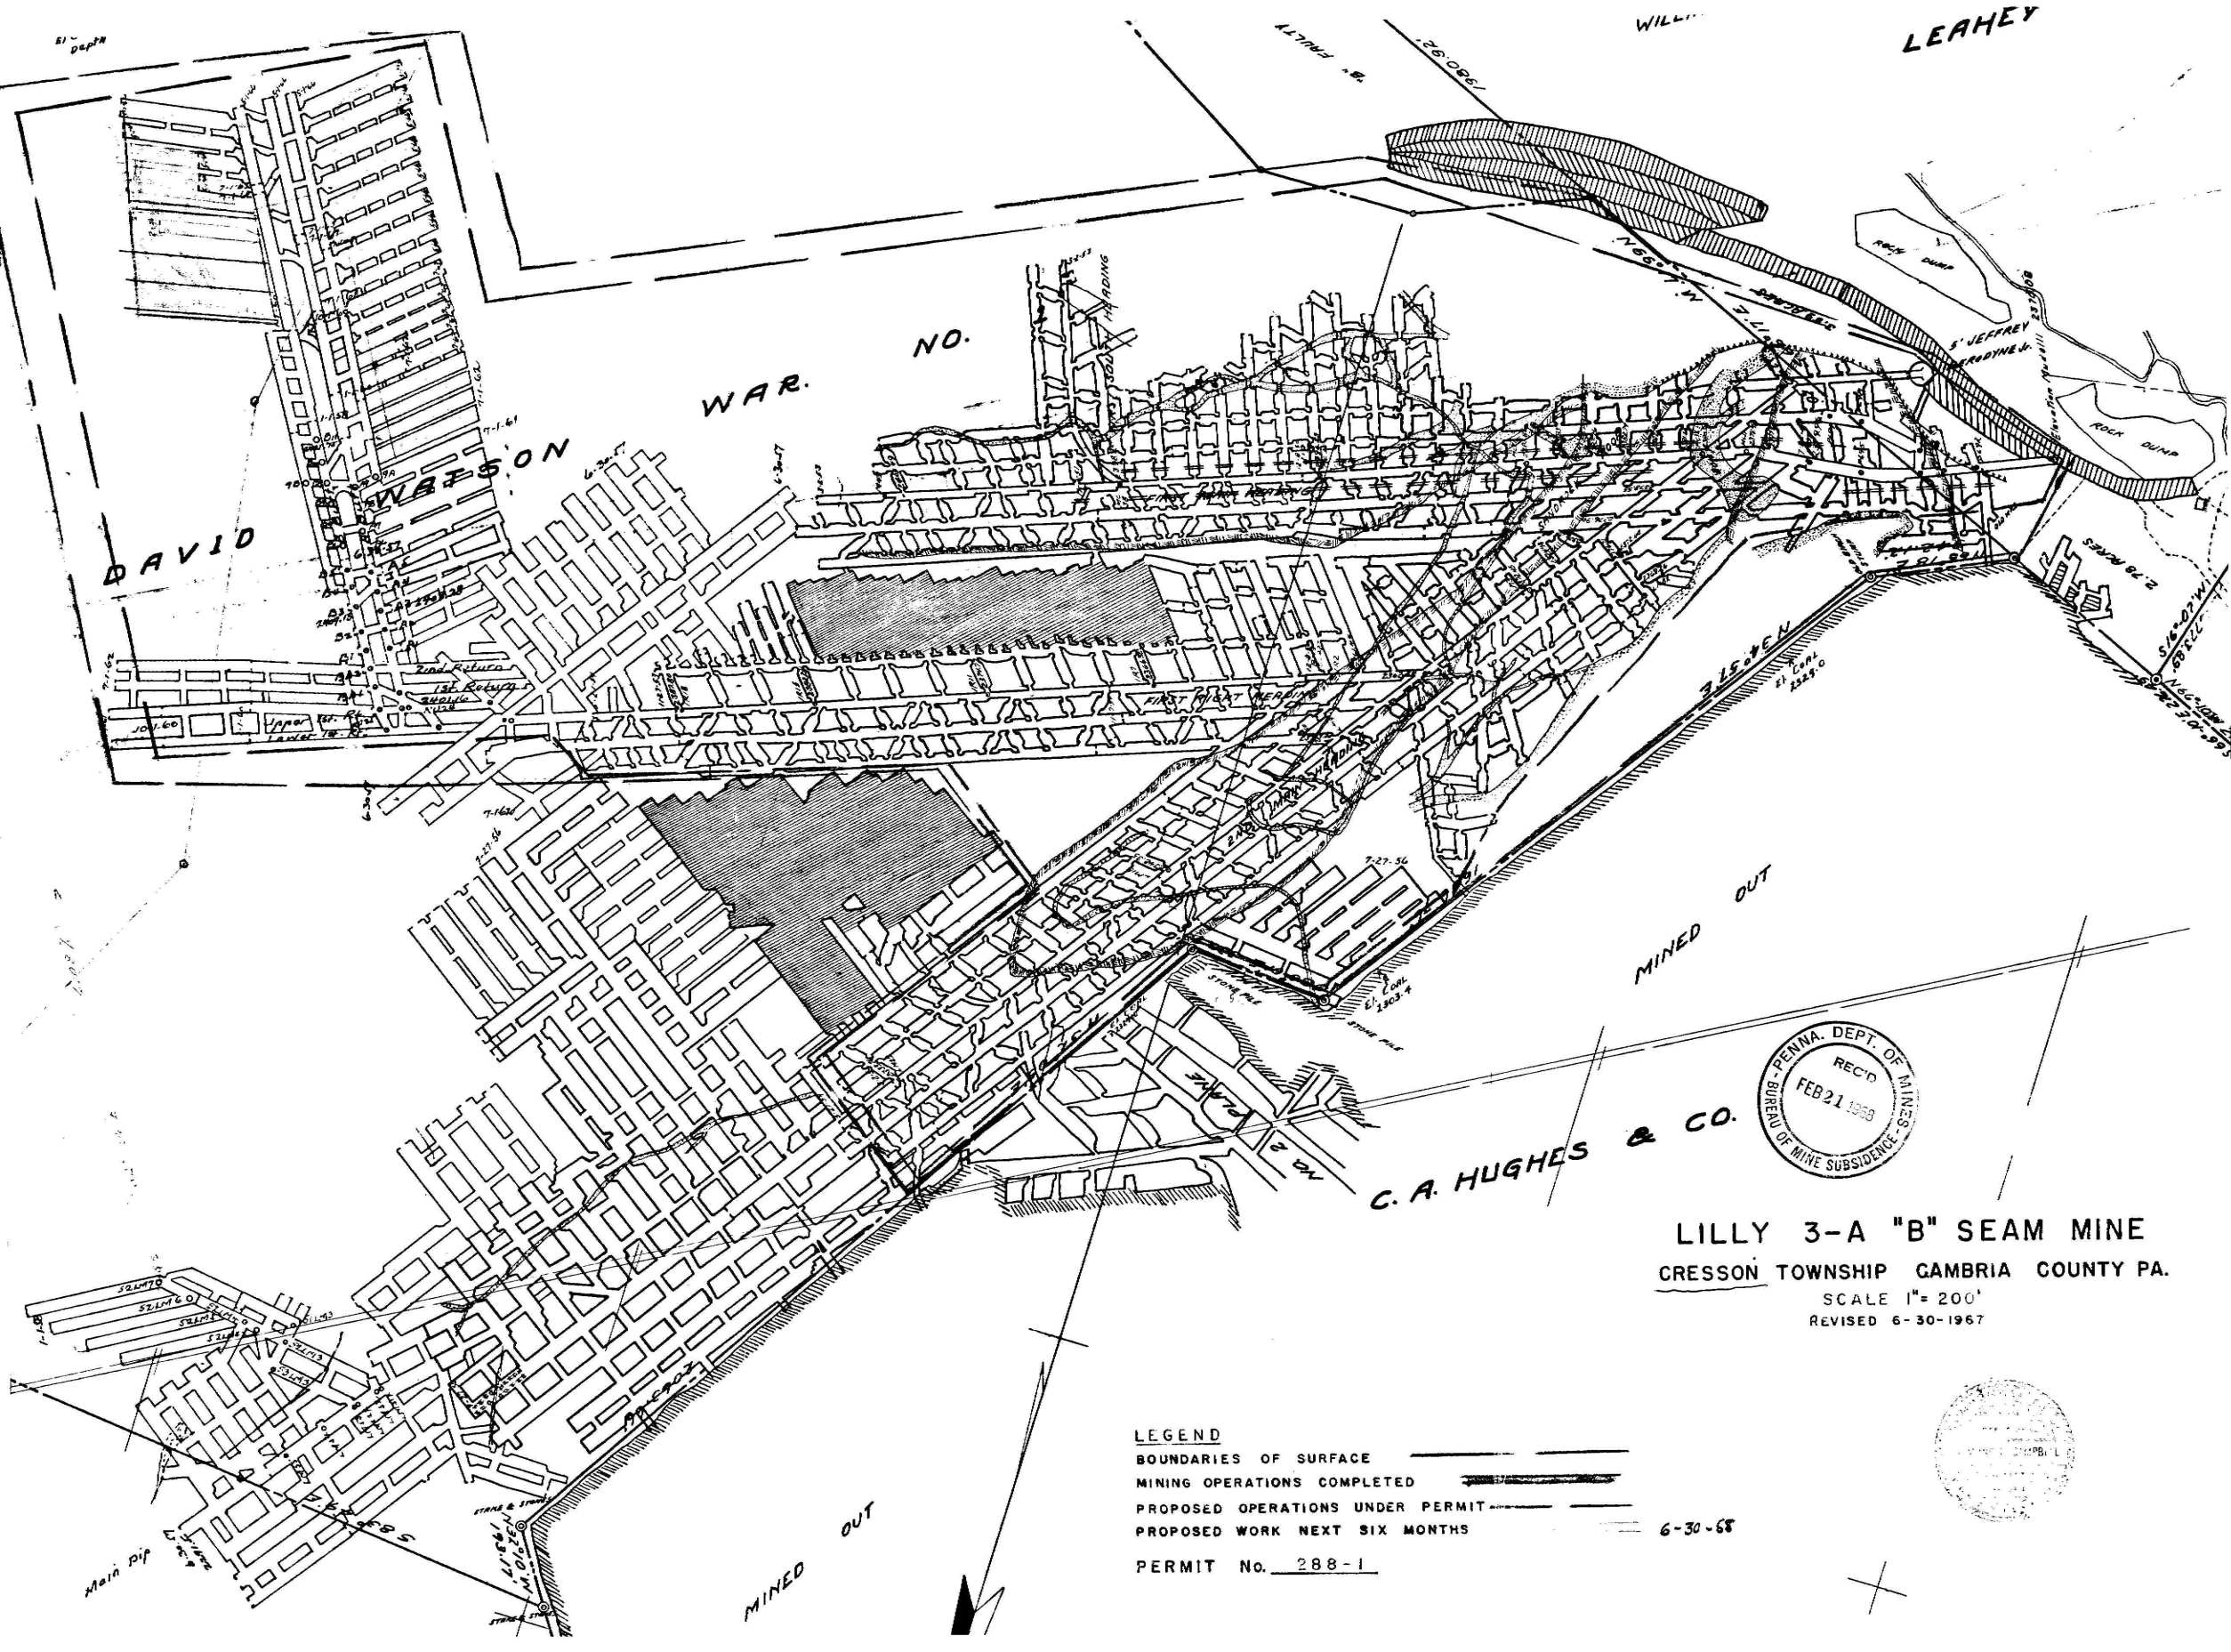

LILLY 3-A "B" SEAM MINE

CRESSON TOWNSHIP CAMBRIA COUNTY PA.

SCALE 1" = 200'

REVISED 6-30-1967

LEGEND

BOUNDARIES OF SURFACE

MINING OPERATIONS COMPLETED

PROPOSED OPERATIONS UNDER PERMIT

PROPOSED WORK NEXT SIX MONTHS 6-30-68

PERMIT No. 288-1