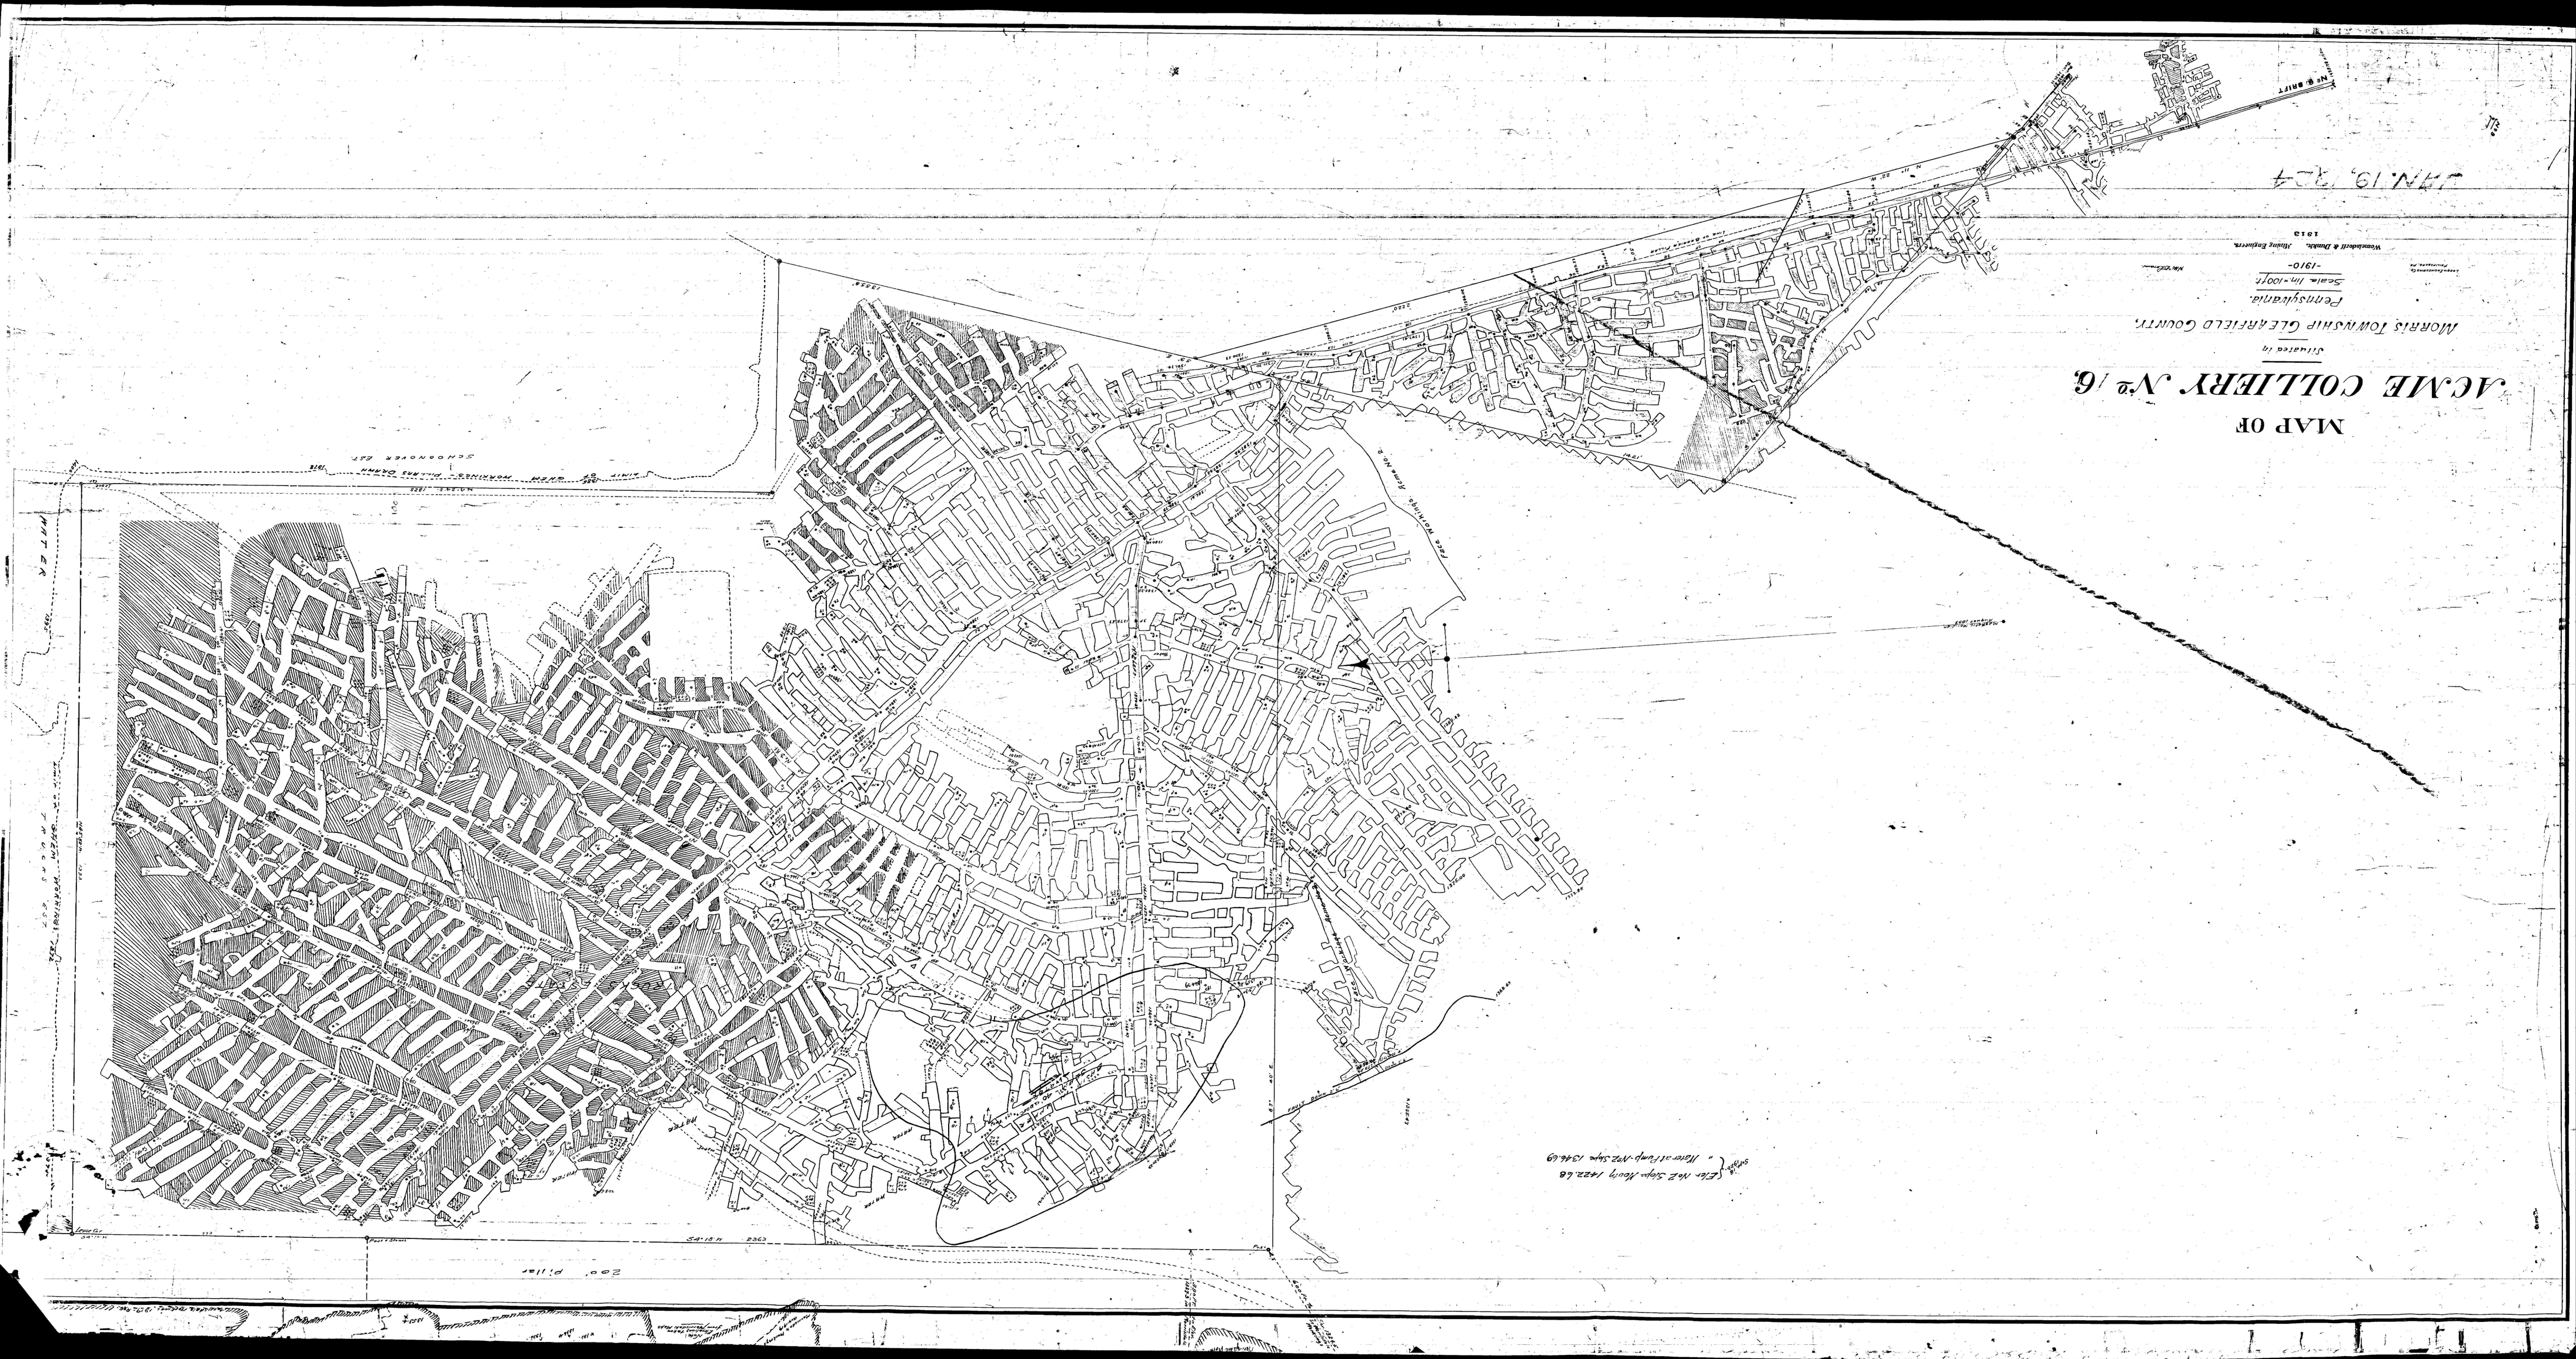
MAP OF
ACME COLLIERY No 16,
situated in
MORRIS TOWNSHIP CLEARFIELD COUNTY,
Pennsylvania.
Scale 1in.=100ft.
-1910-
Westmoland & Dunlap, Mining Engineers.
1913
JAN. 19, '24
Scale 1in.=1000 feet
" 1in.=1chain=1in.=100 feet
200' pillar
SHOOMOKER GAP
PARK MOUNTAIN ROAD
NO. 8 SHAFT