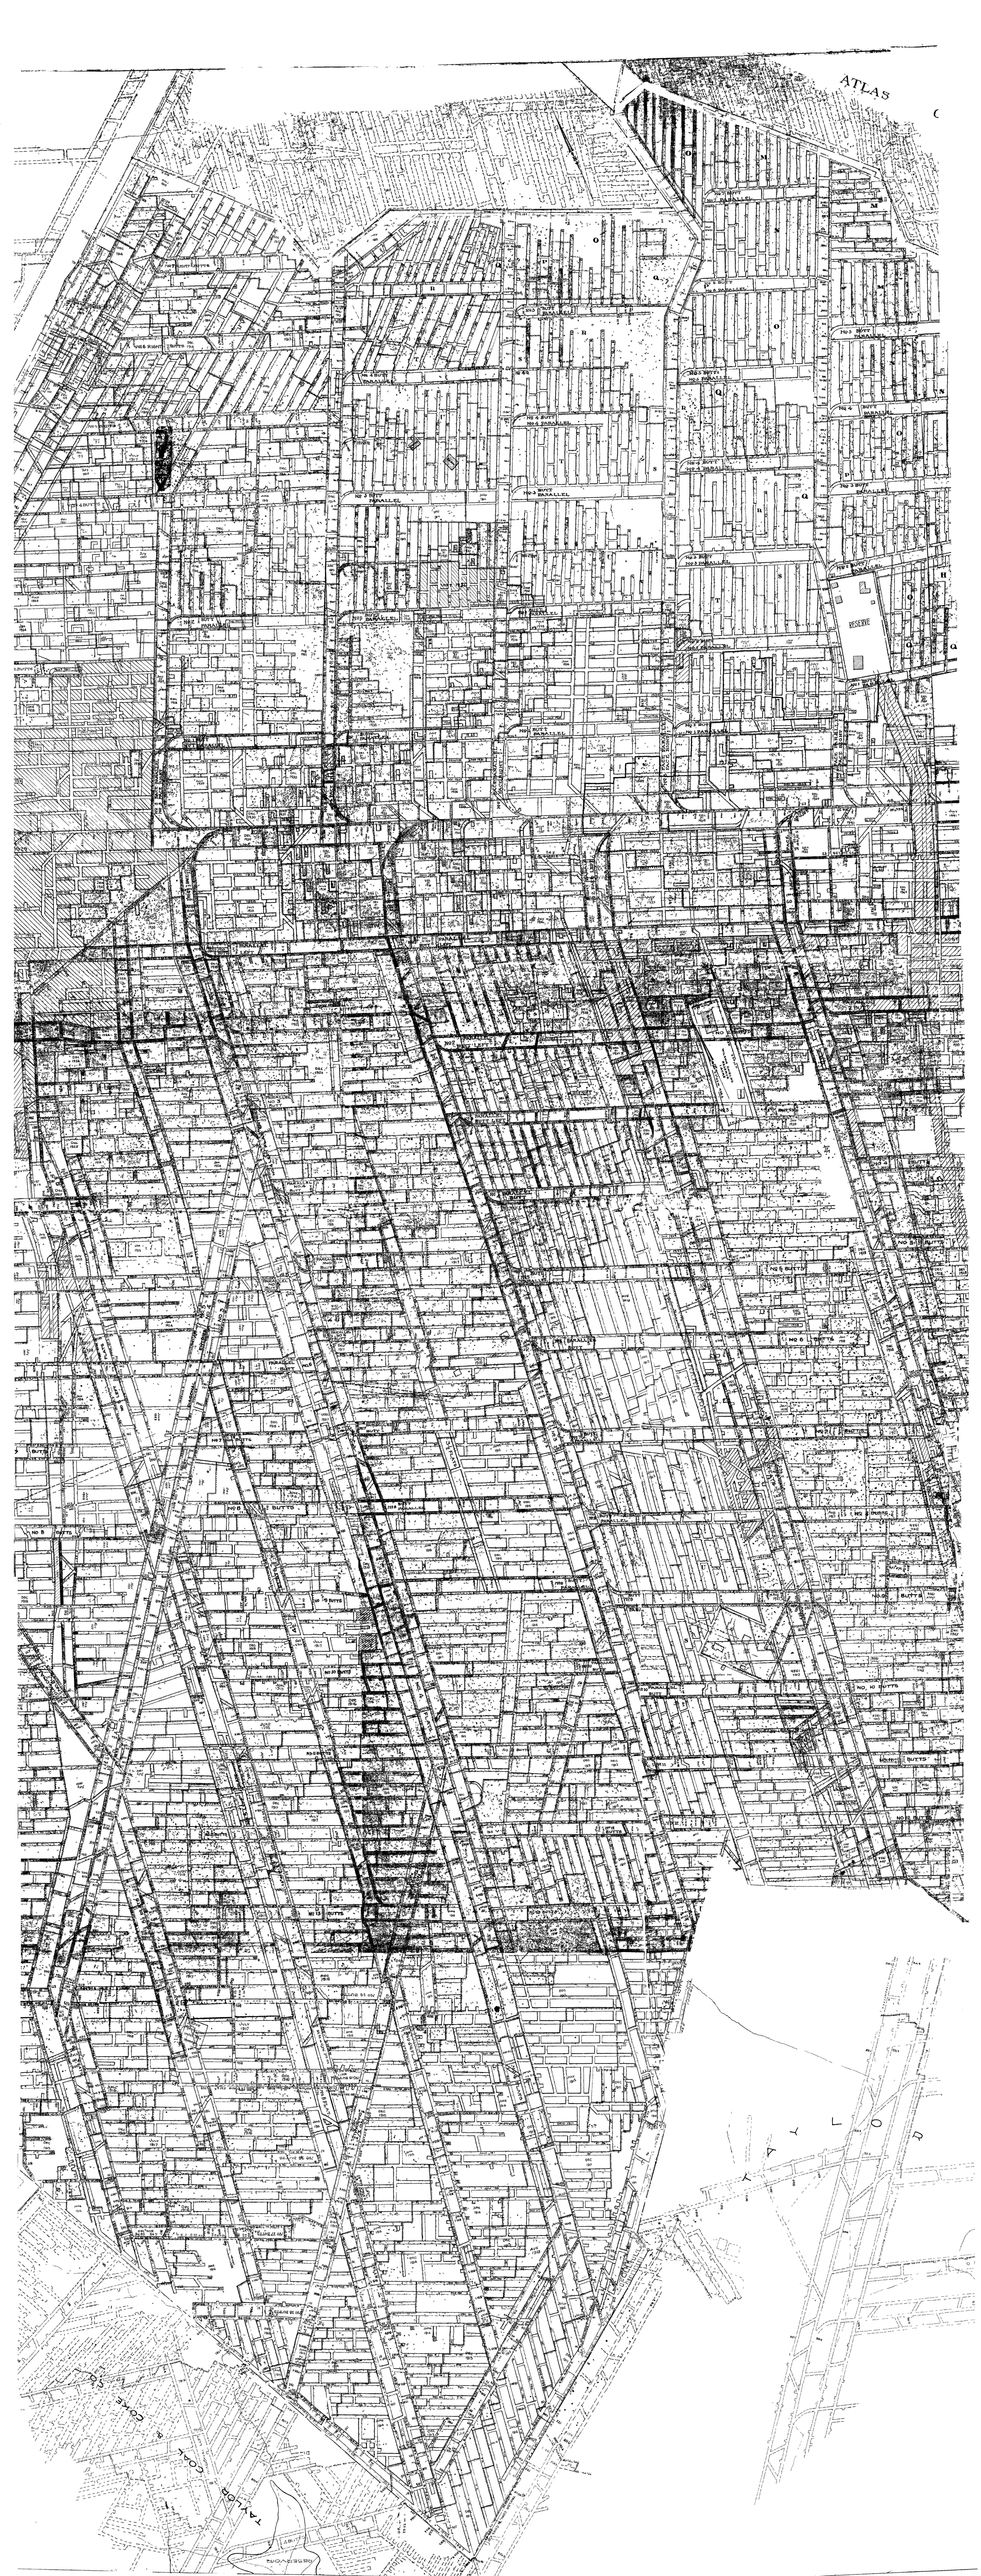

RESERVOIR
TAYLOR COAL & COKE CO.
No 18 BUTTS
No 17 BUTTS
No 16 BUTTS
No 15 BUTTS
No 14 BUTTS
No 13 BUTTS
No 12 BUTTS
No 11 BUTTS
No 10 BUTTS
No 9 BUTTS
No 8 BUTTS
No 7 BUTTS
No 6 BUTTS
No 5 BUTTS
No 4 FLATS
No 3½ FLATS
DIAGONAL
No 1 LEFT FLATS
PARALLEL BUTT LEFT
FACE RIGHT
FACE PARALLEL
No 1 BUTT PARALLEL
No 2 BUTT PARALLEL
No 3 BUTT PARALLEL
No 4 BUTT PARALLEL
No 5 BUTT PARALLEL
No 6 BUTT PARALLEL
No 7 BUTT PARALLEL
No 6 RIGHT BUTTS
No 7 RIGHT BUTTS
RESERVE
ATLAS