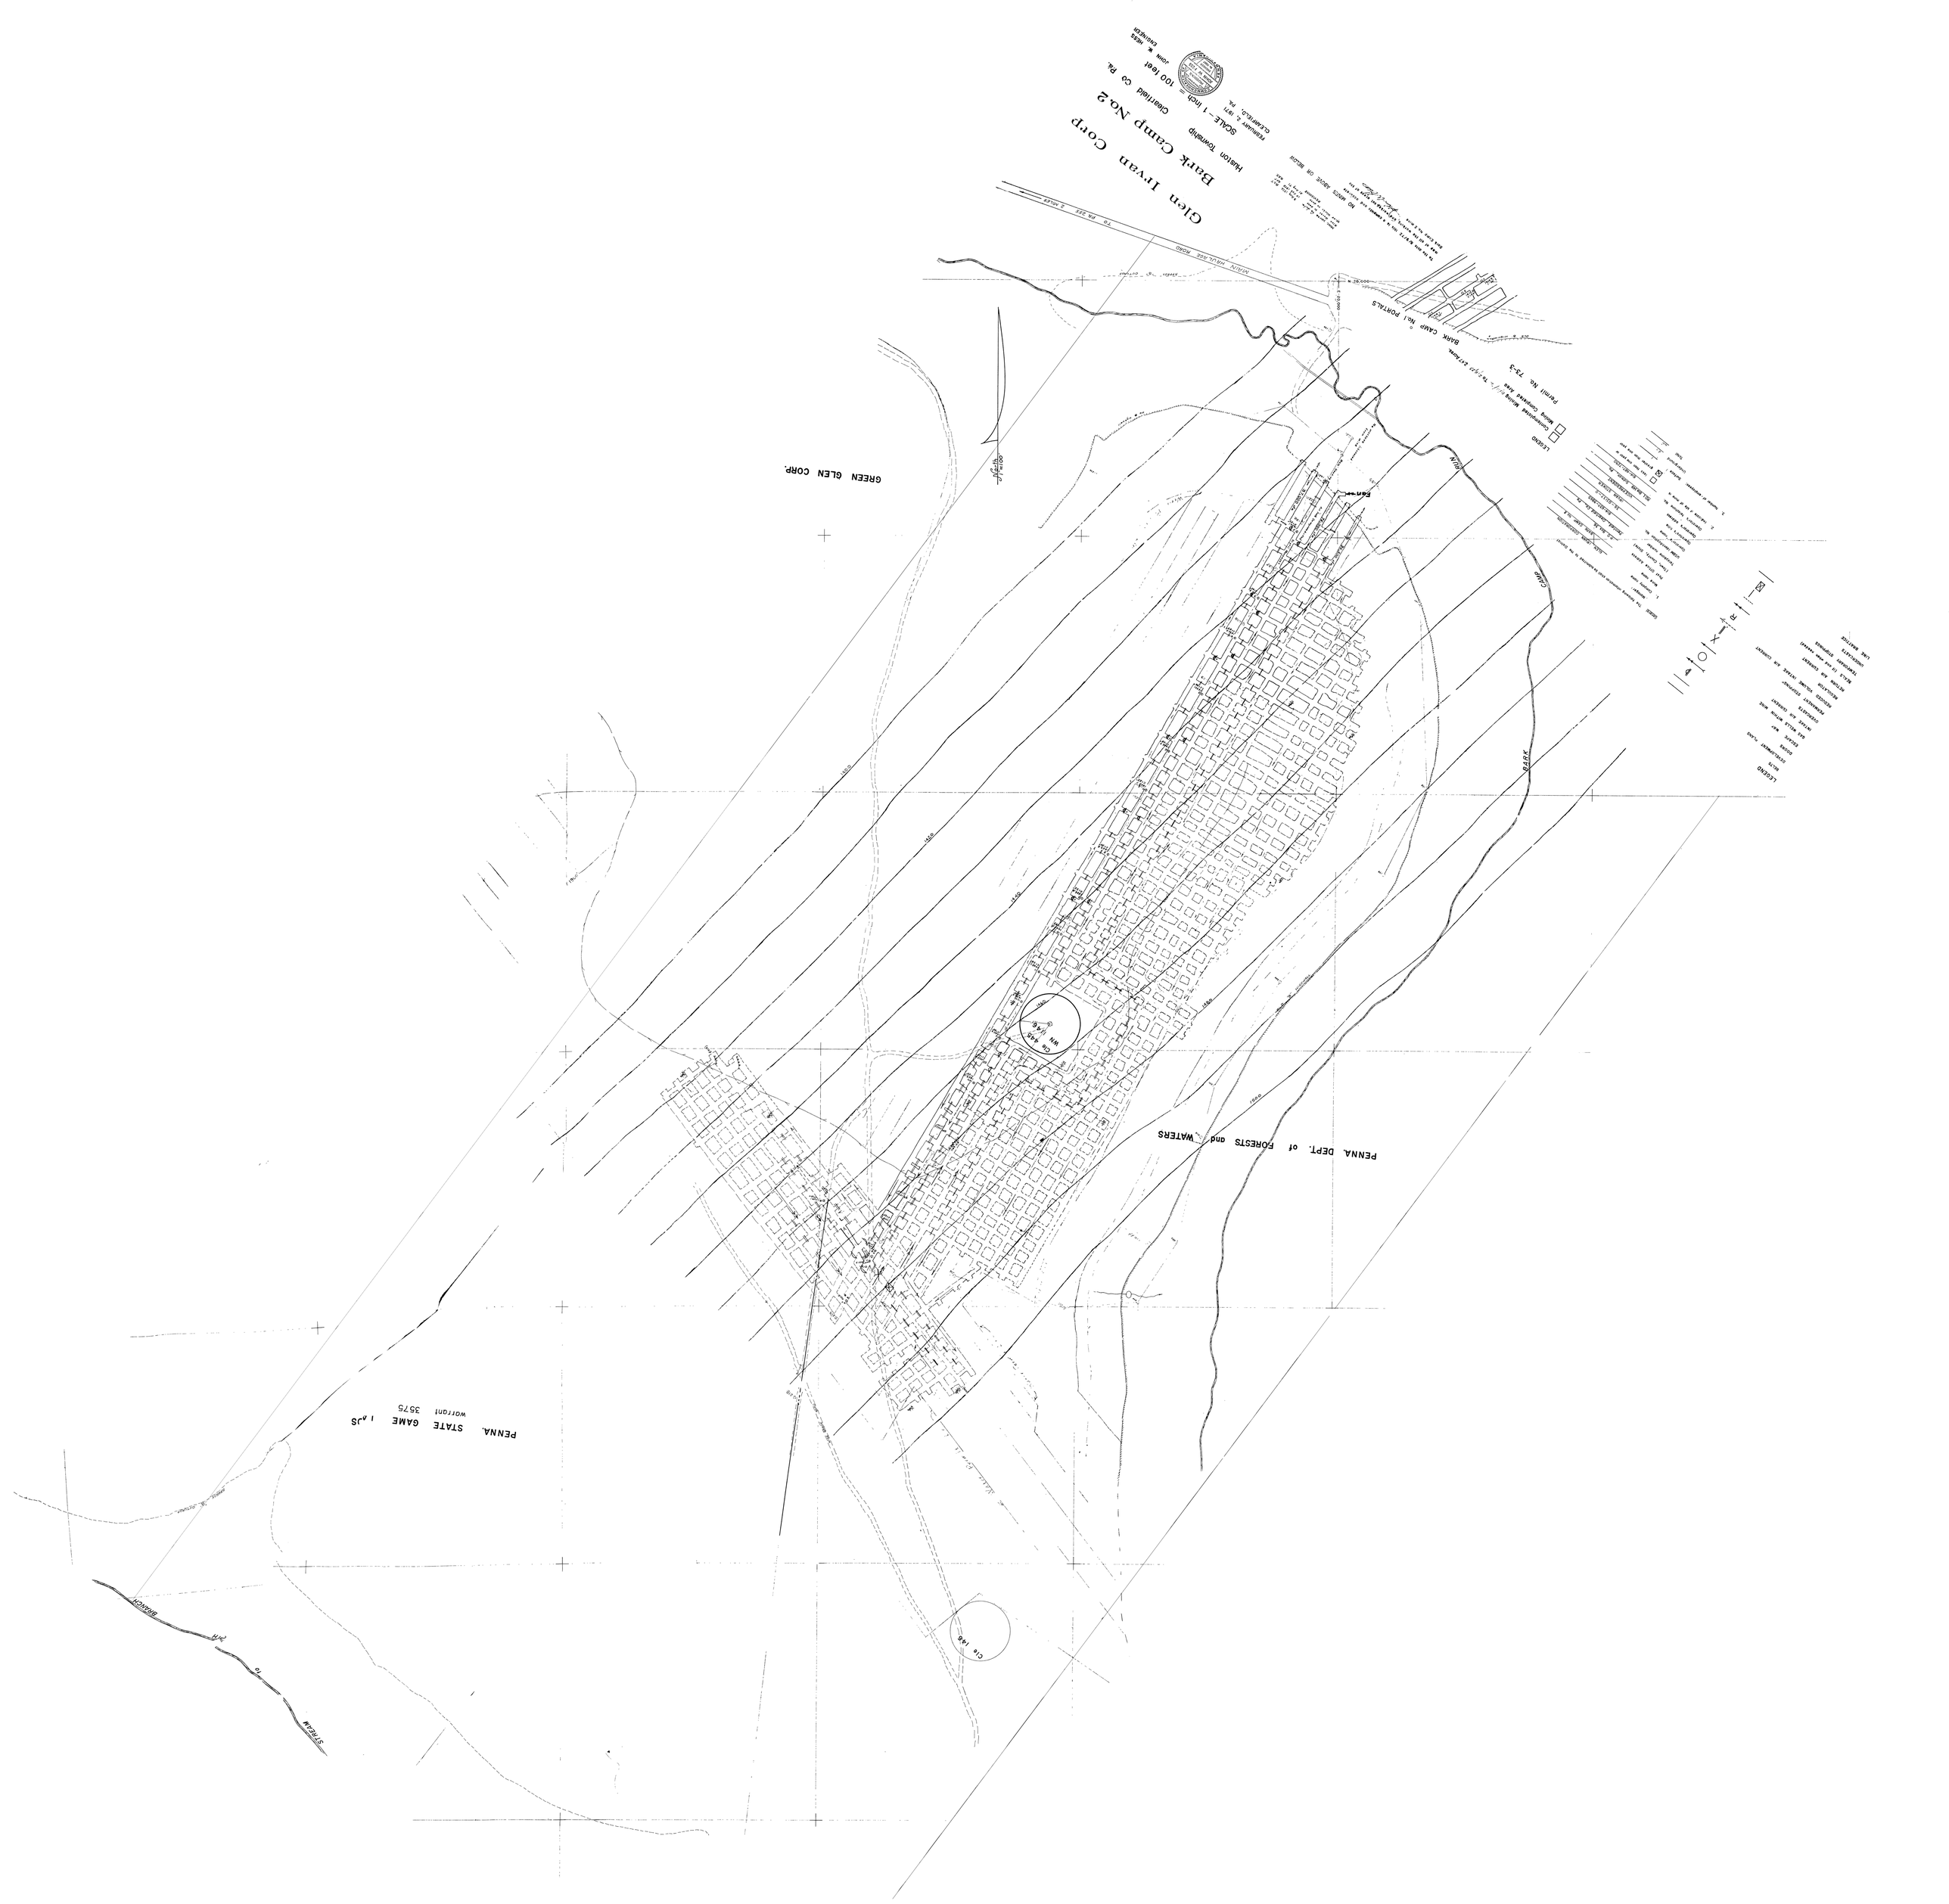
Glen Irvan Corp
Bark Camp No.2
Huston Township Clearfield Co Pa.
SCALE—1 inch = 100 feet
FEBRUARY 5, 1971
CLEARFIELD, PA.
JOHN W. HEBS
CIVIL ENGINEER
NO MINES ABOVE OR BELOW
MAIN HAUL ROAD
TO PA. 255 & MOSHANNON
BARK CAMP No.1 PORTALS
Permit No. 73-3
Commercial Mining of the Bark Camp Area
Mining Completed Area
LEGEND
GREEN GLEN CORP.
BARK CAMP
PENNA. DEPT. of FORESTS and WATERS
PENNA. STATE GAME LANDS
Worrant 3575
STREAM to Moshannon
Old 448
Old 148