


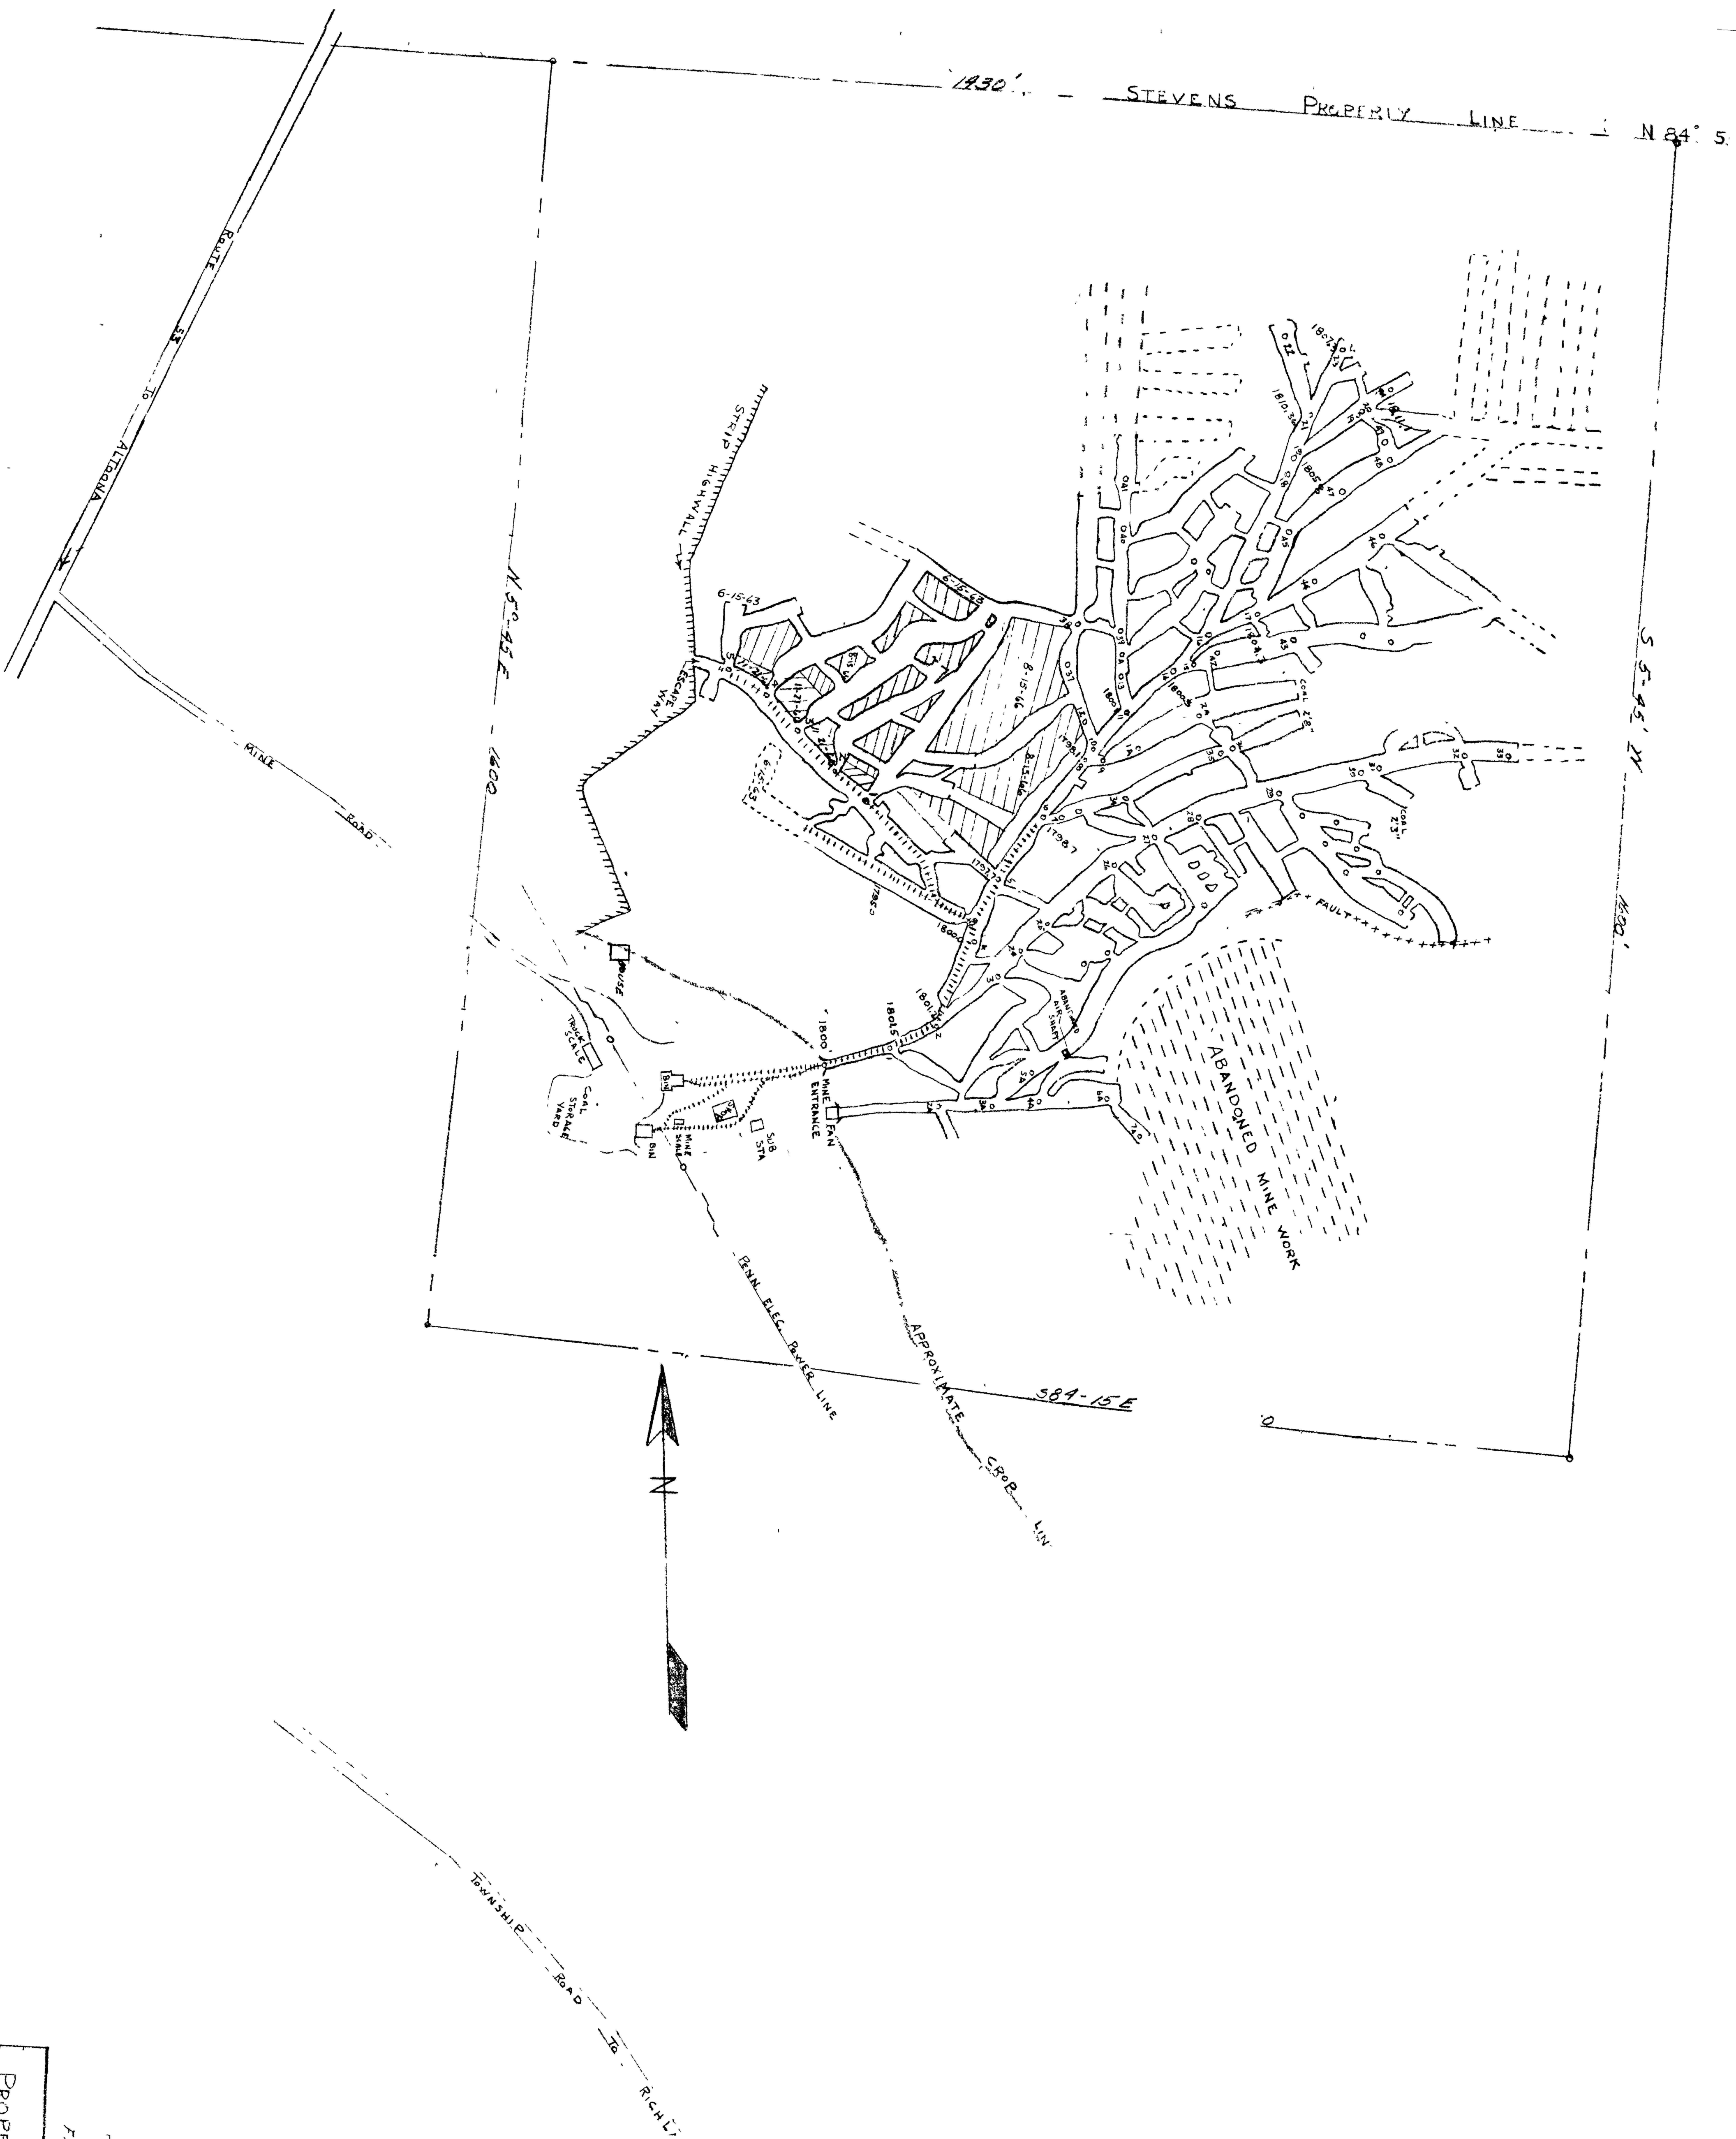

NOTE - MINE ENTRANCE ELEVATION NOT EXACT
SEA LEVEL

J.C.P.

Scale

NOT SEEN

FINAL MAP

PROPERTY OF	PROPERTY / MINE MAP
LINK COAL COMPANY	
DYSART RD. PENNA.	
DEAN TOWNSHIP - CAMBRIA CO.	
MINE ABANDONED - 11-21-66	
SCALE - 1" = 100'	DATE 11-21-66
COAL SEAM - 'B'	DRAWN BY - J.C.P.
REFERENCES - FORMER STAR	
COAL COMPANY MINE SURVEY	