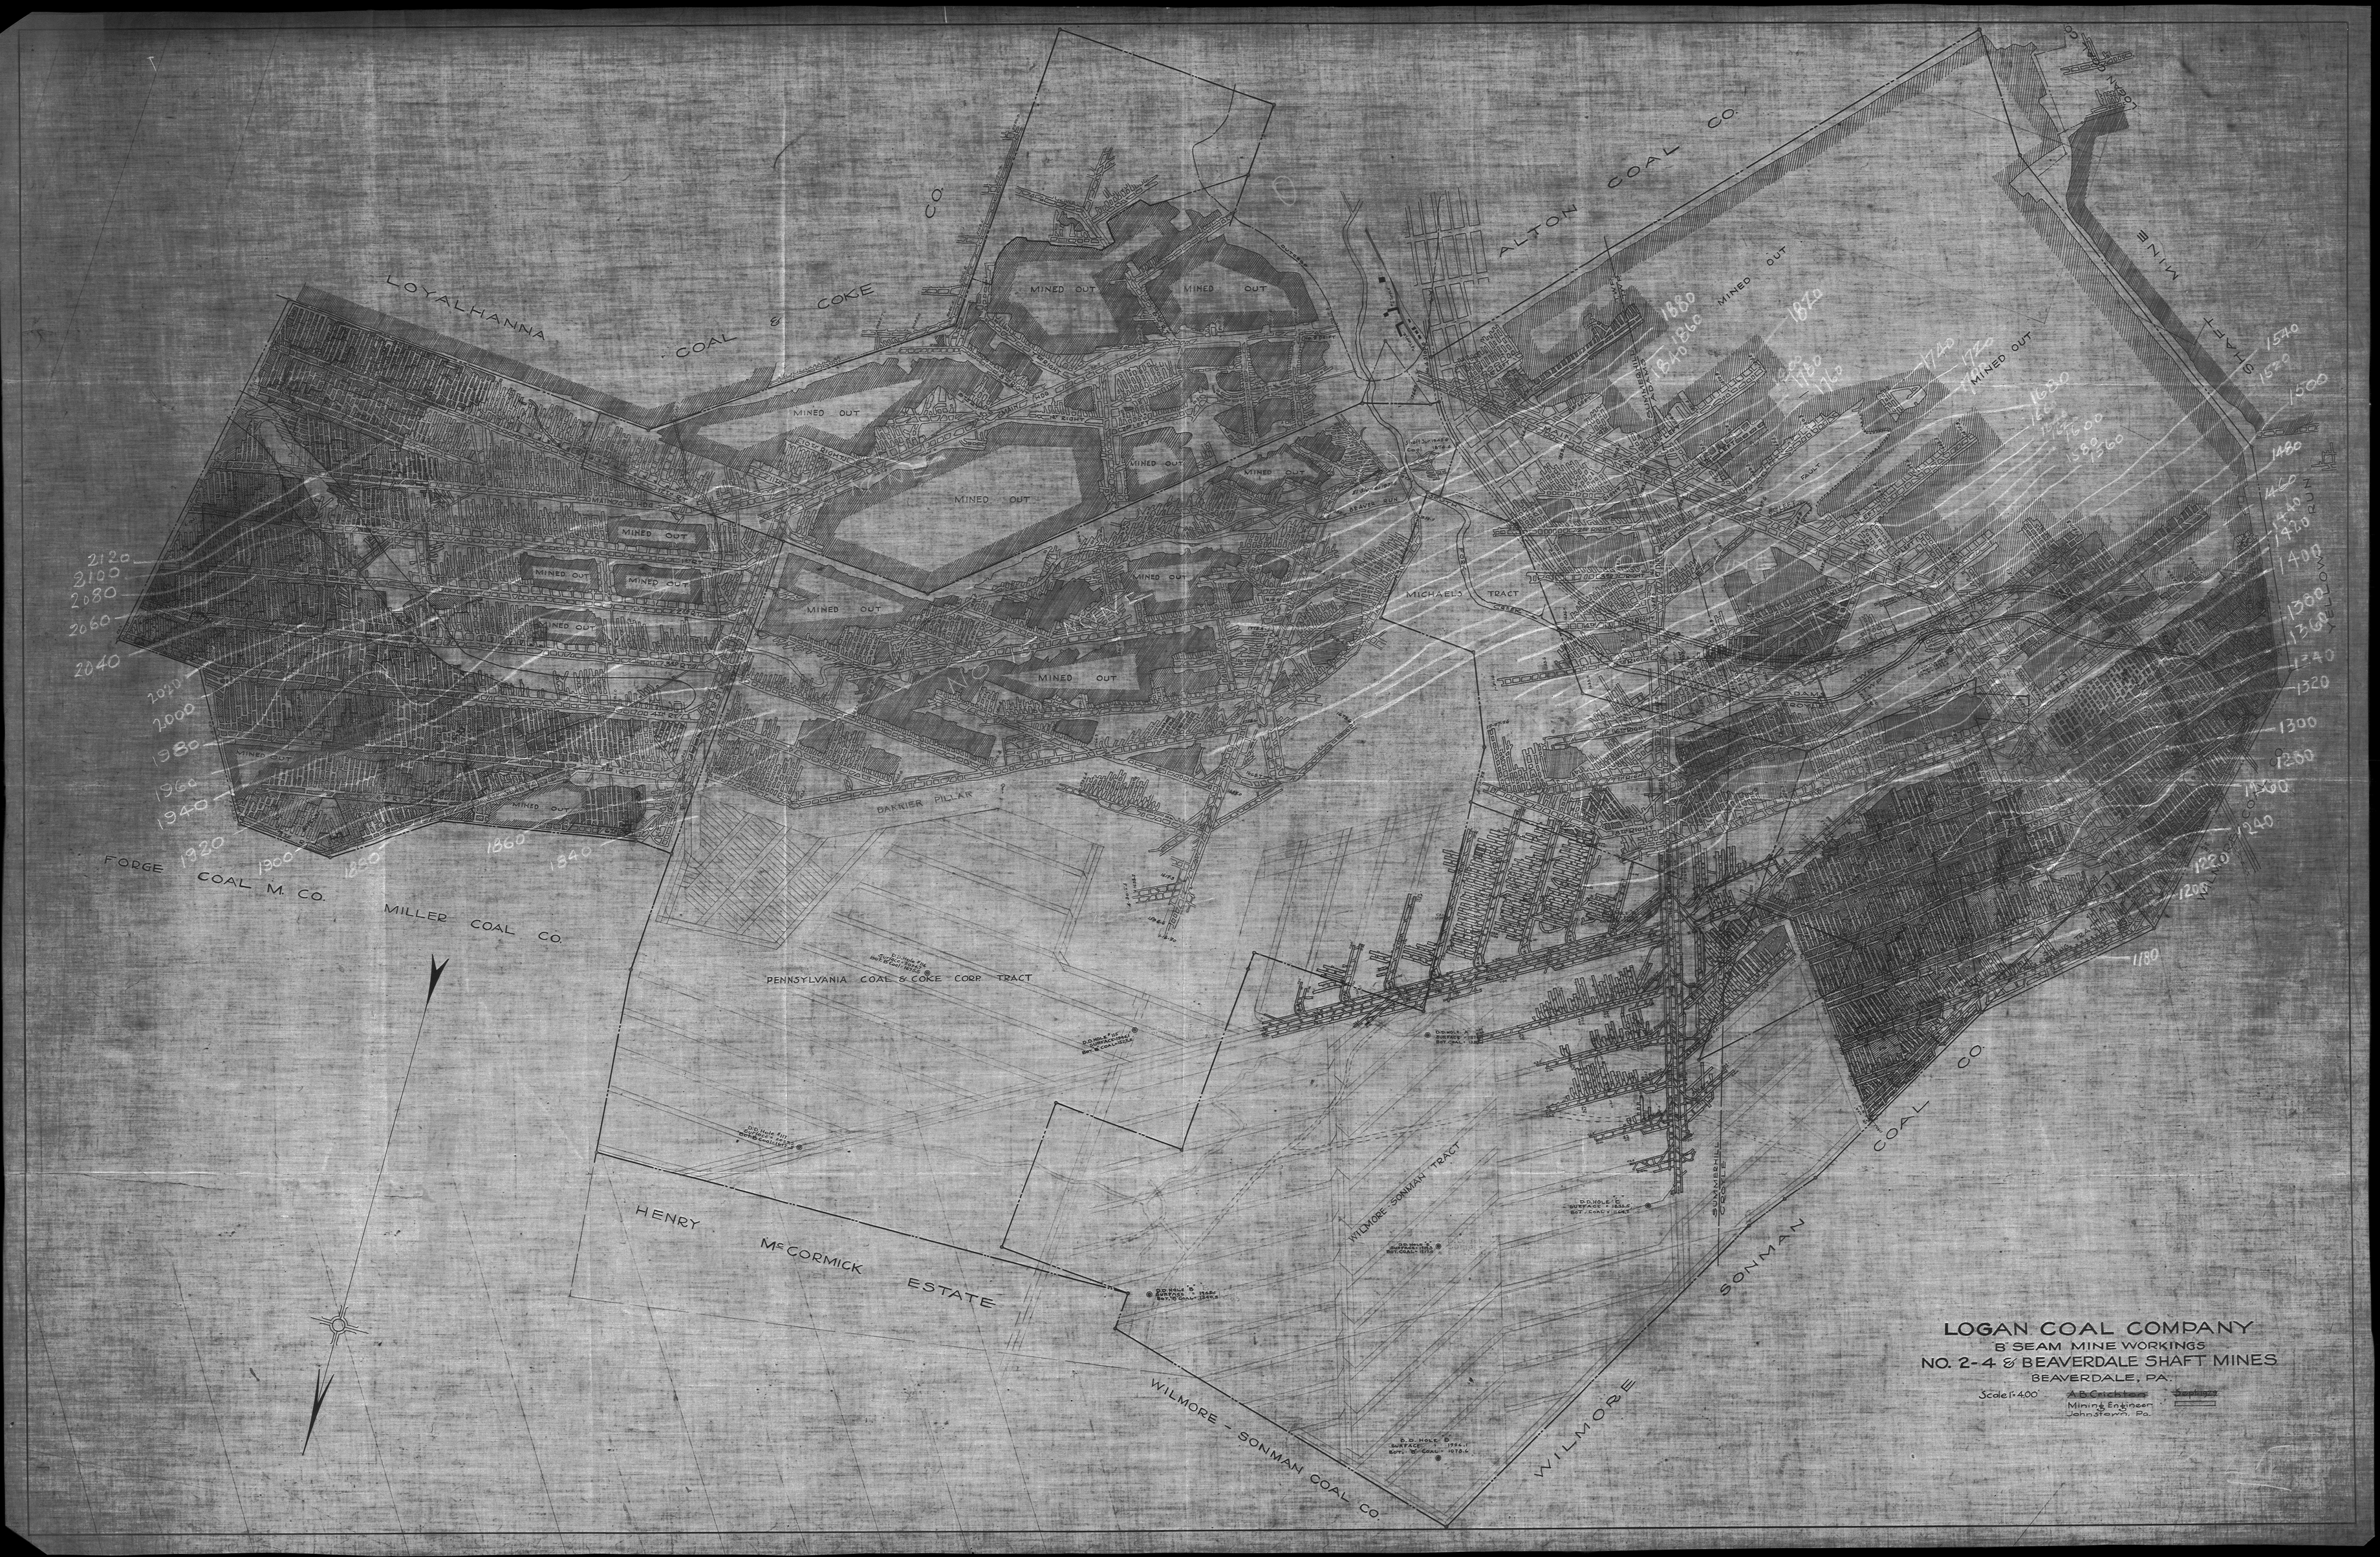
LOGAN COAL COMPANY
B SEAM MINE WORKINGS
NO. 2-4 & BEAVERDALE SHAFT MINES
BEAVERDALE, PA.
Scale 1"=400'
A.B. Crichton
Mining Engineer
Johnstown, Pa.
LOYALHANNA COAL & COKE CO.
ALTON COAL CO.
SHAFT MINE
FORGE COAL M. CO.
MILLER COAL CO.
HENRY McCORMICK ESTATE
WILMORE - SONMAN COAL CO.
WILMORE SONMAN COAL CO.
PENNSYLVANIA COAL & COKE CORP. TRACT
WILMORE-SONMAN TRACT
MICHAELS TRACT
BARRIER PILLAR
MINED OUT
2120
2100
2080
2060
2040
2020
2000
1980
1960
1940
1920
1900
1880
1860
1840
1820
1800
1780
1760
1740
1720
1680
1660
