


LOGAN COAL CO.
N. 64 SLOP.
BEVERDALE, PA.

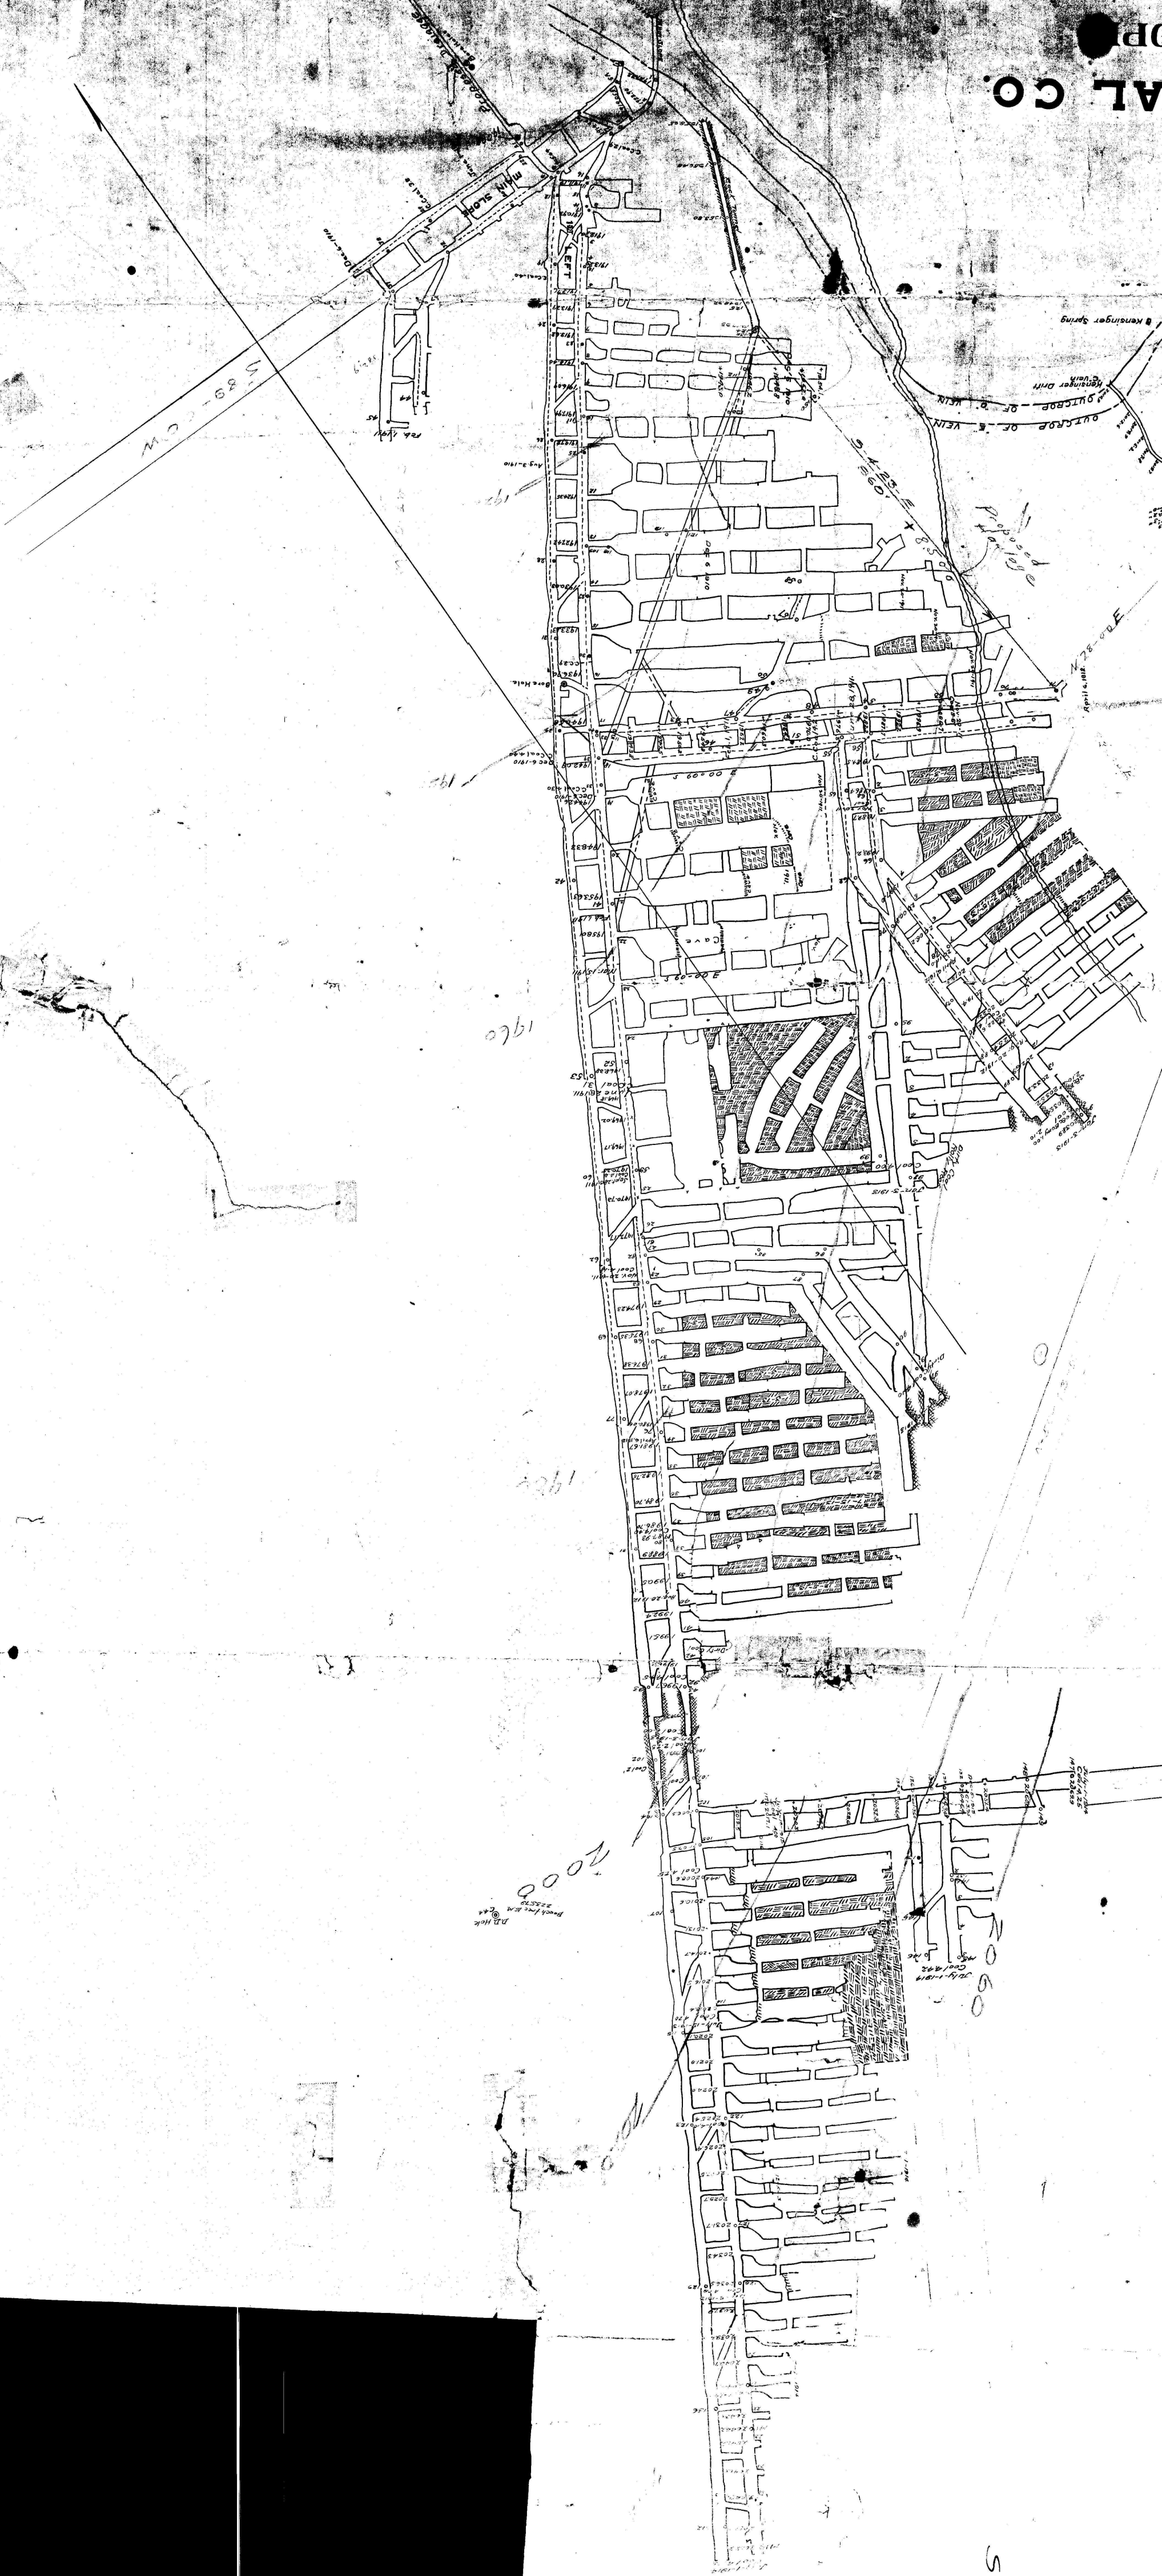

1960

1961

2000

S 60-00W

S 60-00E