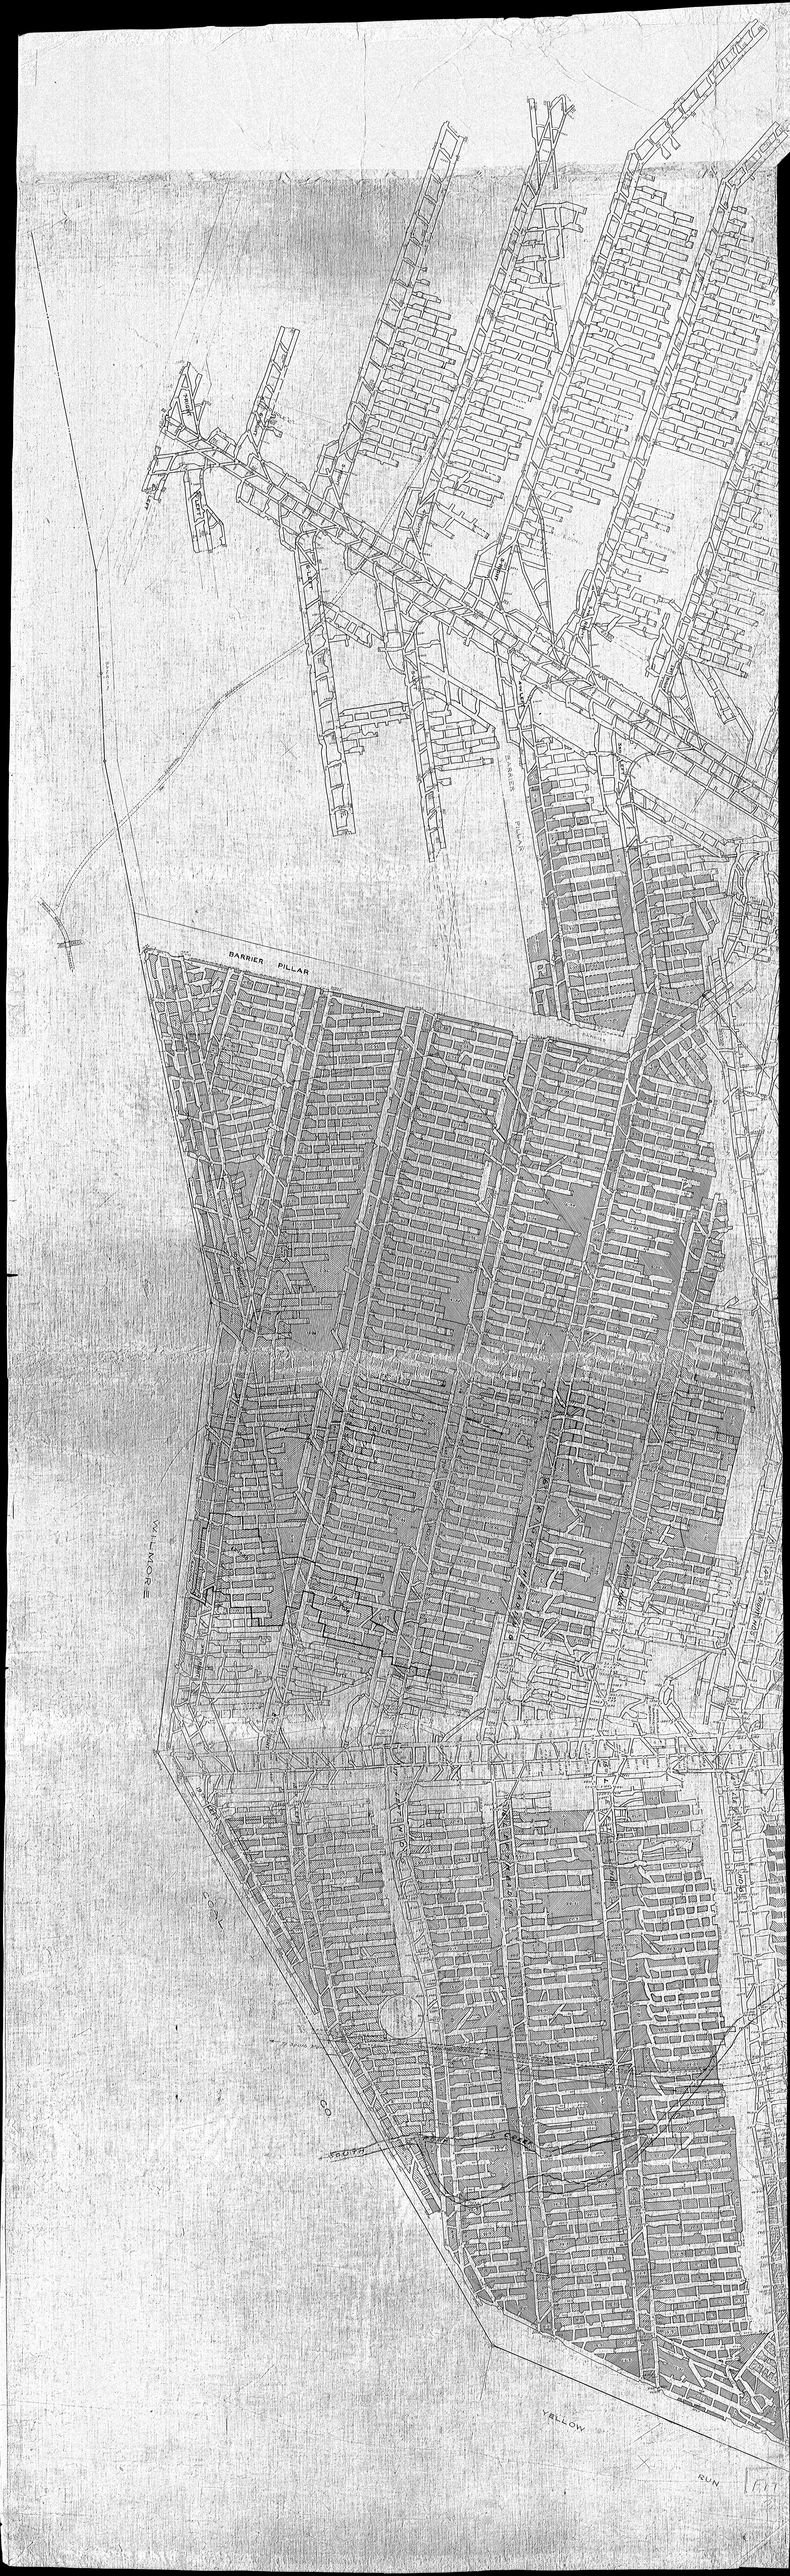
BARRIER PILLAR
BARRIER PILLAR
WILMORE
COAL
CO
SOUTH
YELLOW
RUN