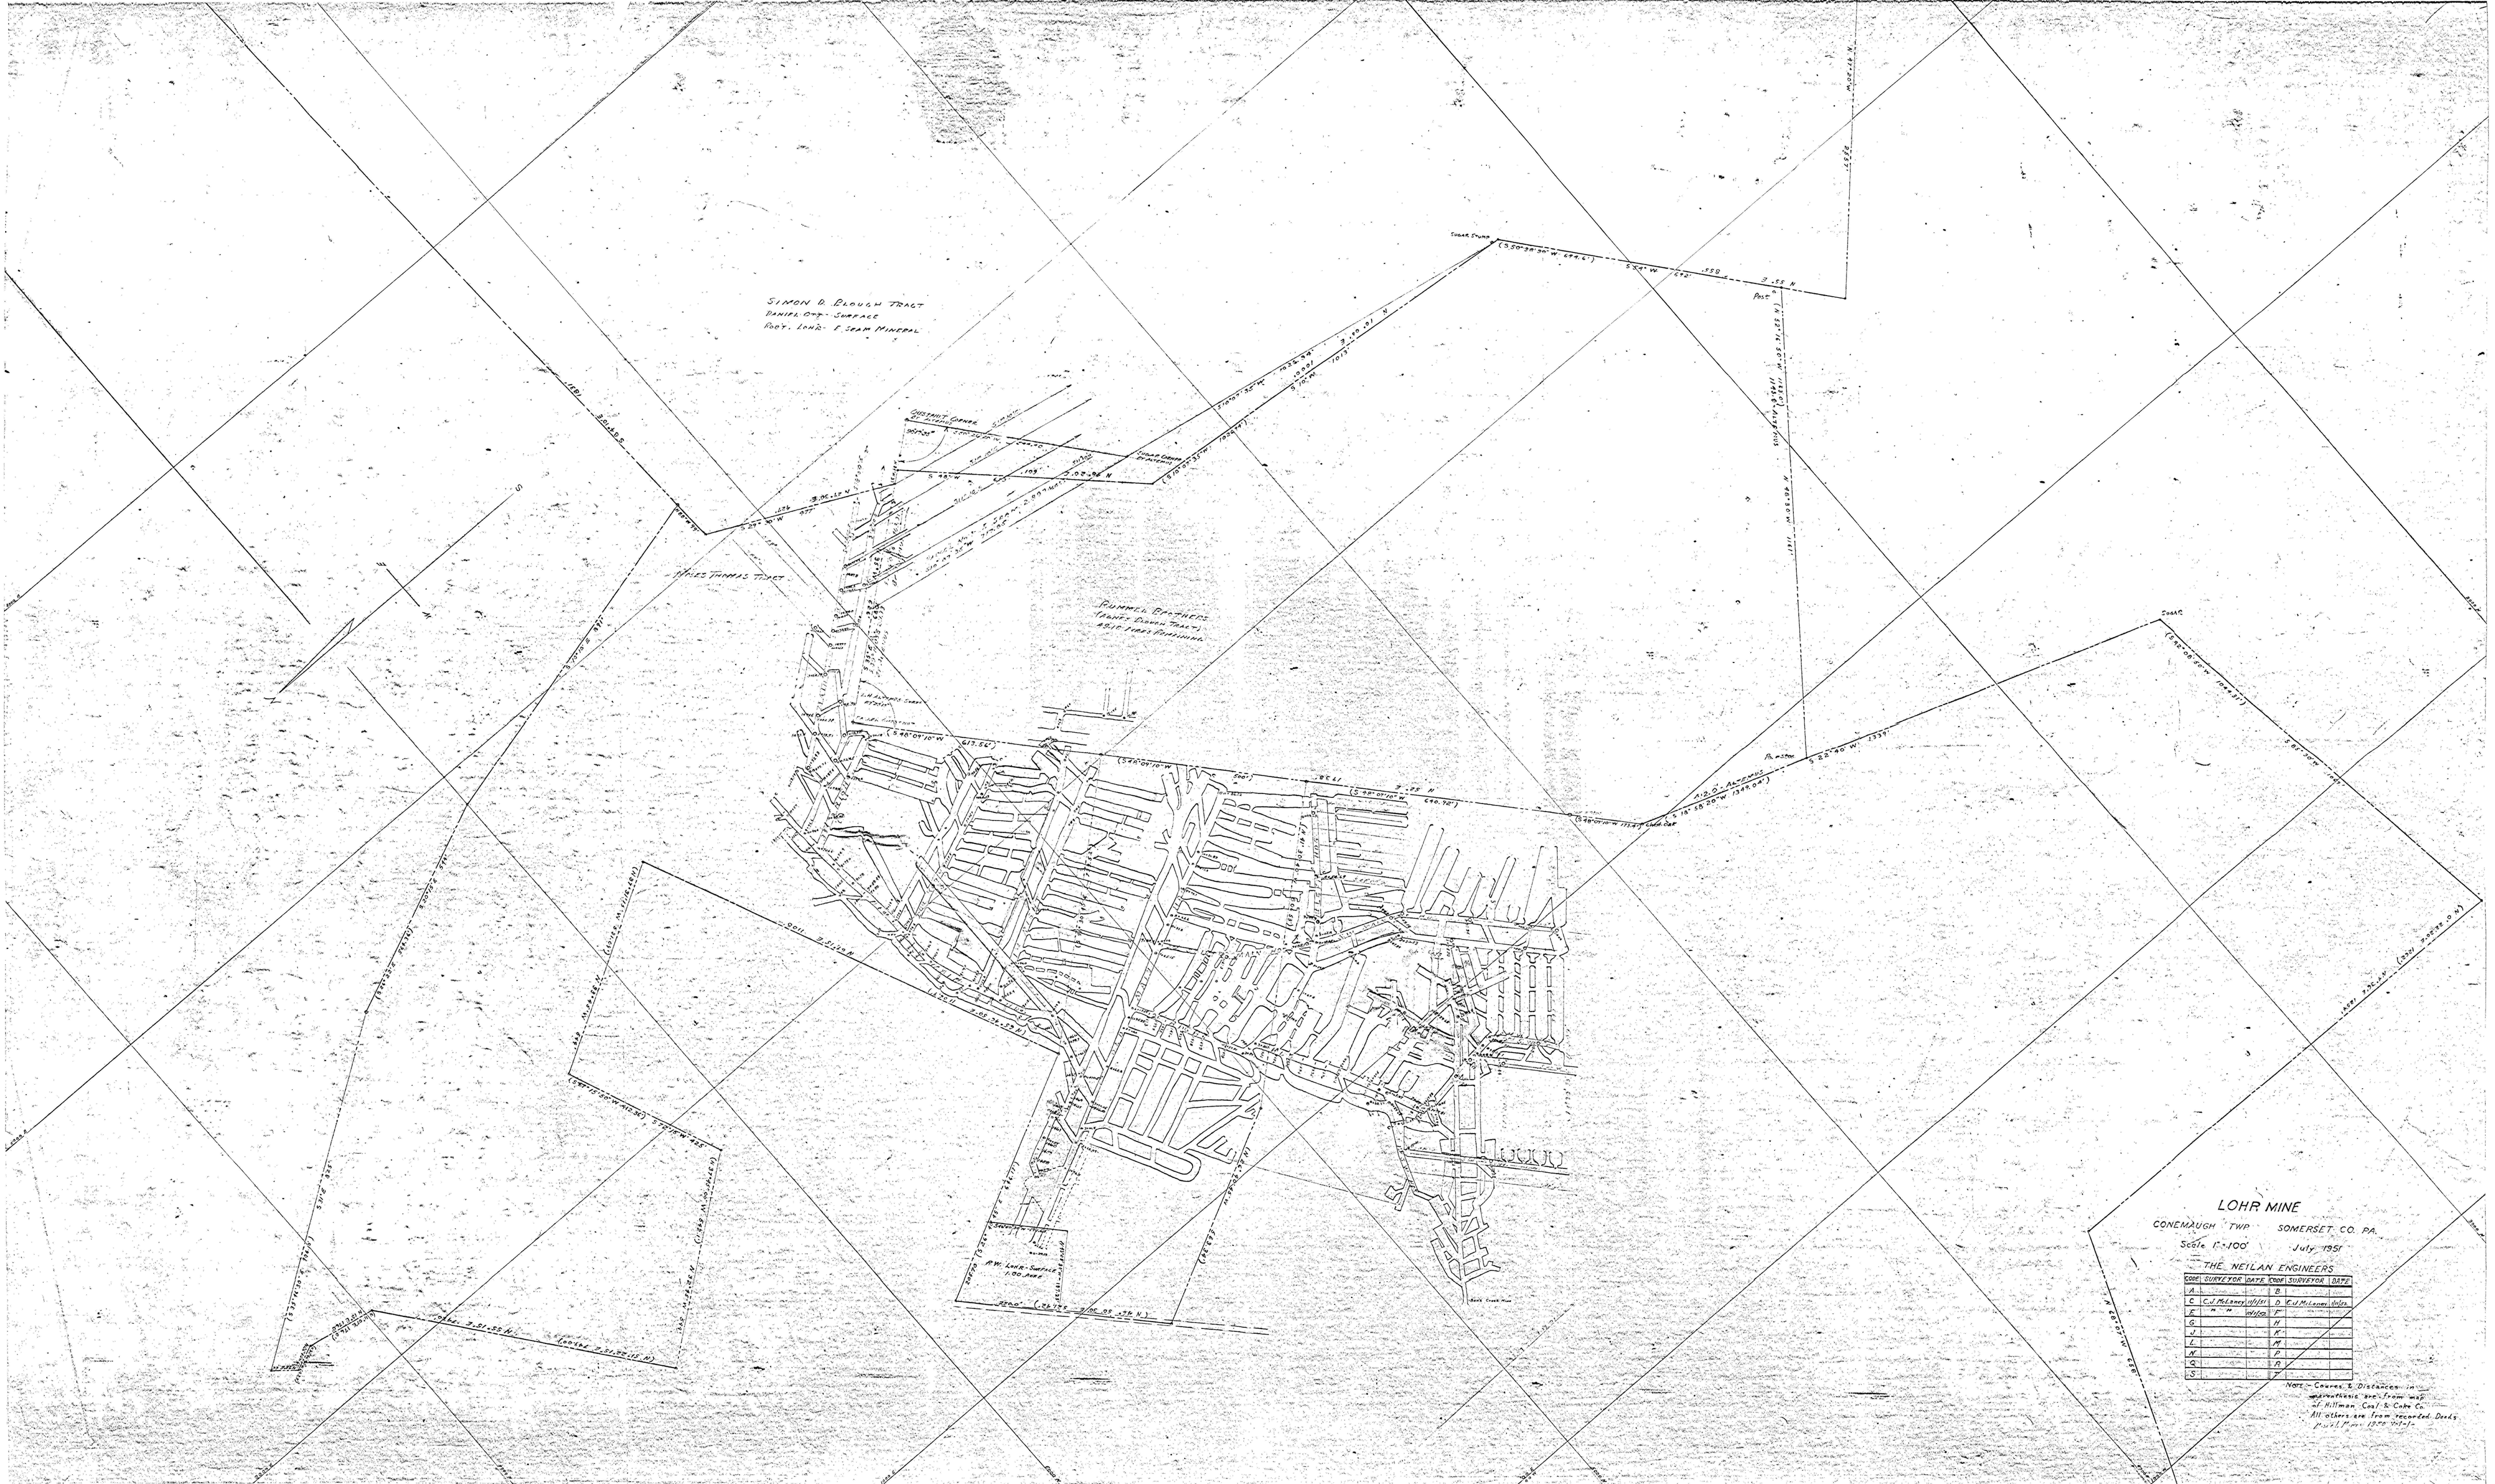
SIMON D. BROUGH TRACT
DANIEL ORT - SURFACE
ROBT. LOHR - COAL & SEAM MINERAL
WILES THOMAS TRACT
RUMMEL BROTHERS
(FRANK DAVIS TRACT)
ABST. FIRST RUNNING
P.W. LOHR - SURFACE
1.00 ACRE
LOHR MINE
CONEMAUGH TWP SOMERSET CO. PA.
Scale 1"=100' July 1951
THE NEILAN ENGINEERS
COORD. SURVEYOR DATE COORD. SURVEYOR DATE
A B
C C.J. McLaney 6/5/51 D C.J. McLaney 6/5/51
E " " 6/5/51 F
G H
J K
L M
N P
Q R
S T
Note - Courses & Distances in parenthesis are from map of Hillman Coal & Coke Co.
All others are from recorded Deeds
(Book 1, Page 1, 1909 Vol.)