


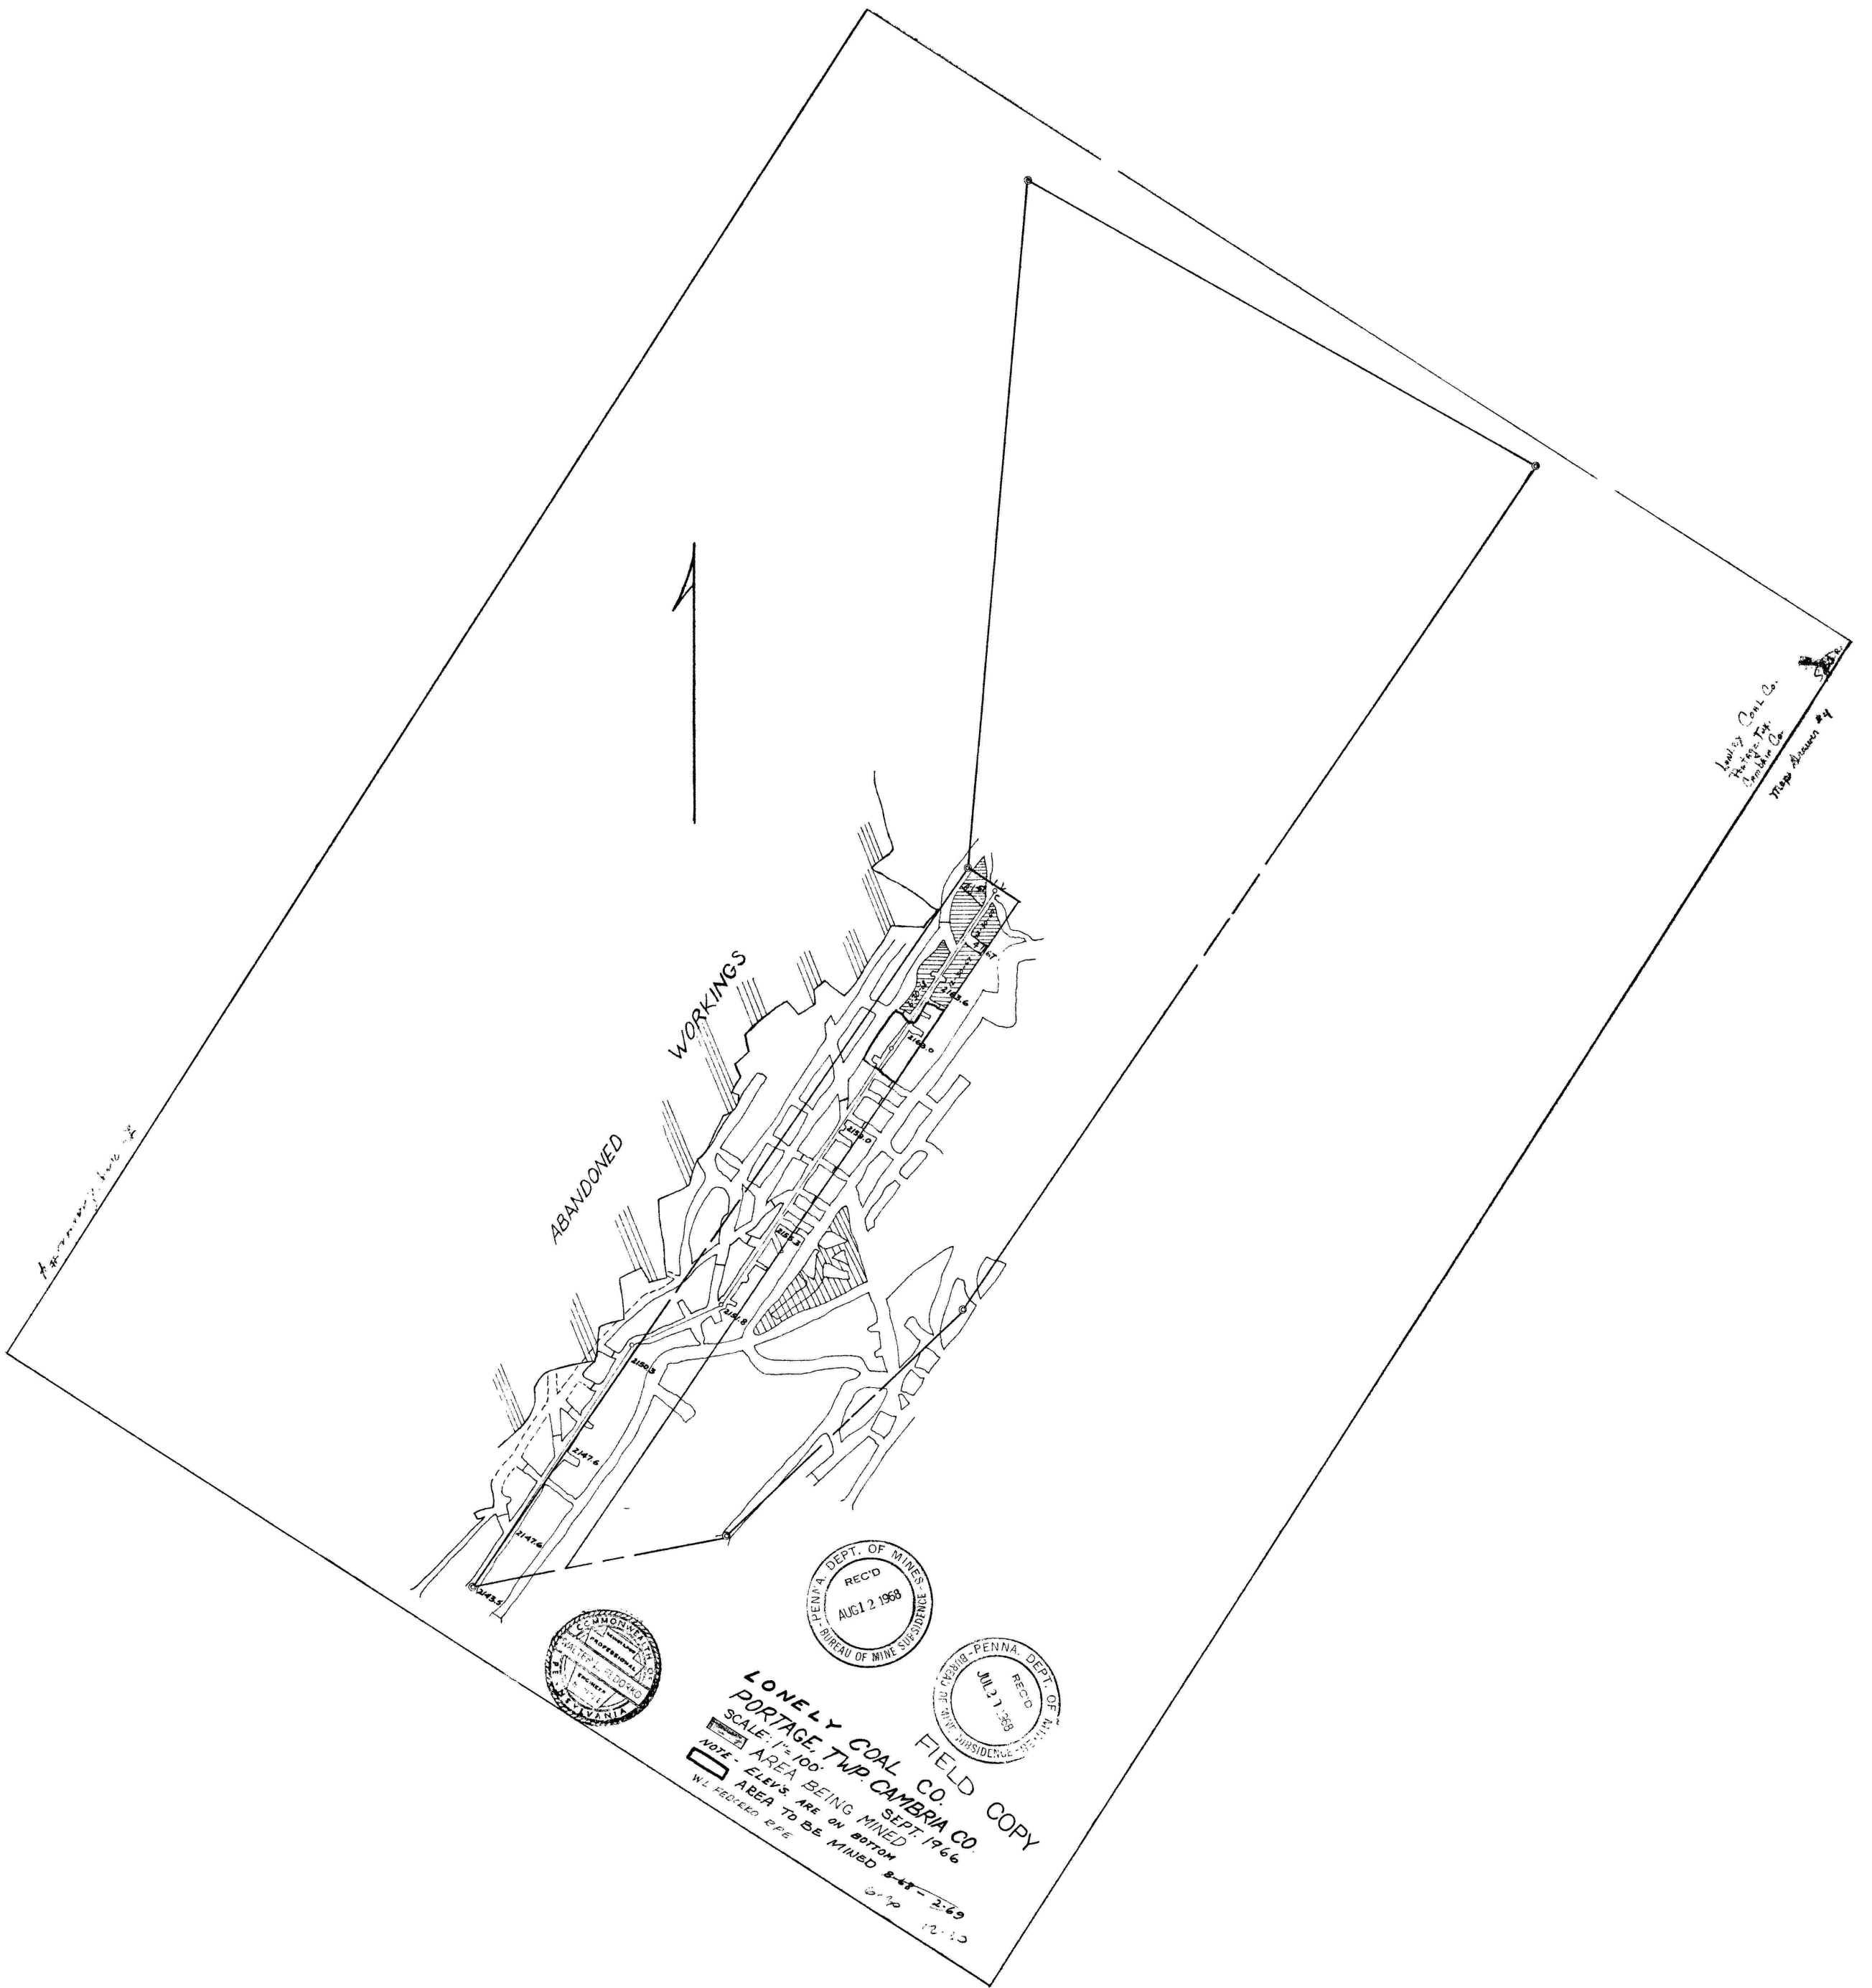

LONELY COAL CO.  
PORTAGE TWP.  
CAMBRIA CO.  
11-20-66

PENNA. DEPT. OF MINES  
REC'D  
AUG 12 1968  

PENNA. DEPT. OF MINES  
REC'D  
JUL 21 1968  

LONELY COAL CO.  
PORTAGE TWP. CAMBRIA CO.  
SCALE: 1"=100'  
FIELD COPY  
NOTE - AREA BEING MINED SEPT. 1966  
AREA TO BE MINED 9-66-2-69  
W.L. FORD 1966 R.F.E.

