


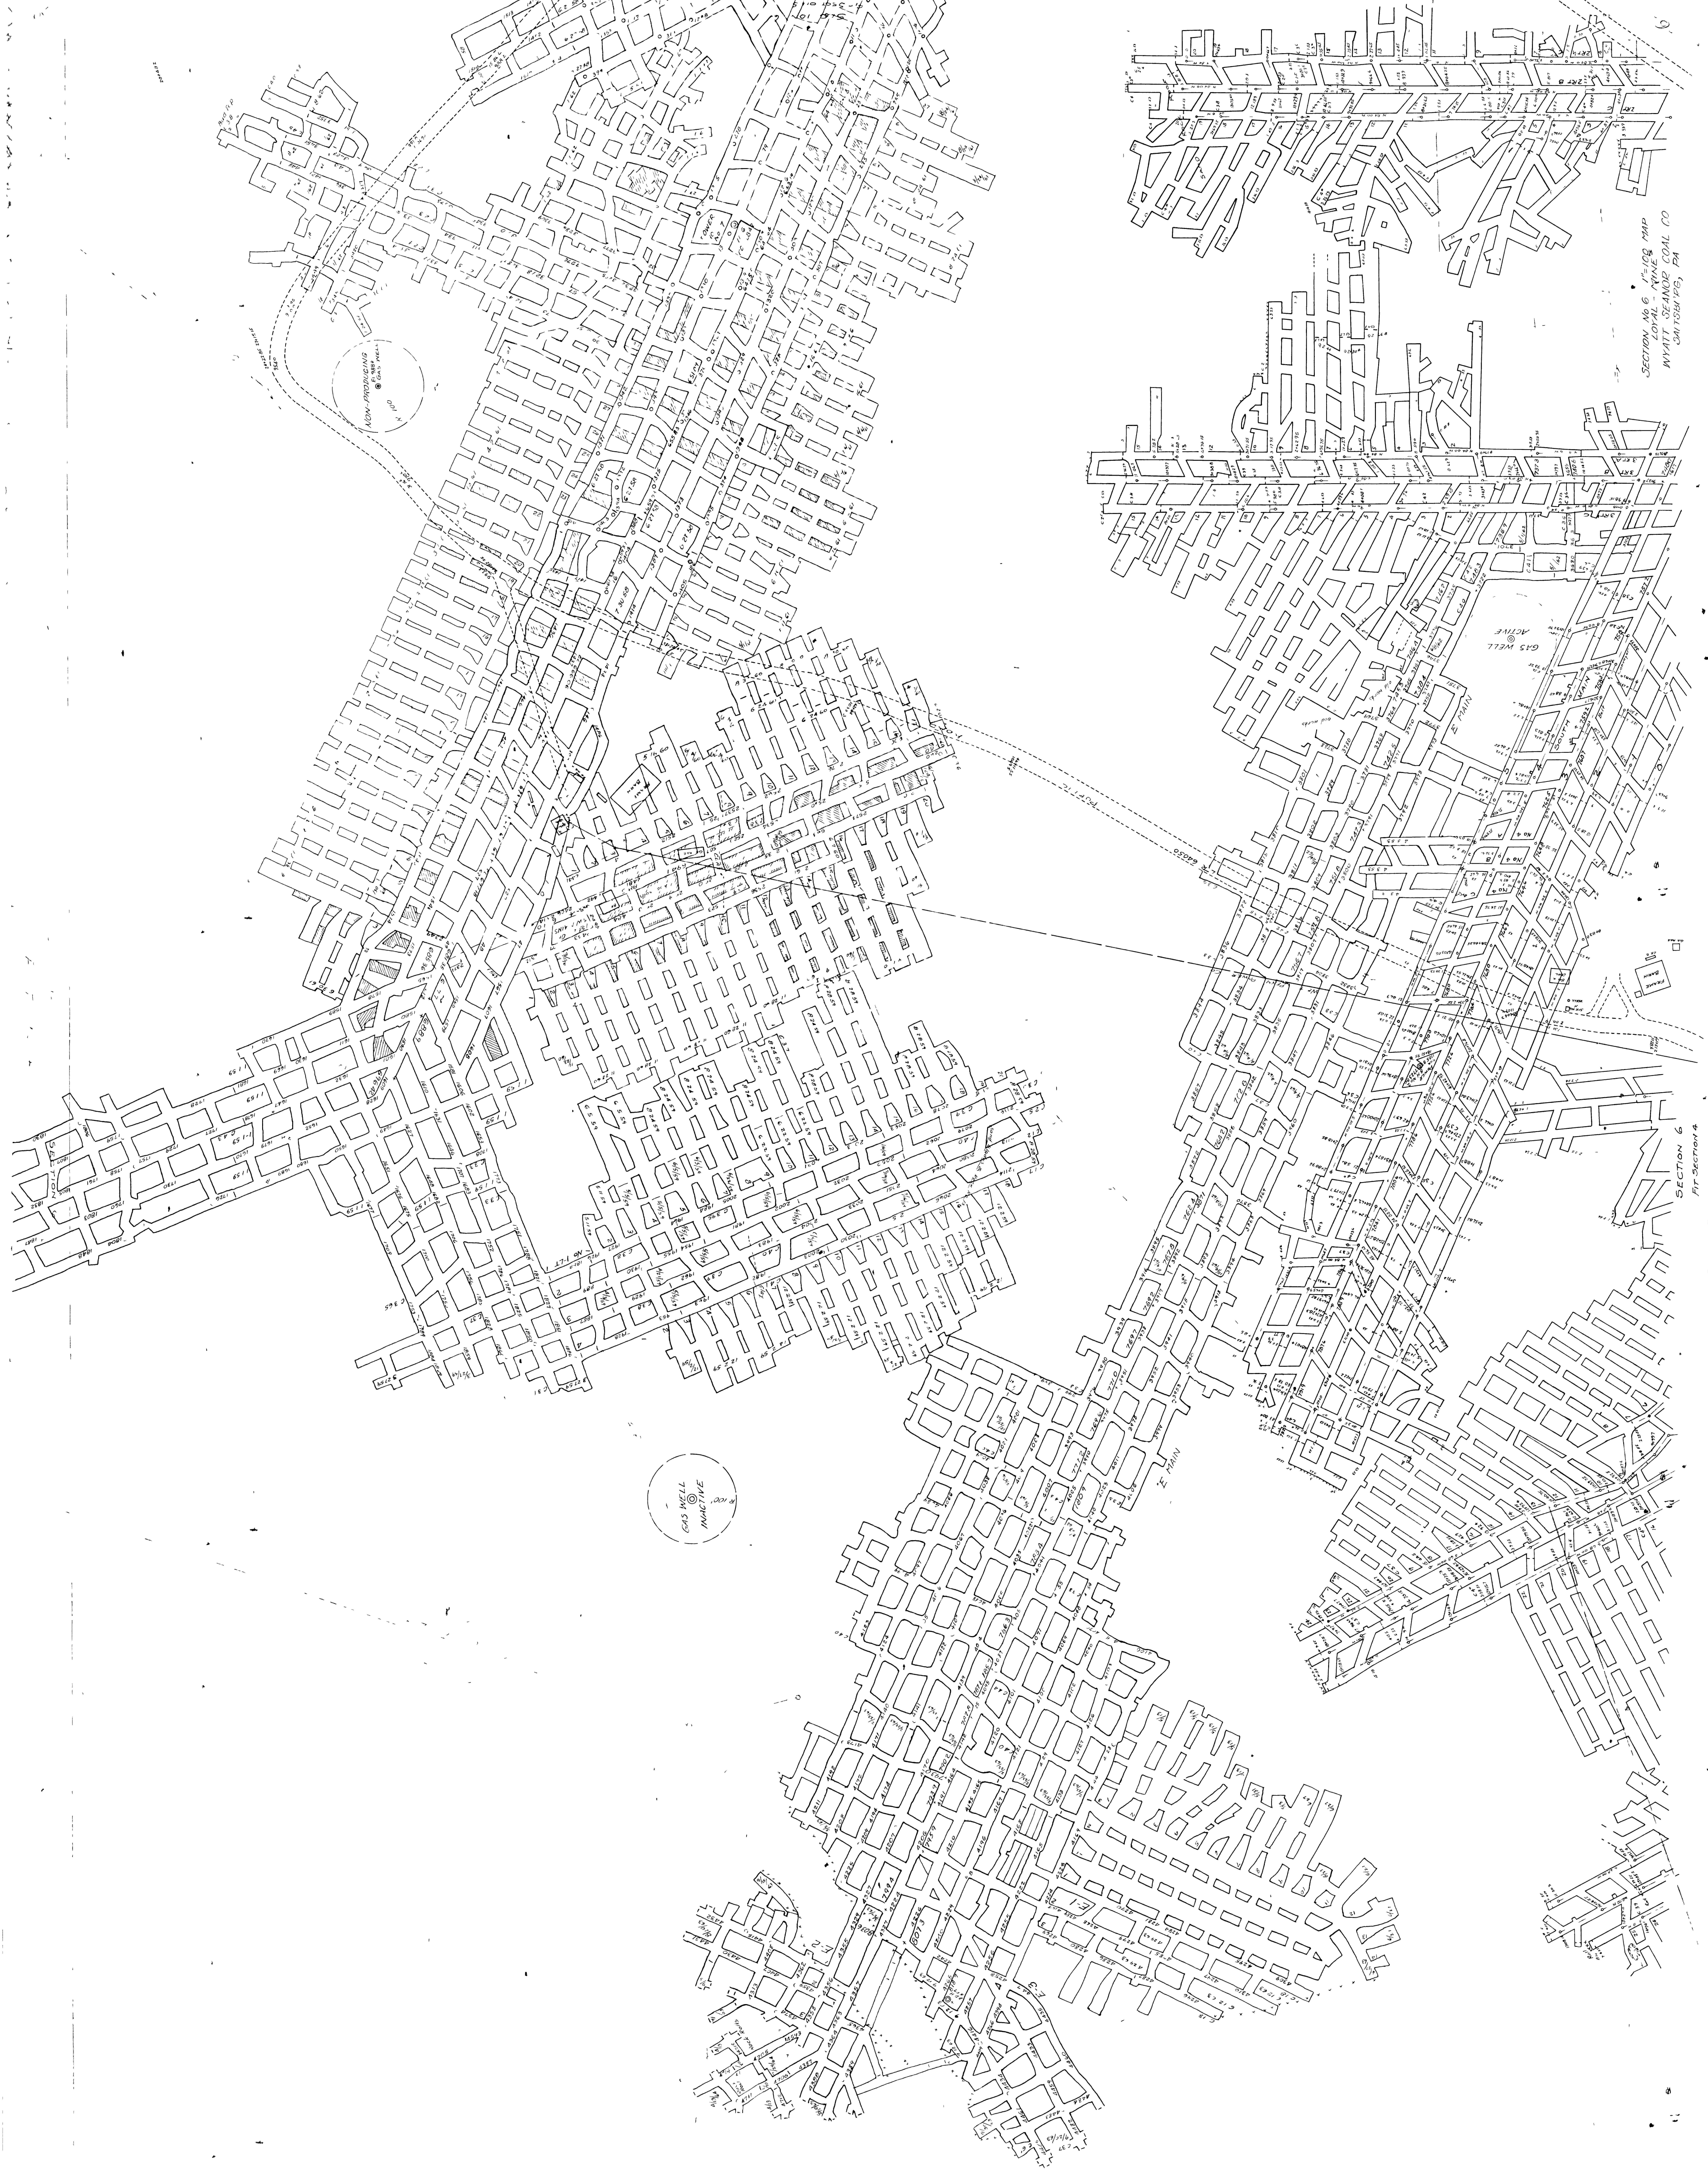

SECTION No 6 1"=100' MAP
LOYAL - PINE

SECTION 6
PT. SECTION 4