


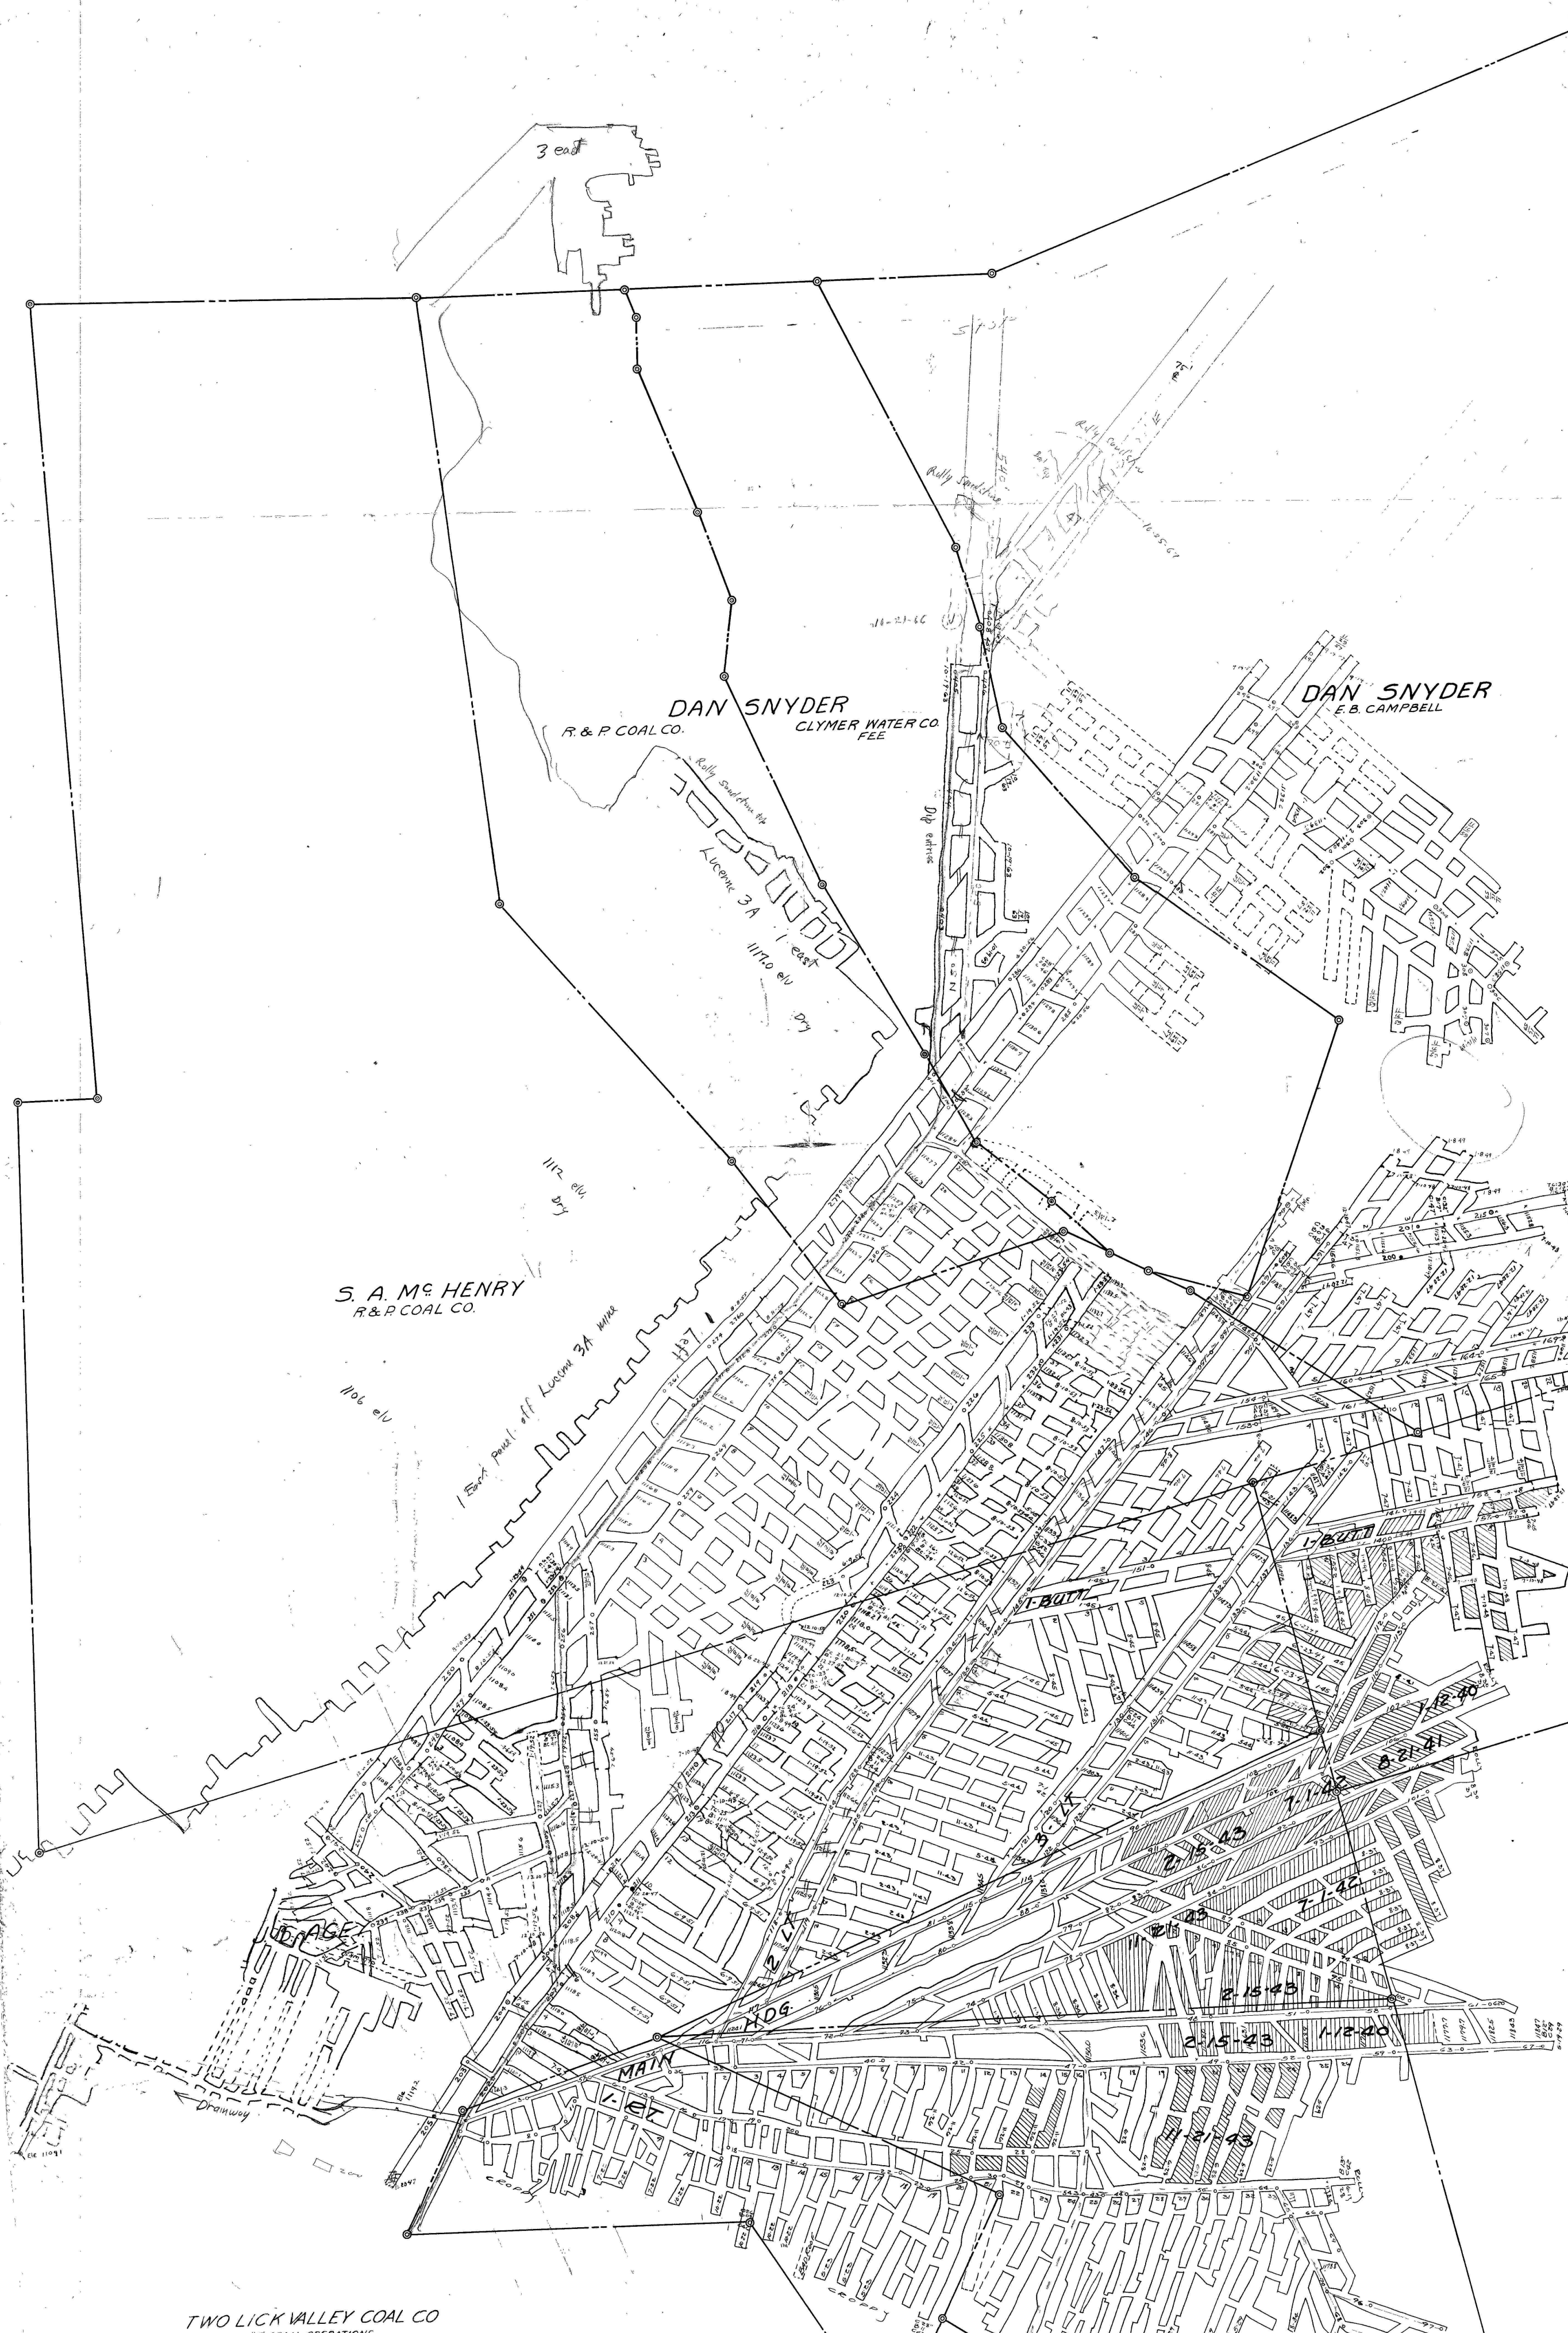

TWO LICK VALLEY COAL CO
E SEAM OPERATIONS
SITUATE IN
WHITE TWP. INDIANA, CO. PA.
WESTMORELAND SURVEYING AND MAPPING CO
SCALE 1"=100' WALTER E. BLOCH REG. SUR. BLAIRSVILLE, PENNA.

#163
6-2-99
C.C.