


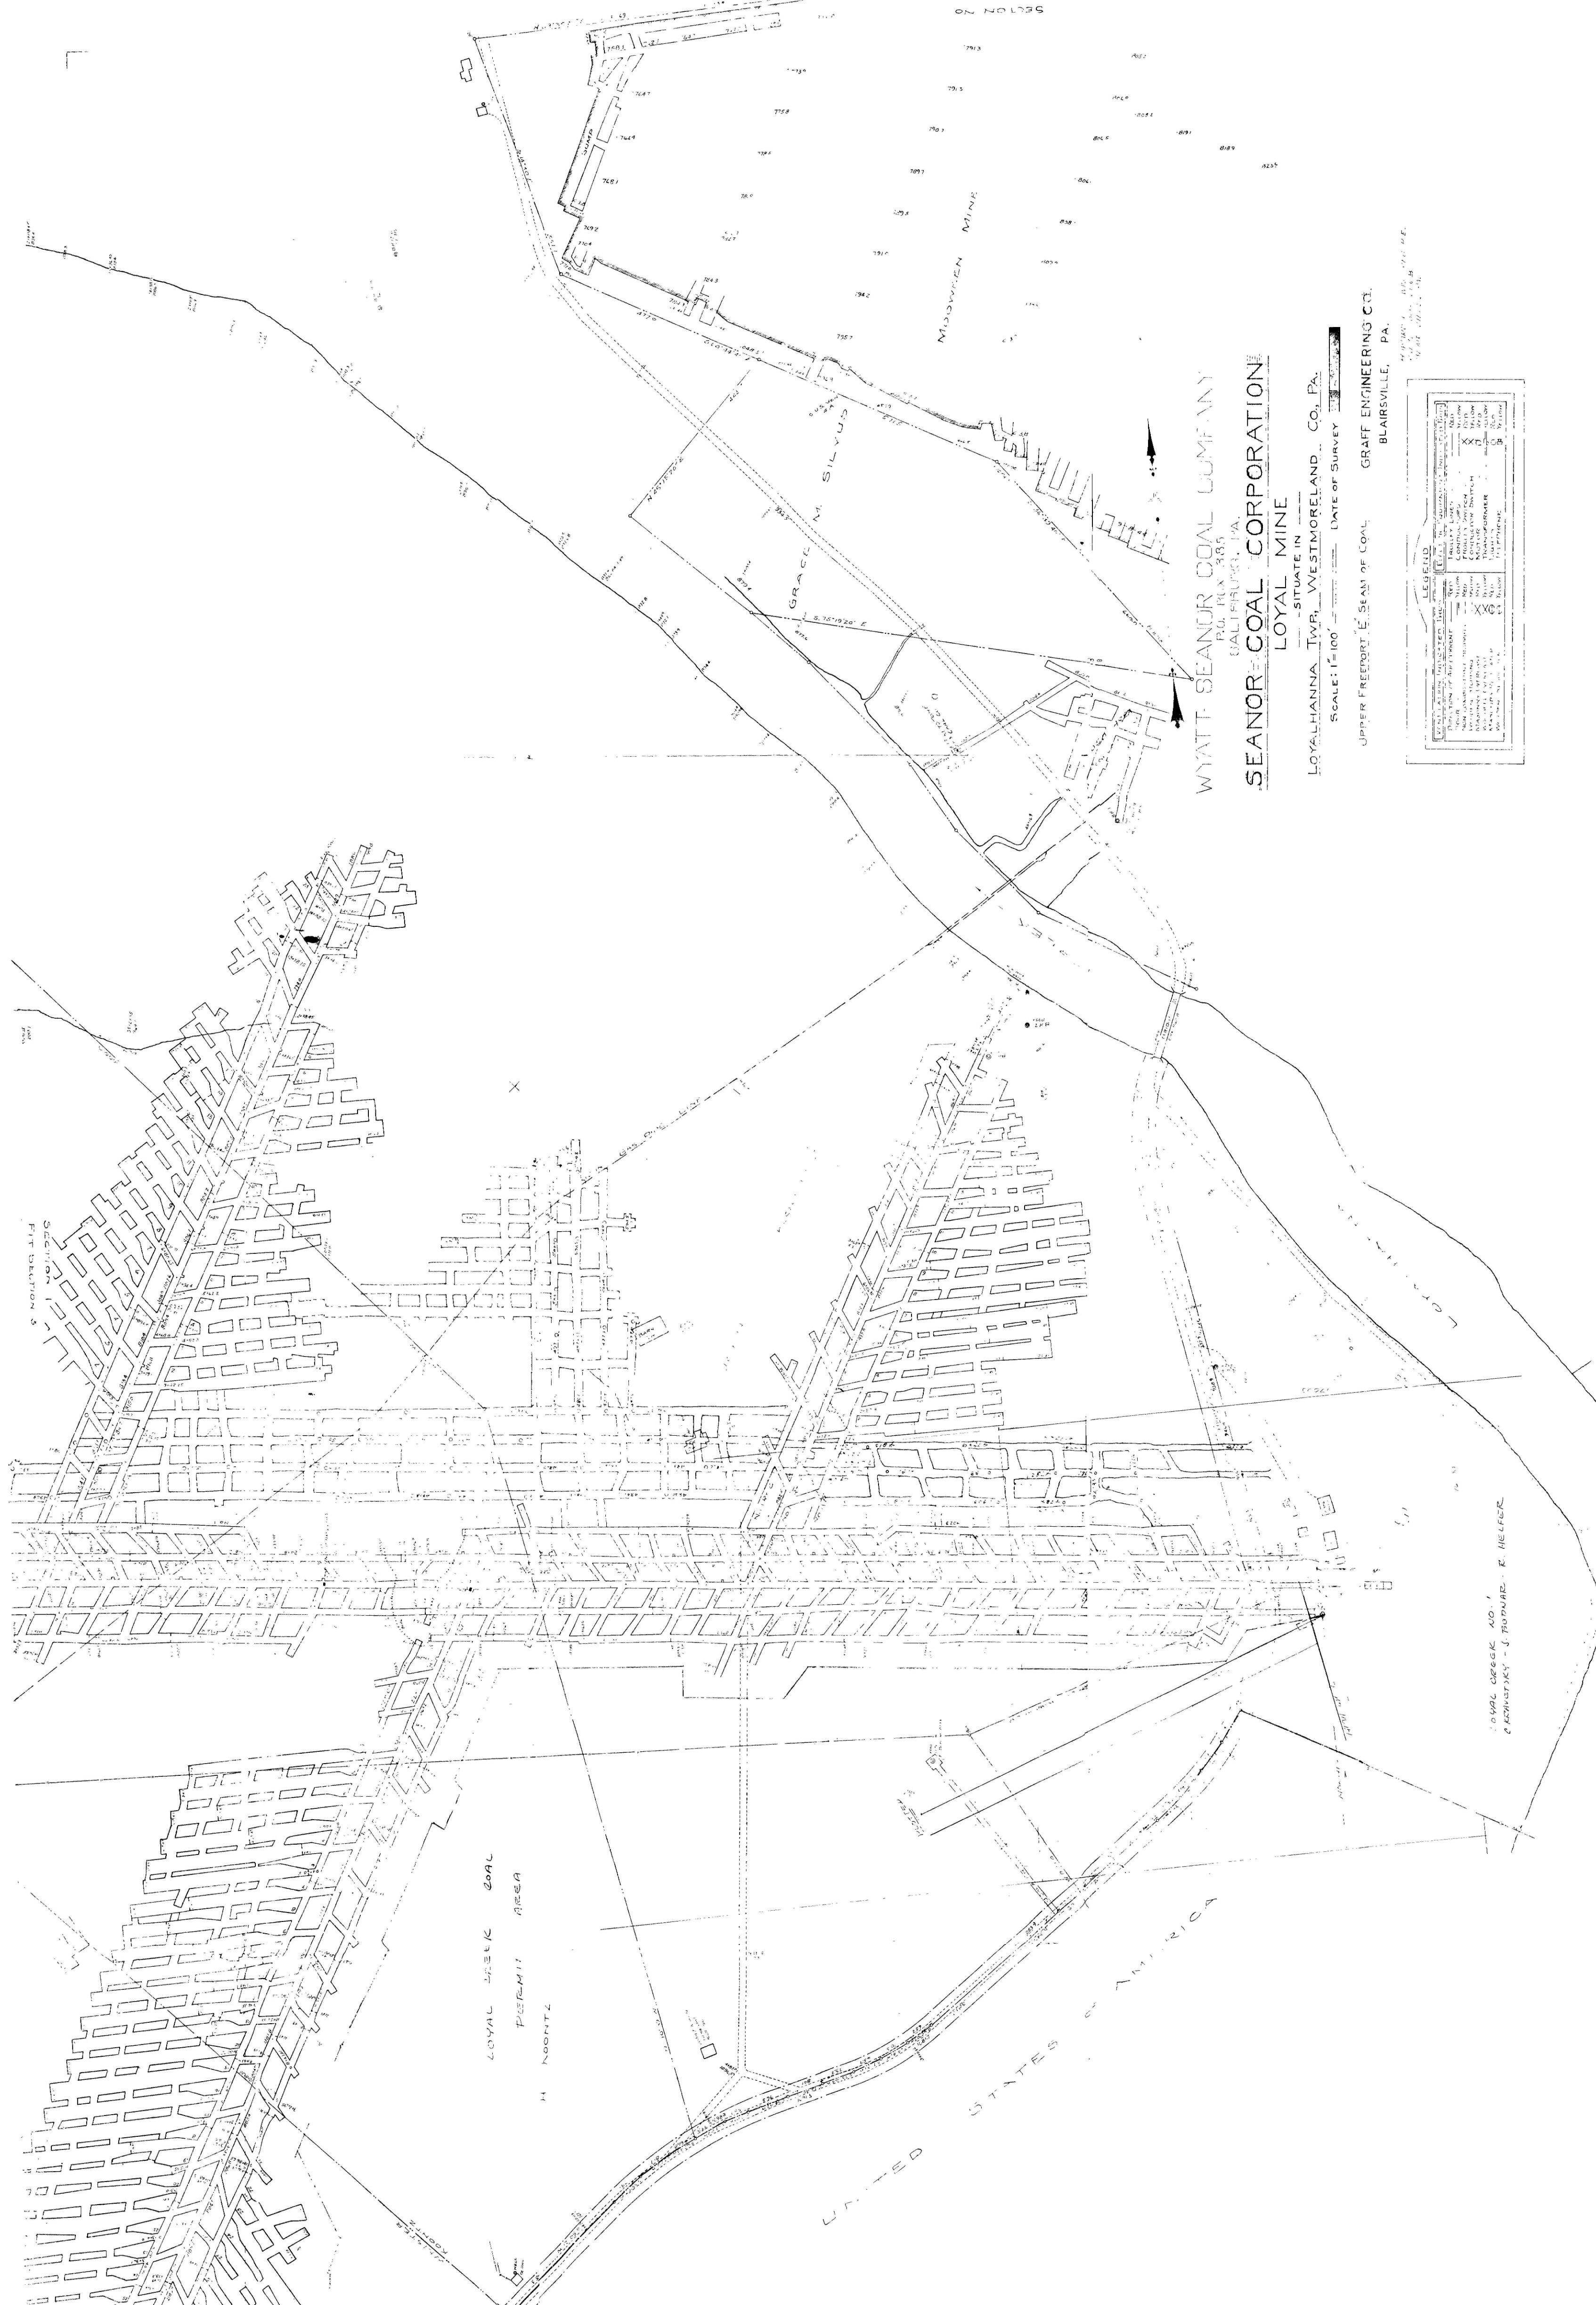

WYATT SEANOR COAL COMPANY
P.O. BOX 385

SEANOR COAL CORPORATION
LOYAL MINE

LOYALHIANA TWP., WESTMORELAND CO., PA.
SCALE: 1" = 100' DATE OF SURVEY

GRAFF ENGINEERING CO.
BLAIRSVILLE, PA.

LEGEND	

LOYAL CREEK NO. 1
KEMENSKY - J. TOWNE - R. HELFER