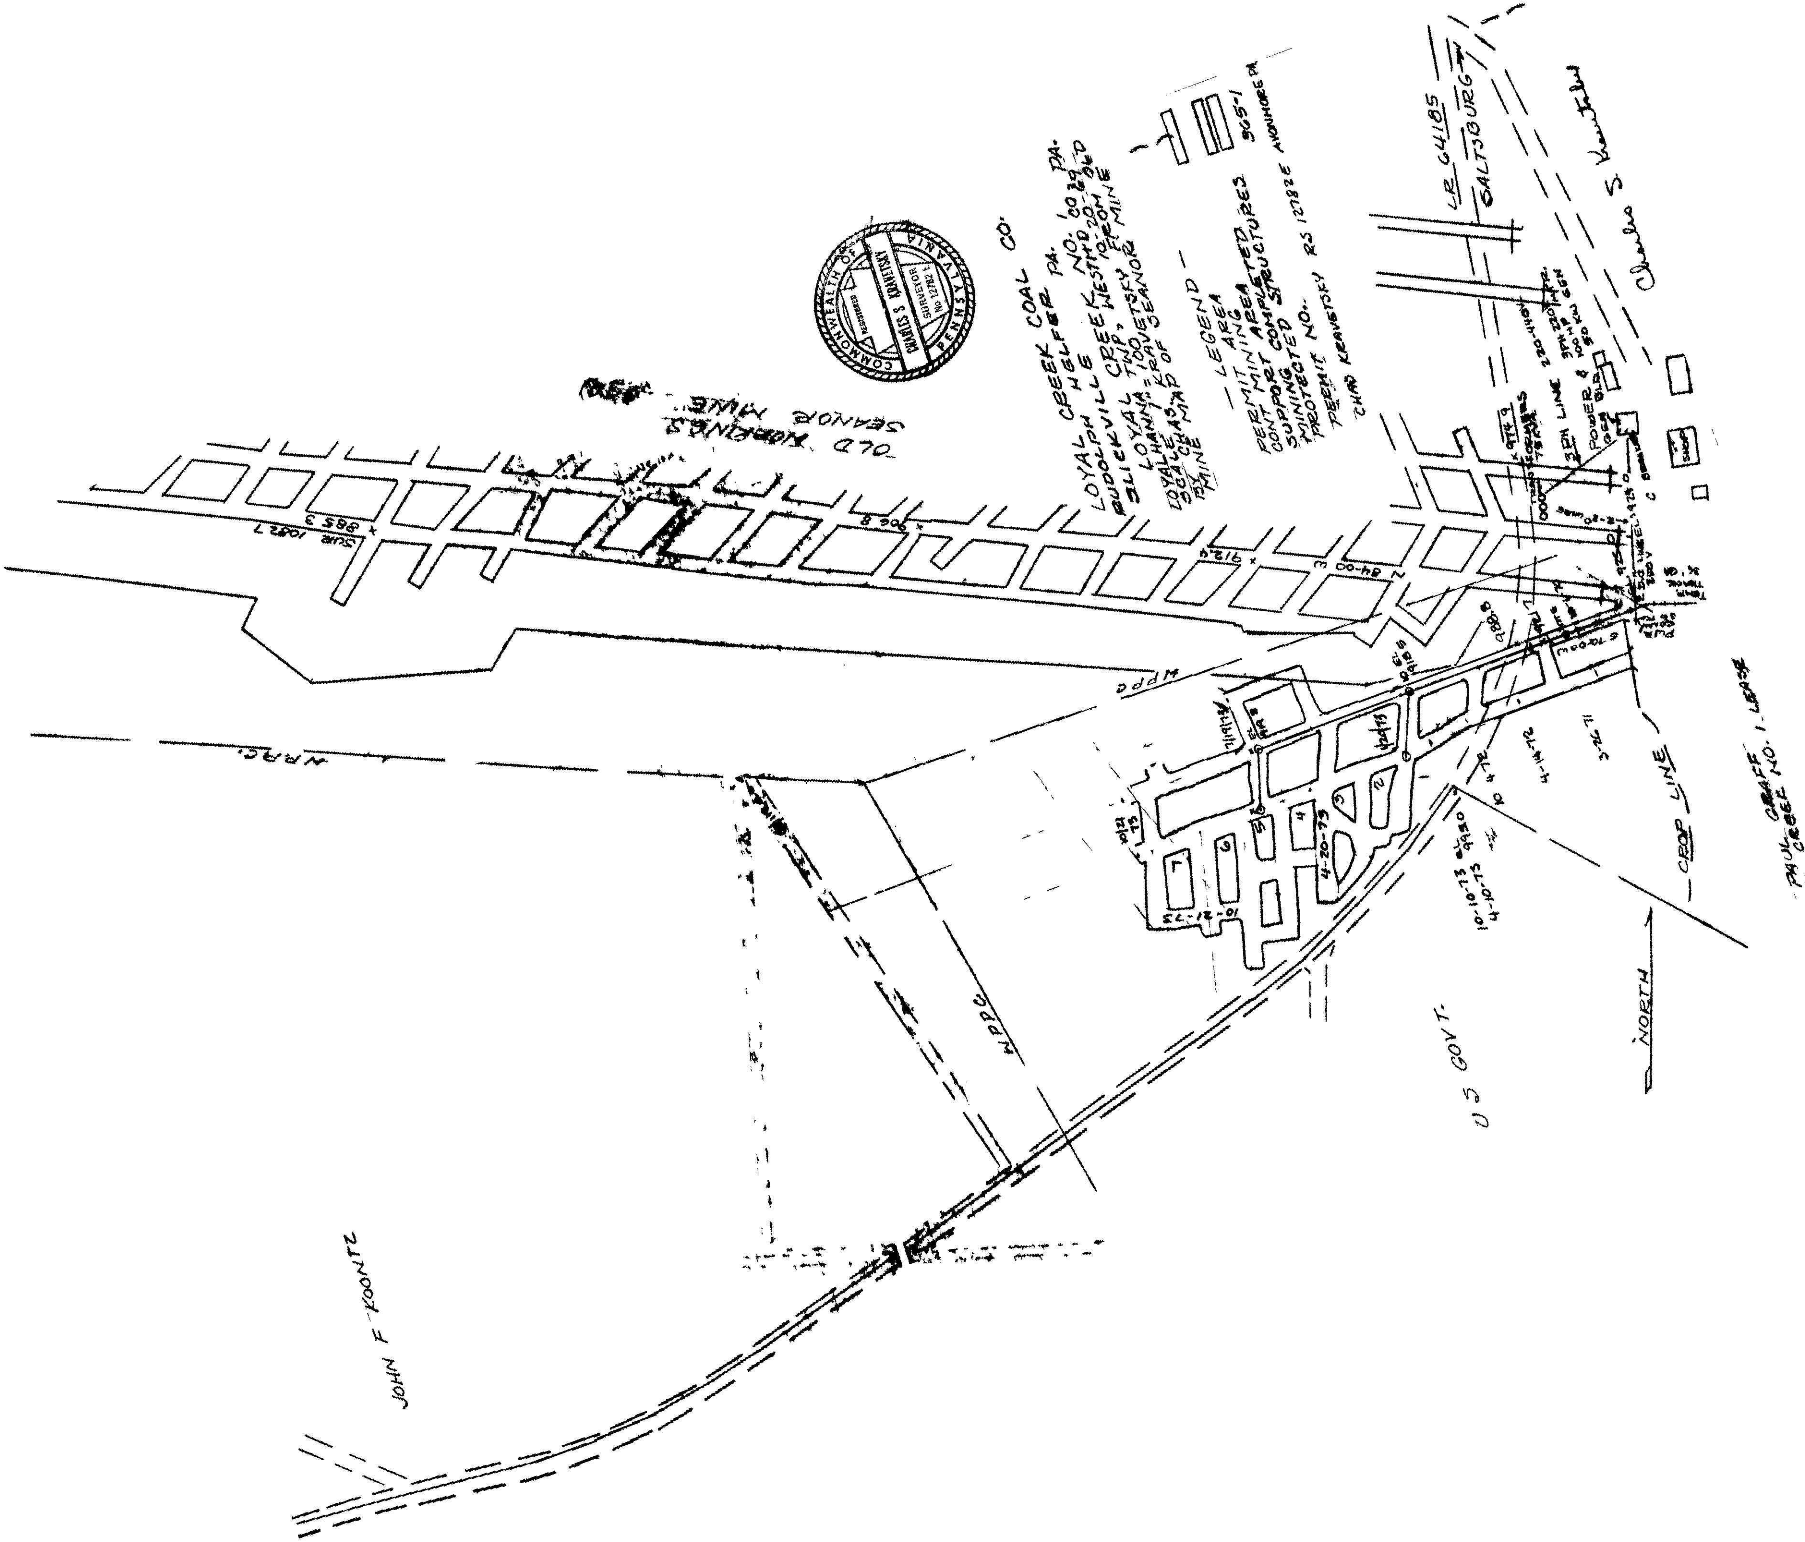
LOYAL CREEK COAL CO.
LEGEND
PERMIT AREA
MINING AREA COMPLETED
SUPPORT STRUCTURES
PROTECTED
PERMIT NO.
CHAS KRAVETSKY RS 12782 E AVONMORE PA
SCS-1
COMMONWEALTH OF PENNSYLVANIA
REGISTERED
CHARLES S KRAVETSKY
SURVEYOR
No 12782 E
Charles S Kravetsky
LR 64185
SALTSBURG
OLD WORKINGS
SEANOR MINE
SUR 1082.7
885.3
906.8
912.4
N 84-00 E
WPPC
NRRC.
POWER & GEN BLD.
3PH LINE
SHOP
3-26-71
4-14-72
10-4-72
4-20-73
10-10-73
4-10-73
CROP LINE
PAUL GRAFF
LOYAL CREEK NO. 1 LEASE
NORTH
U S GOVT.
JOHN F KOONTZ