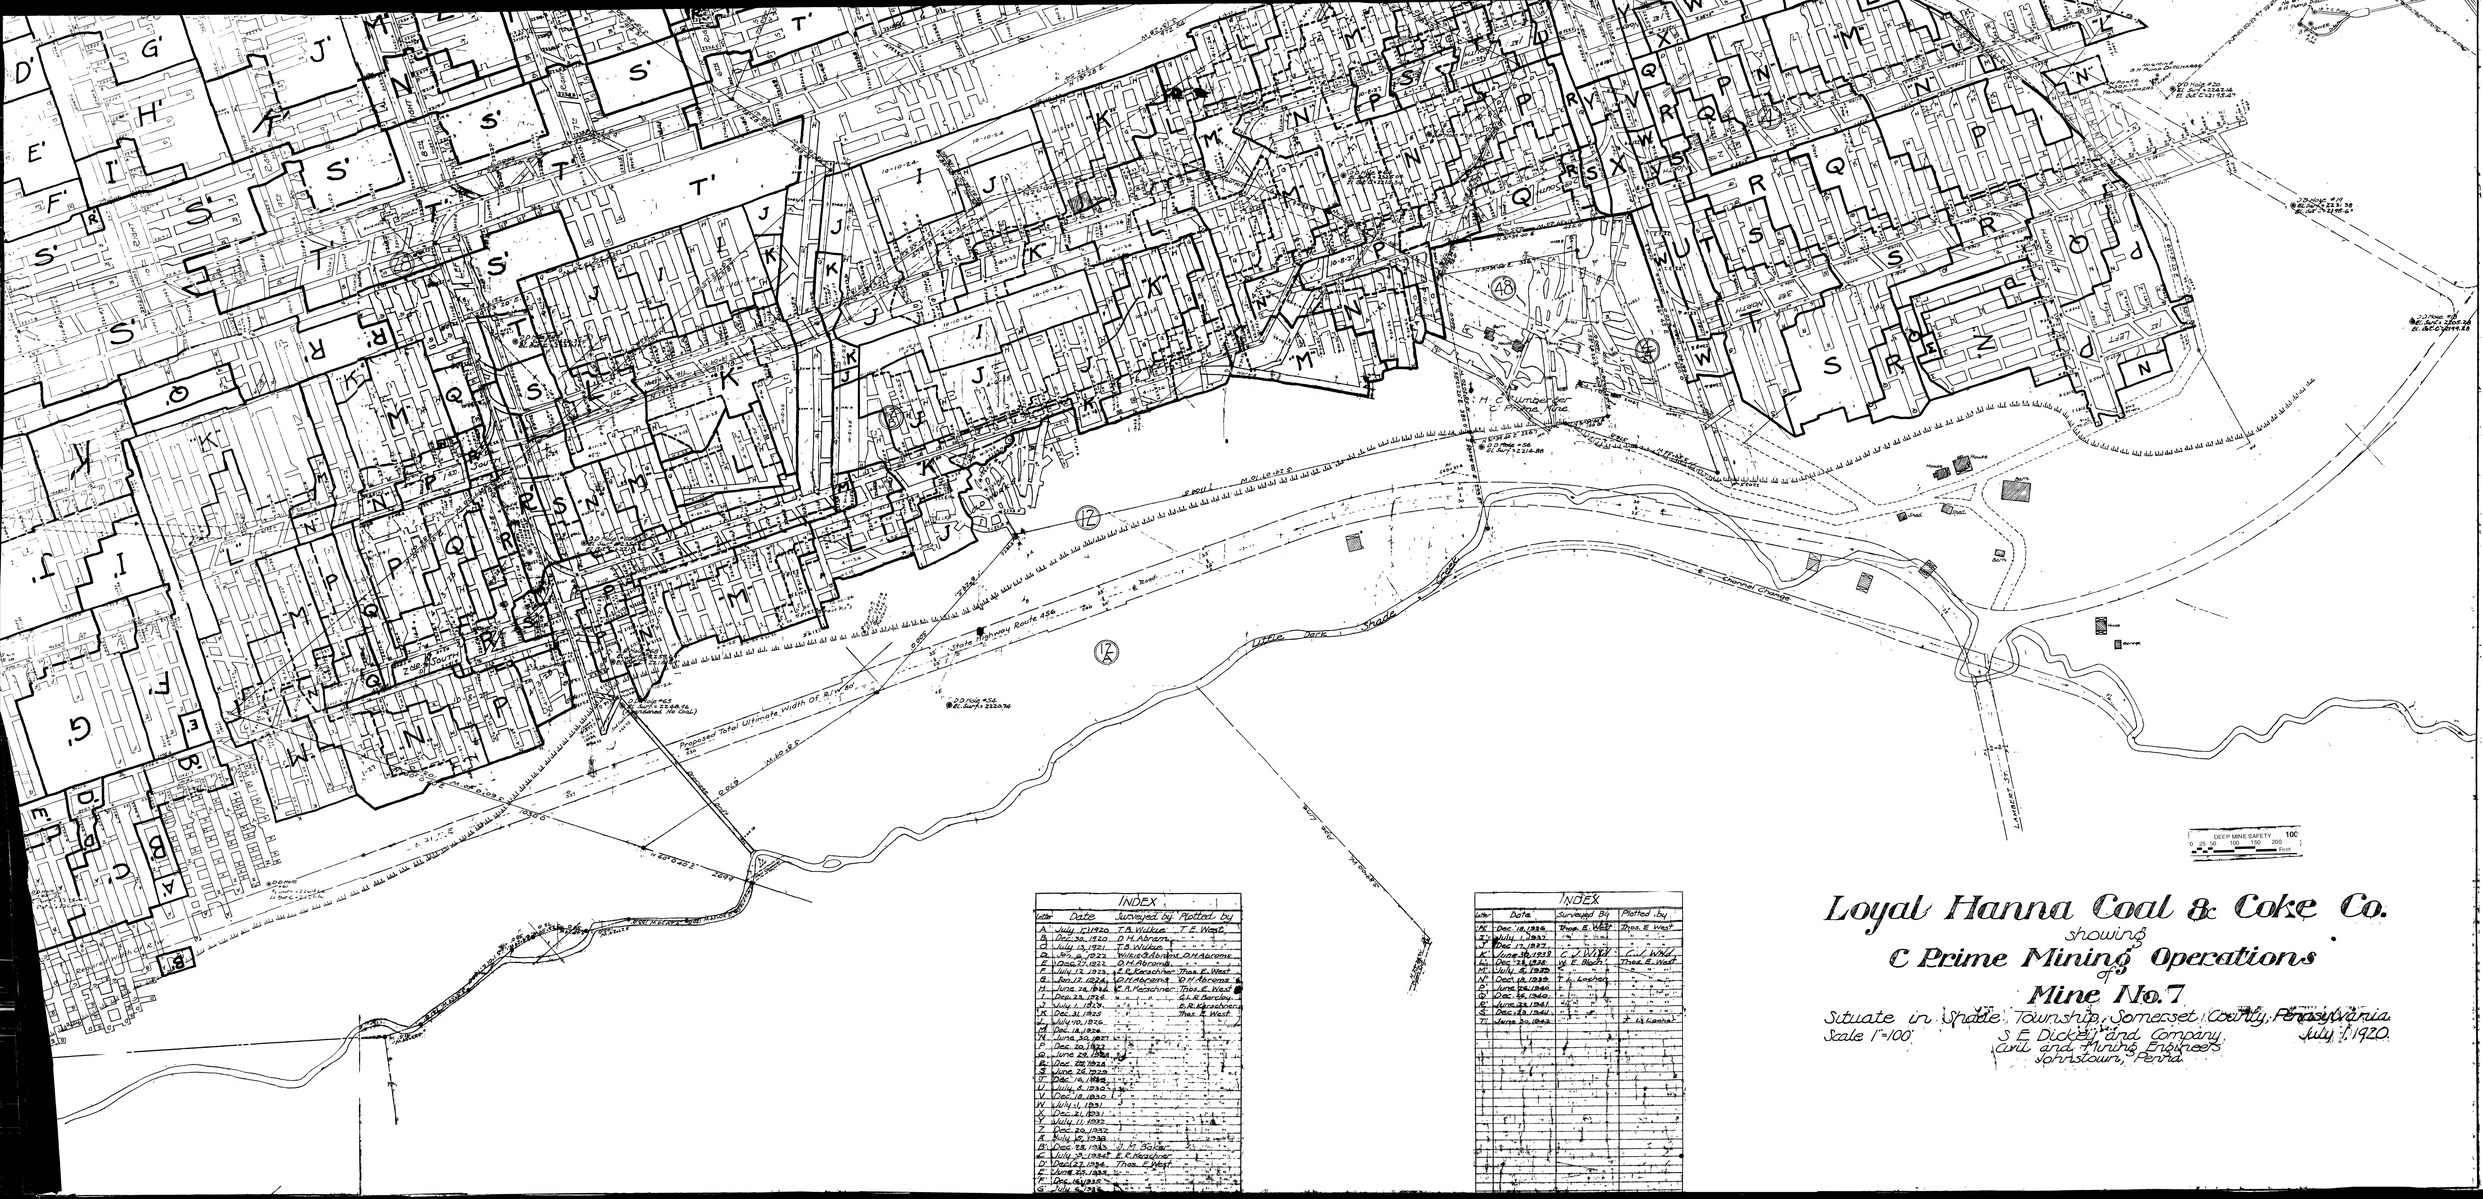


| INDEX | | | |
|---|---|---|---|
| Letter | Date | Surveyed by | Plotted by |
| A | July 1, 1920 | T.A. Wilkes | T.E. West |
| B | Dec. 30, 1920 | O.H. Abrams | " " |
| C | July 13, 1921 | T.A. Wilkes | " " |
| D | Jan. 6, 1922 | Wilkes & Abrams | O.H. Abrams |
| E | March 27, 1923 | O.H. Abrams | " " |
| F | July 12, 1923 | E.R. Kerschner | Thos. E. West |
| G | Jan. 12, 1924 | O.H. Abrams | O.H. Abrams |
| H | June 28, 1924 | E.R. Kerschner | Thos. E. West |
| I | Dec. 22, 1924 | " " | G.L.R. Barclay |
| J | July 1, 1925 | " " | E.R. Kerschner |
| K | Dec. 31, 1925 | " " | Thos. E. West |
| L | July 10, 1926 | " " | " " |
| M | Dec. 18, 1926 | " " | " " |
| N | June 30, 1927 | " " | " " |
| O | Dec. 30, 1927 | " " | " " |
| P | June 29, 1928 | " " | " " |
| Q | Dec. 28, 1928 | " " | " " |
| R | June 26, 1929 | " " | " " |
| S | Dec. 16, 1929 | " " | " " |
| T | July 8, 1930 | " " | " " |
| U | Dec. 19, 1930 | " " | " " |
| V | July 1, 1931 | " " | " " |
| W | Dec. 21, 1931 | " " | " " |
| X | July 11, 1932 | " " | " " |
| Y | Dec. 20, 1932 | " " | " " |
| Z | July 10, 1933 | " " | " " |
| A1 | Dec. 15, 1933 | W. H. Bailey | " " |
| B1 | July 9, 1934 | E.R. Kerschner | " " |
| C1 | Dec. 27, 1934 | Thos. E. West | " " |
| D1 | June 29, 1935 | " " | " " |
| E1 | Dec. 16, 1935 | " " | " " |
| F1 | July 6, 1936 | " " | " " |

| INDEX | | | |
|---|---|---|---|
| Letter | Date | Surveyed By | Plotted by |
| H1 | Dec. 18, 1936 | Thos. E. West | Thos. E. West |
| I1 | July 1, 1937 | " " | " " |
| J1 | Dec. 17, 1937 | " " | " " |
| K1 | June 30, 1938 | C.V. Wall | C.V. Wall |
| L1 | Dec. 28, 1938 | W. E. Rush | Thos. E. West |
| M1 | July 6, 1939 | " " | " " |
| N1 | Dec. 18, 1939 | T.J. Lindsay | " " |
| O1 | June 26, 1940 | " " | " " |
| P1 | Dec. 26, 1940 | " " | " " |
| Q1 | June 23, 1941 | " " | " " |
| R1 | Dec. 23, 1941 | " " | " " |
| S1 | March 20, 1942 | " " | " " (3 sheets) |

# Loyal Hanna Coal & Coke Co.

showing

## C Prime Mining Operations

of

## Mine No. 7

Situate in Shade Township, Somerset County, Pennsylvania

Scale 1"=100'

S.E. Dickey and Company
Civil and Mining Engineers
Johnstown, Penna.

July 1, 1920.