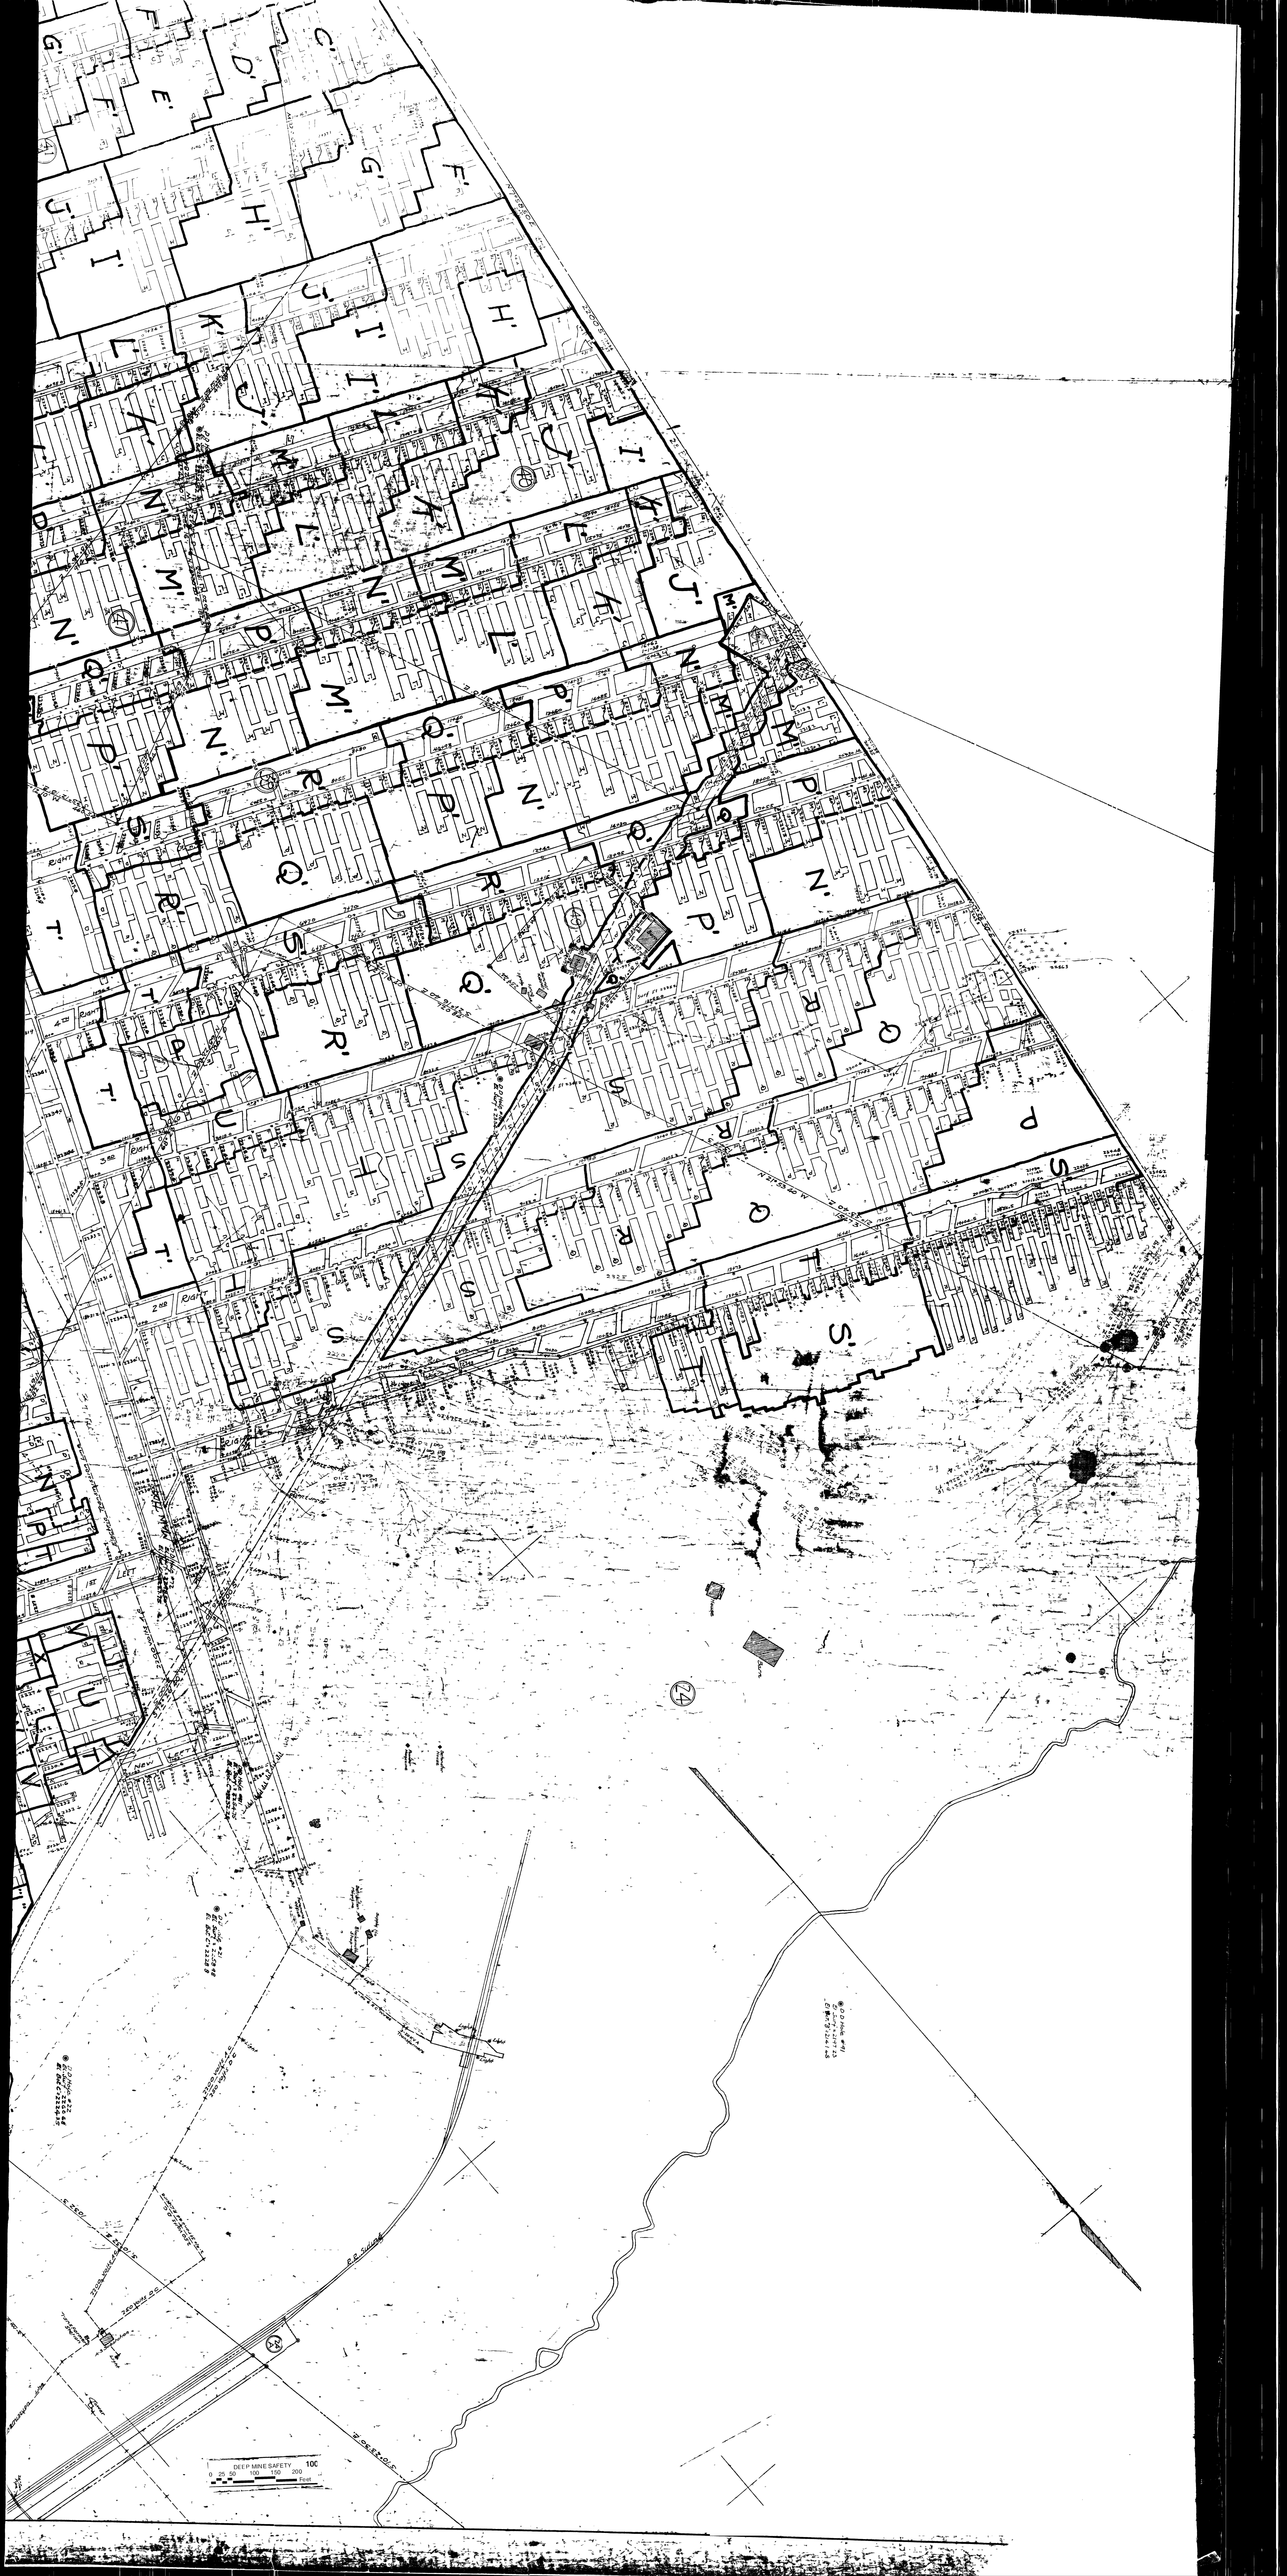
DEEP MINE SAFETY
0 25 50 100 150 200
Feet