


INDEX FOR 100' MAPS

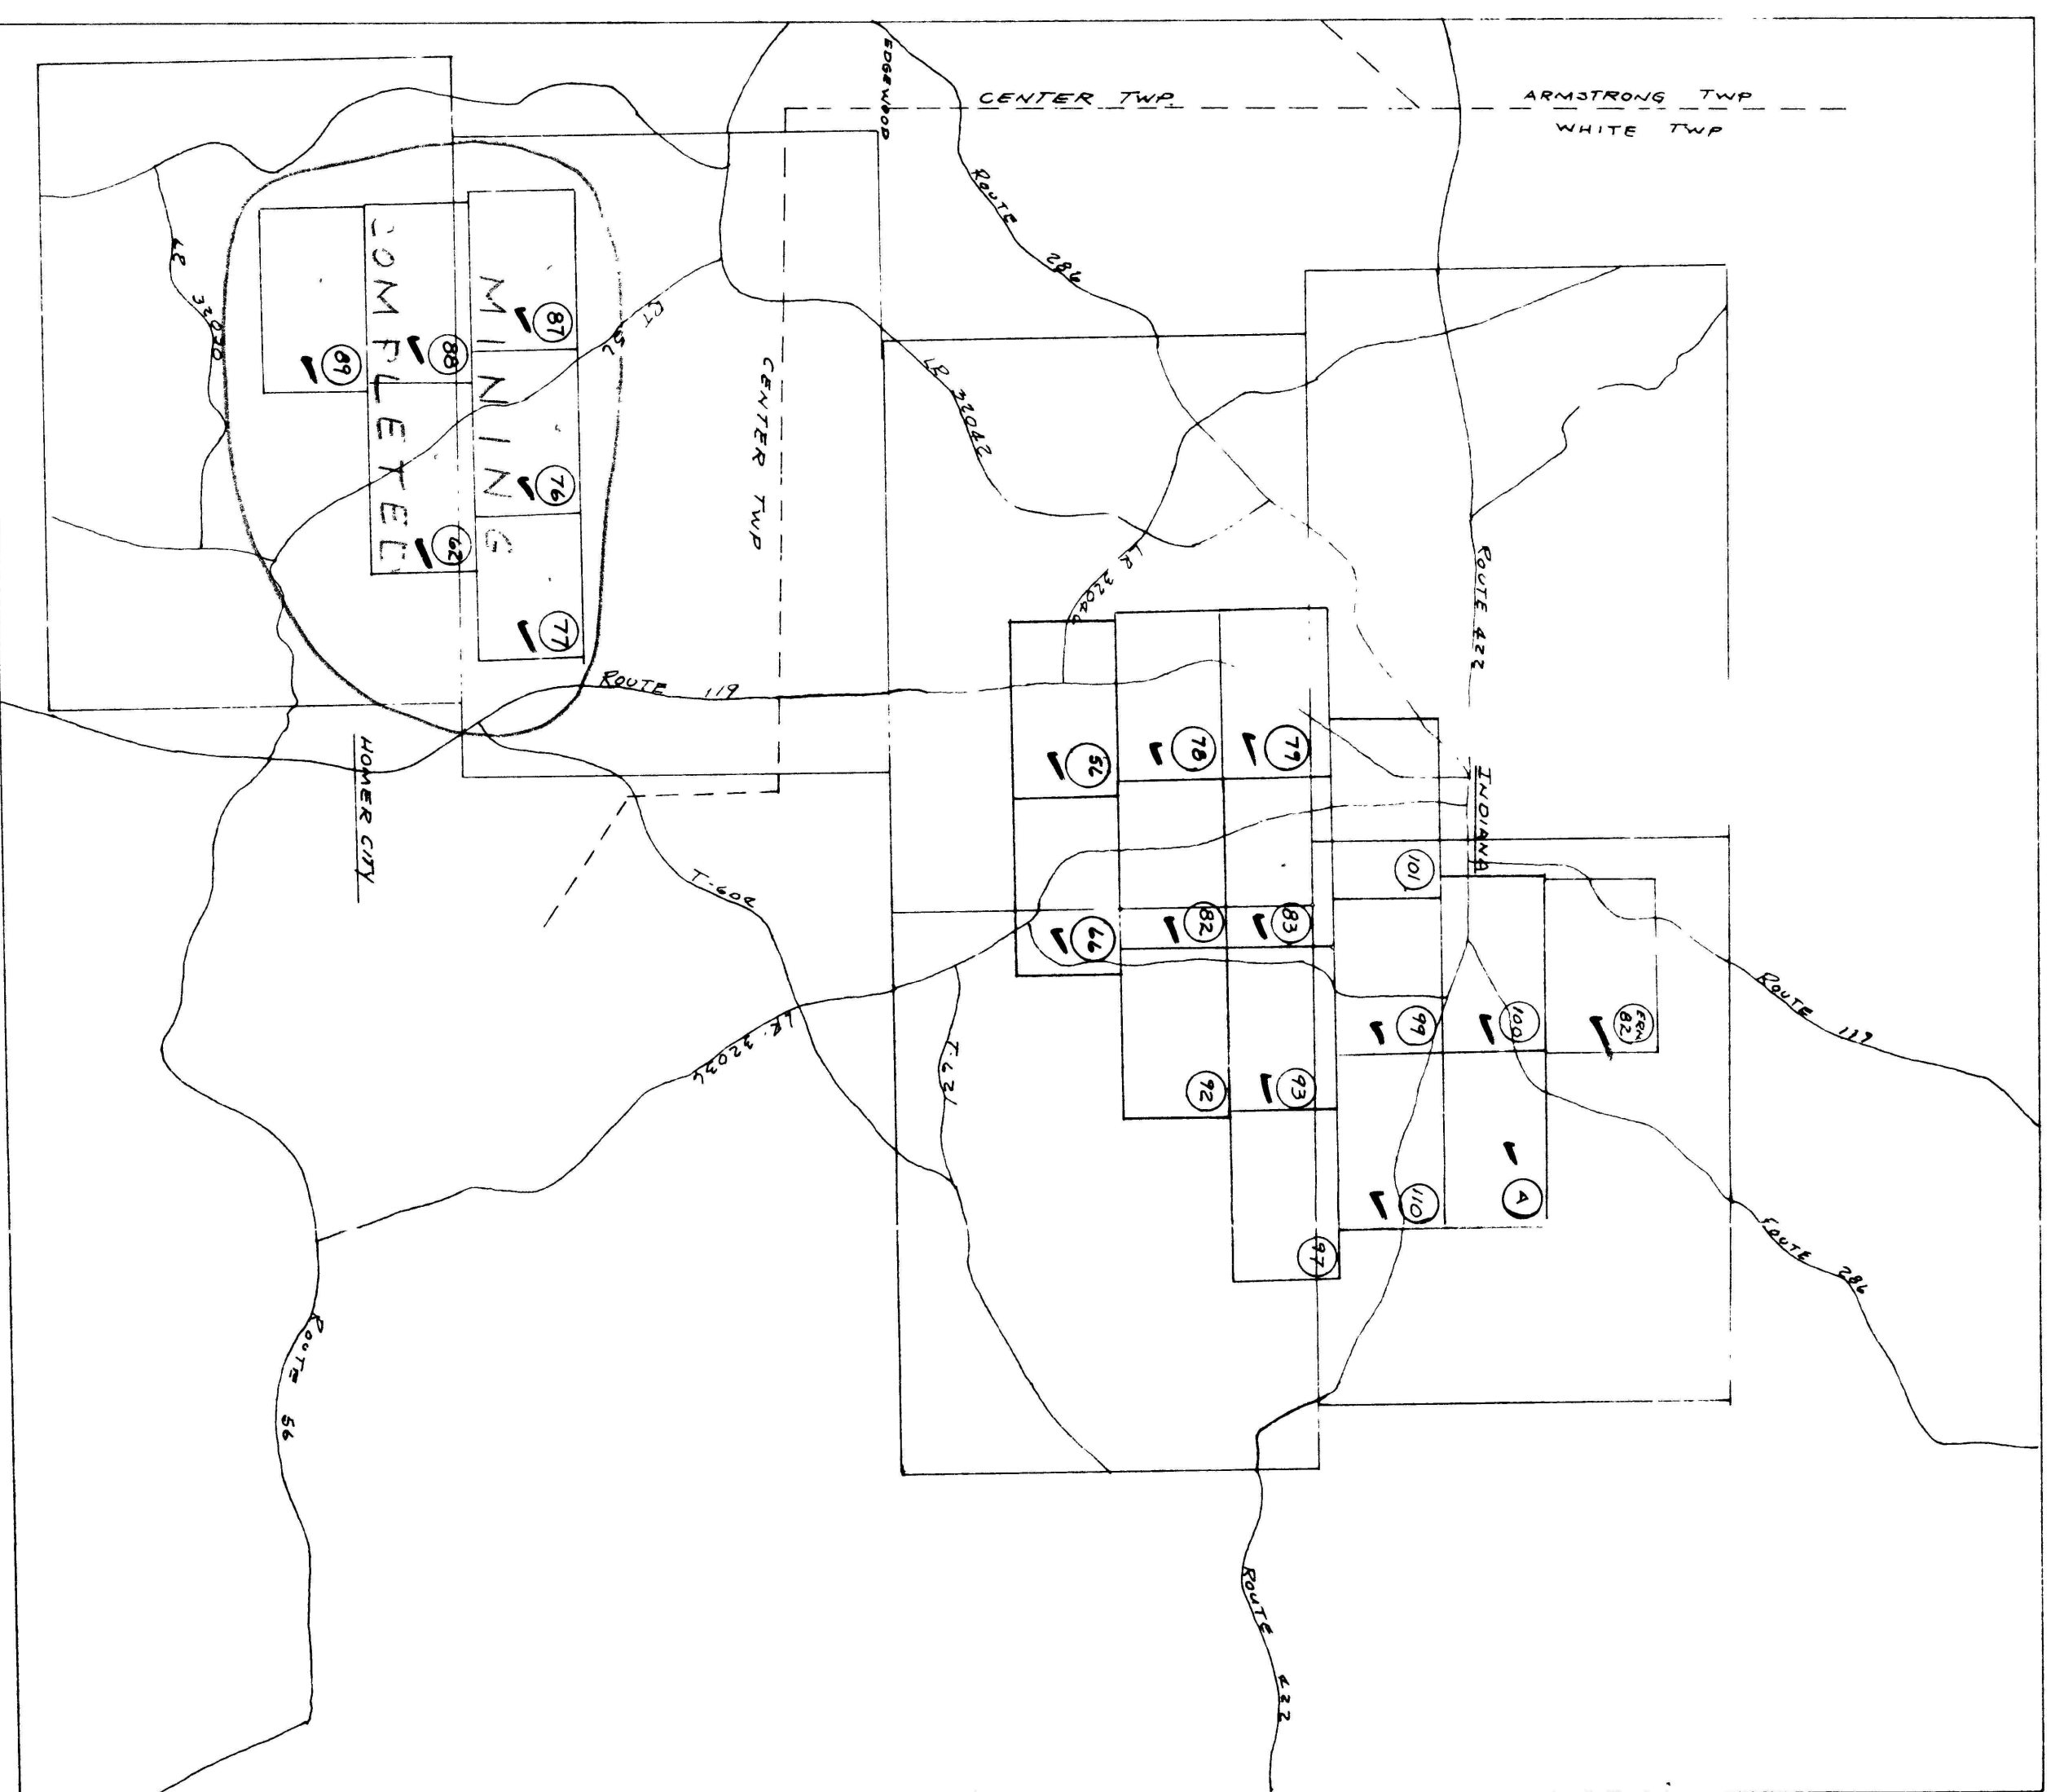

SCALE 1" = 4000'

LUCERNE MINE
100' MAPS

ROCHESTER & PITTSBURGH COAL COMPANY
INDIANA U.S.G.S. QUADRANGLE

LEGEND

SCALE 1" = 5208'

LUCERNEMINES, PA.
PROPERTY MAP


SCALE 1" = 5208'

SCALE 1" = 400'

DOTTED LINE SHOWS
OUTLINE OF PROTECTED AREA.

PROPOSED MINING PROJECTIONS.


DURING THE SIX MONTH PERIOD
MINING WILL BE PERFORMED
IN AREA OUTLINED IN RED.

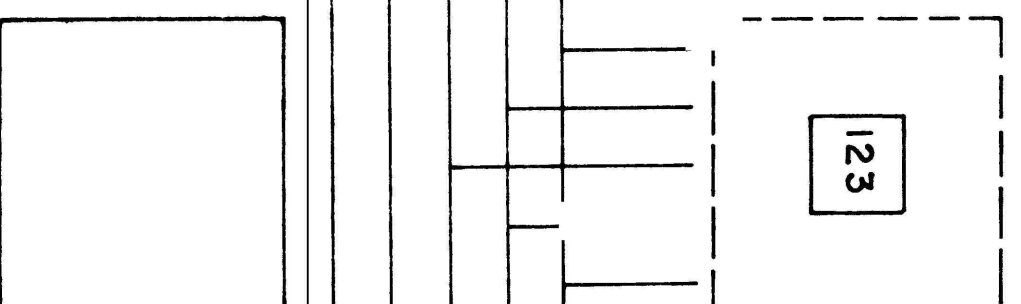

GREEN LINE SHOWS
AREA TO BE MINED.

SHEET NUMBER.

5

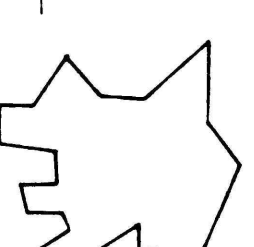

GREEN LINES SHOW
AREA TO BE MINED.

SHEET NUMBER.

5

SOLID BLACK LINES SHOW
OUTLINE OF EACH SHEET.

STRUCTURE AND NUMBER.

456

